


- 151 3" Elm 31' N.  
 171 Gas Meter 32' N.  
 181 8" Gas Isls 18' 5".  
 182 15" Elm 30' N.  
 108 End Gas Island 18' 5".
- 0.6862' N.E.O.S.
- 146 14" Elm 31' N.  
 153 Gas Meter 29' N.  
 158 3" Ho. Lnk. 30' N.  
 168 End Conn. Noren 50. @ bk. of blk. 541  
 0.78°
- 183 End Lnk. 31.9' 50.  
 184 1" W.L. Custer 50.  
 198 S.W.B. Pole 19' N.  
 111 6" Custer Man. 36.6' 50.  
 121 8" Elm 30' N.  
 133 11" Ho. Lnk. 26.5' 50.  
 135 5" Elm 27.5' 50.  
 136 8" W.L. Wire Poles 50' 50.  
 137 1" W.L. Custer 50.  
 143 10" Elm 30' N.
- 154 K.G.E. Pole 50.  
 158 3" Ho. Lnk. 30.6' N.  
 163 Gas Meter 20.6' N.
- 187 5" Elm 28.5' N.  
 189 Gas Meter 29' 50.  
 197 8" Elm 28' N.  
 107 8" Elm 28' N.  
 121 S.W.B. Pole 18' N.
- 0.3582' N.E.O.S.
- 136 End Pole. 26.5' 50.  
 140 8" Ho. Lnk. 18' 50.  
 159 End Curb. 50.  
 167 K.G.E. Pole 31' 50.  
 180 Gas Meter 32' N.  
 184 10" Elm 27' 50.

FILL		ASPHALT REMOVAL		C & G A.V.	
PROP.	CITY	PROP.	CITY	PROP.	CITY
2.05 CUB.	13.7 CUB.	5.74 SQ. Y.	22.7 SQ. Y.	67.57 CUB.	101.7 CUB.
6.5 CUB.	6.5 CUB.	5.2 CUB.	0.4 CUB.	185.1 CUB.	185.1 CUB.

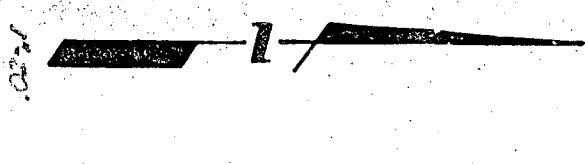

1. GENERAL:  
 2.7550 = 4.1 CITY  
 1.5450 = 1.1 A PROP.  
 27

2. GENERAL:  
 5.11 = 0.7 PROP.  
 5.11 = 0.7 CITY  
 27