Drainage Plan

RIVERSIDE FOURTH Addition

May, 1980
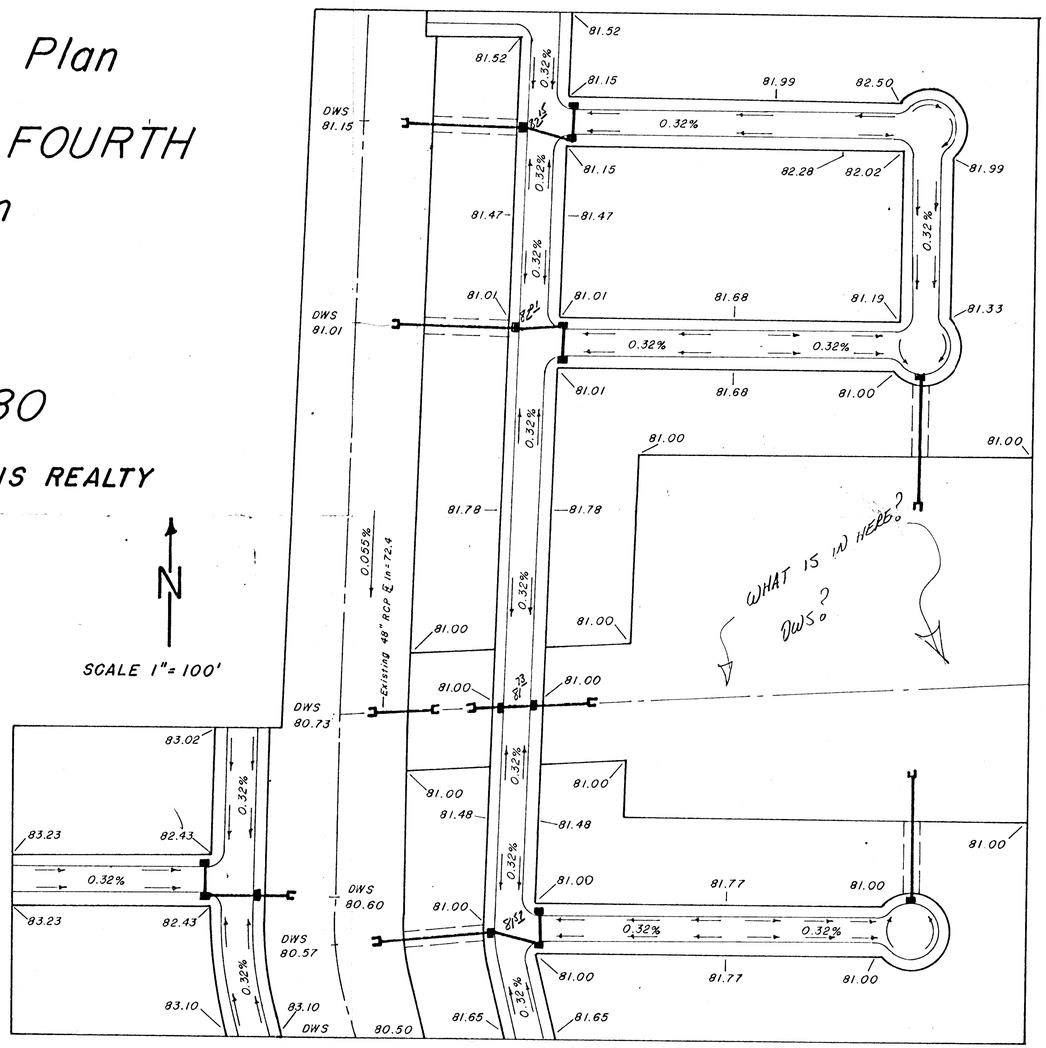
OWNER - ROBBINS REALTY