


N.E. 1/4 SEC. 3, TWP. 27, R. 1 E.

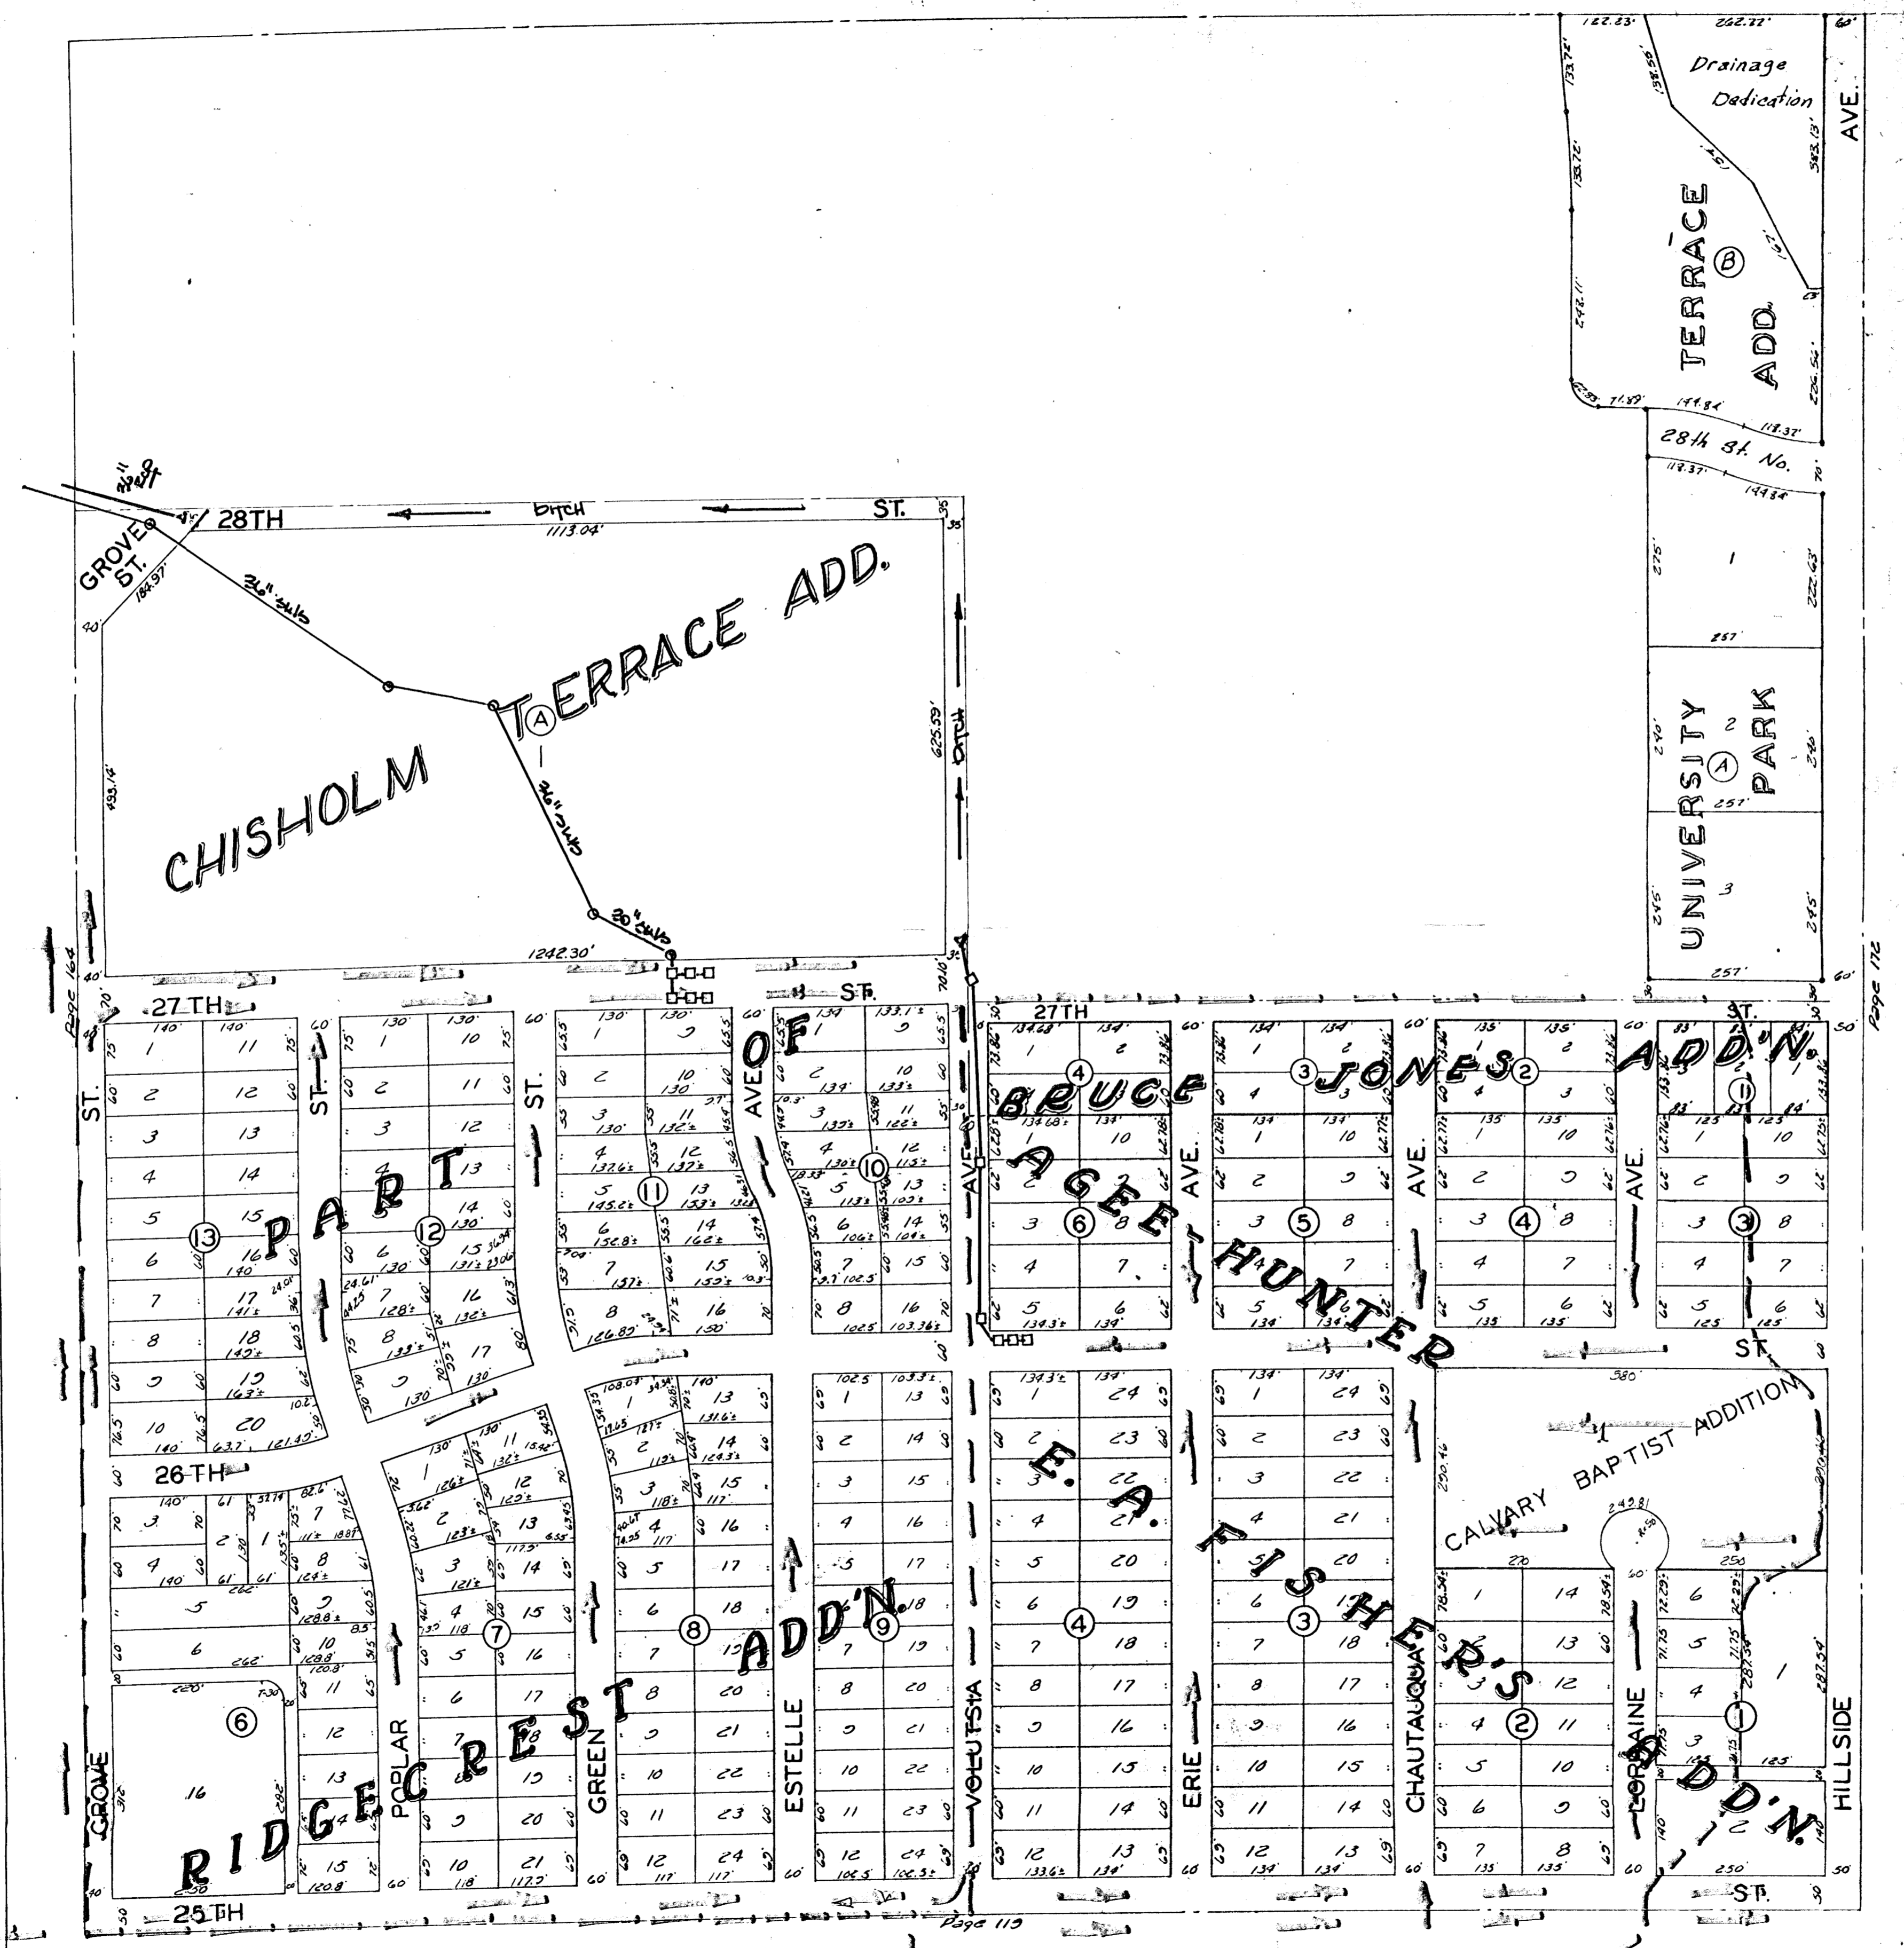

Page 172

Page 119