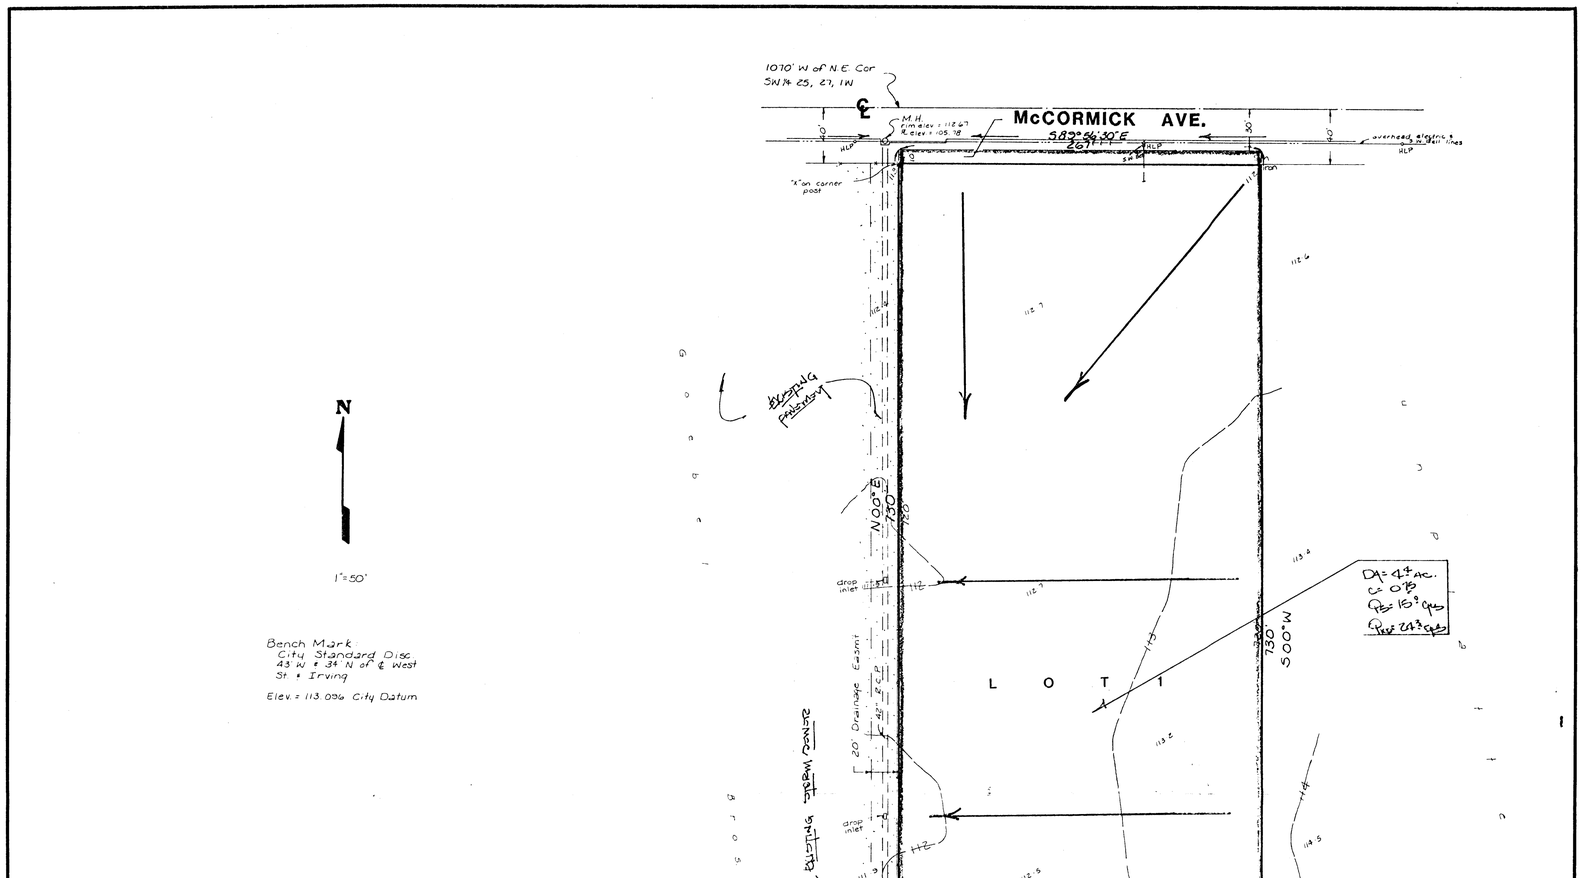
1010' W of N.E. Cor
SW¼ 25, 27, 1N
McCORMICK AVE.
M.H.
rim elev = 112.67
R elev = 105.78
overhead elevtric & tel lines
HLP
"x" on corner post
existing parkway
N00°E
730'
drop inlet
20' Drainage Easmt
existing sewer
L O T 1
730'
S00°W
N
1"=50'
Bench Mark
City Standard Disc
43' W & 34' N of ℄ West
St & Irving
Elev. = 113.096 City Datum