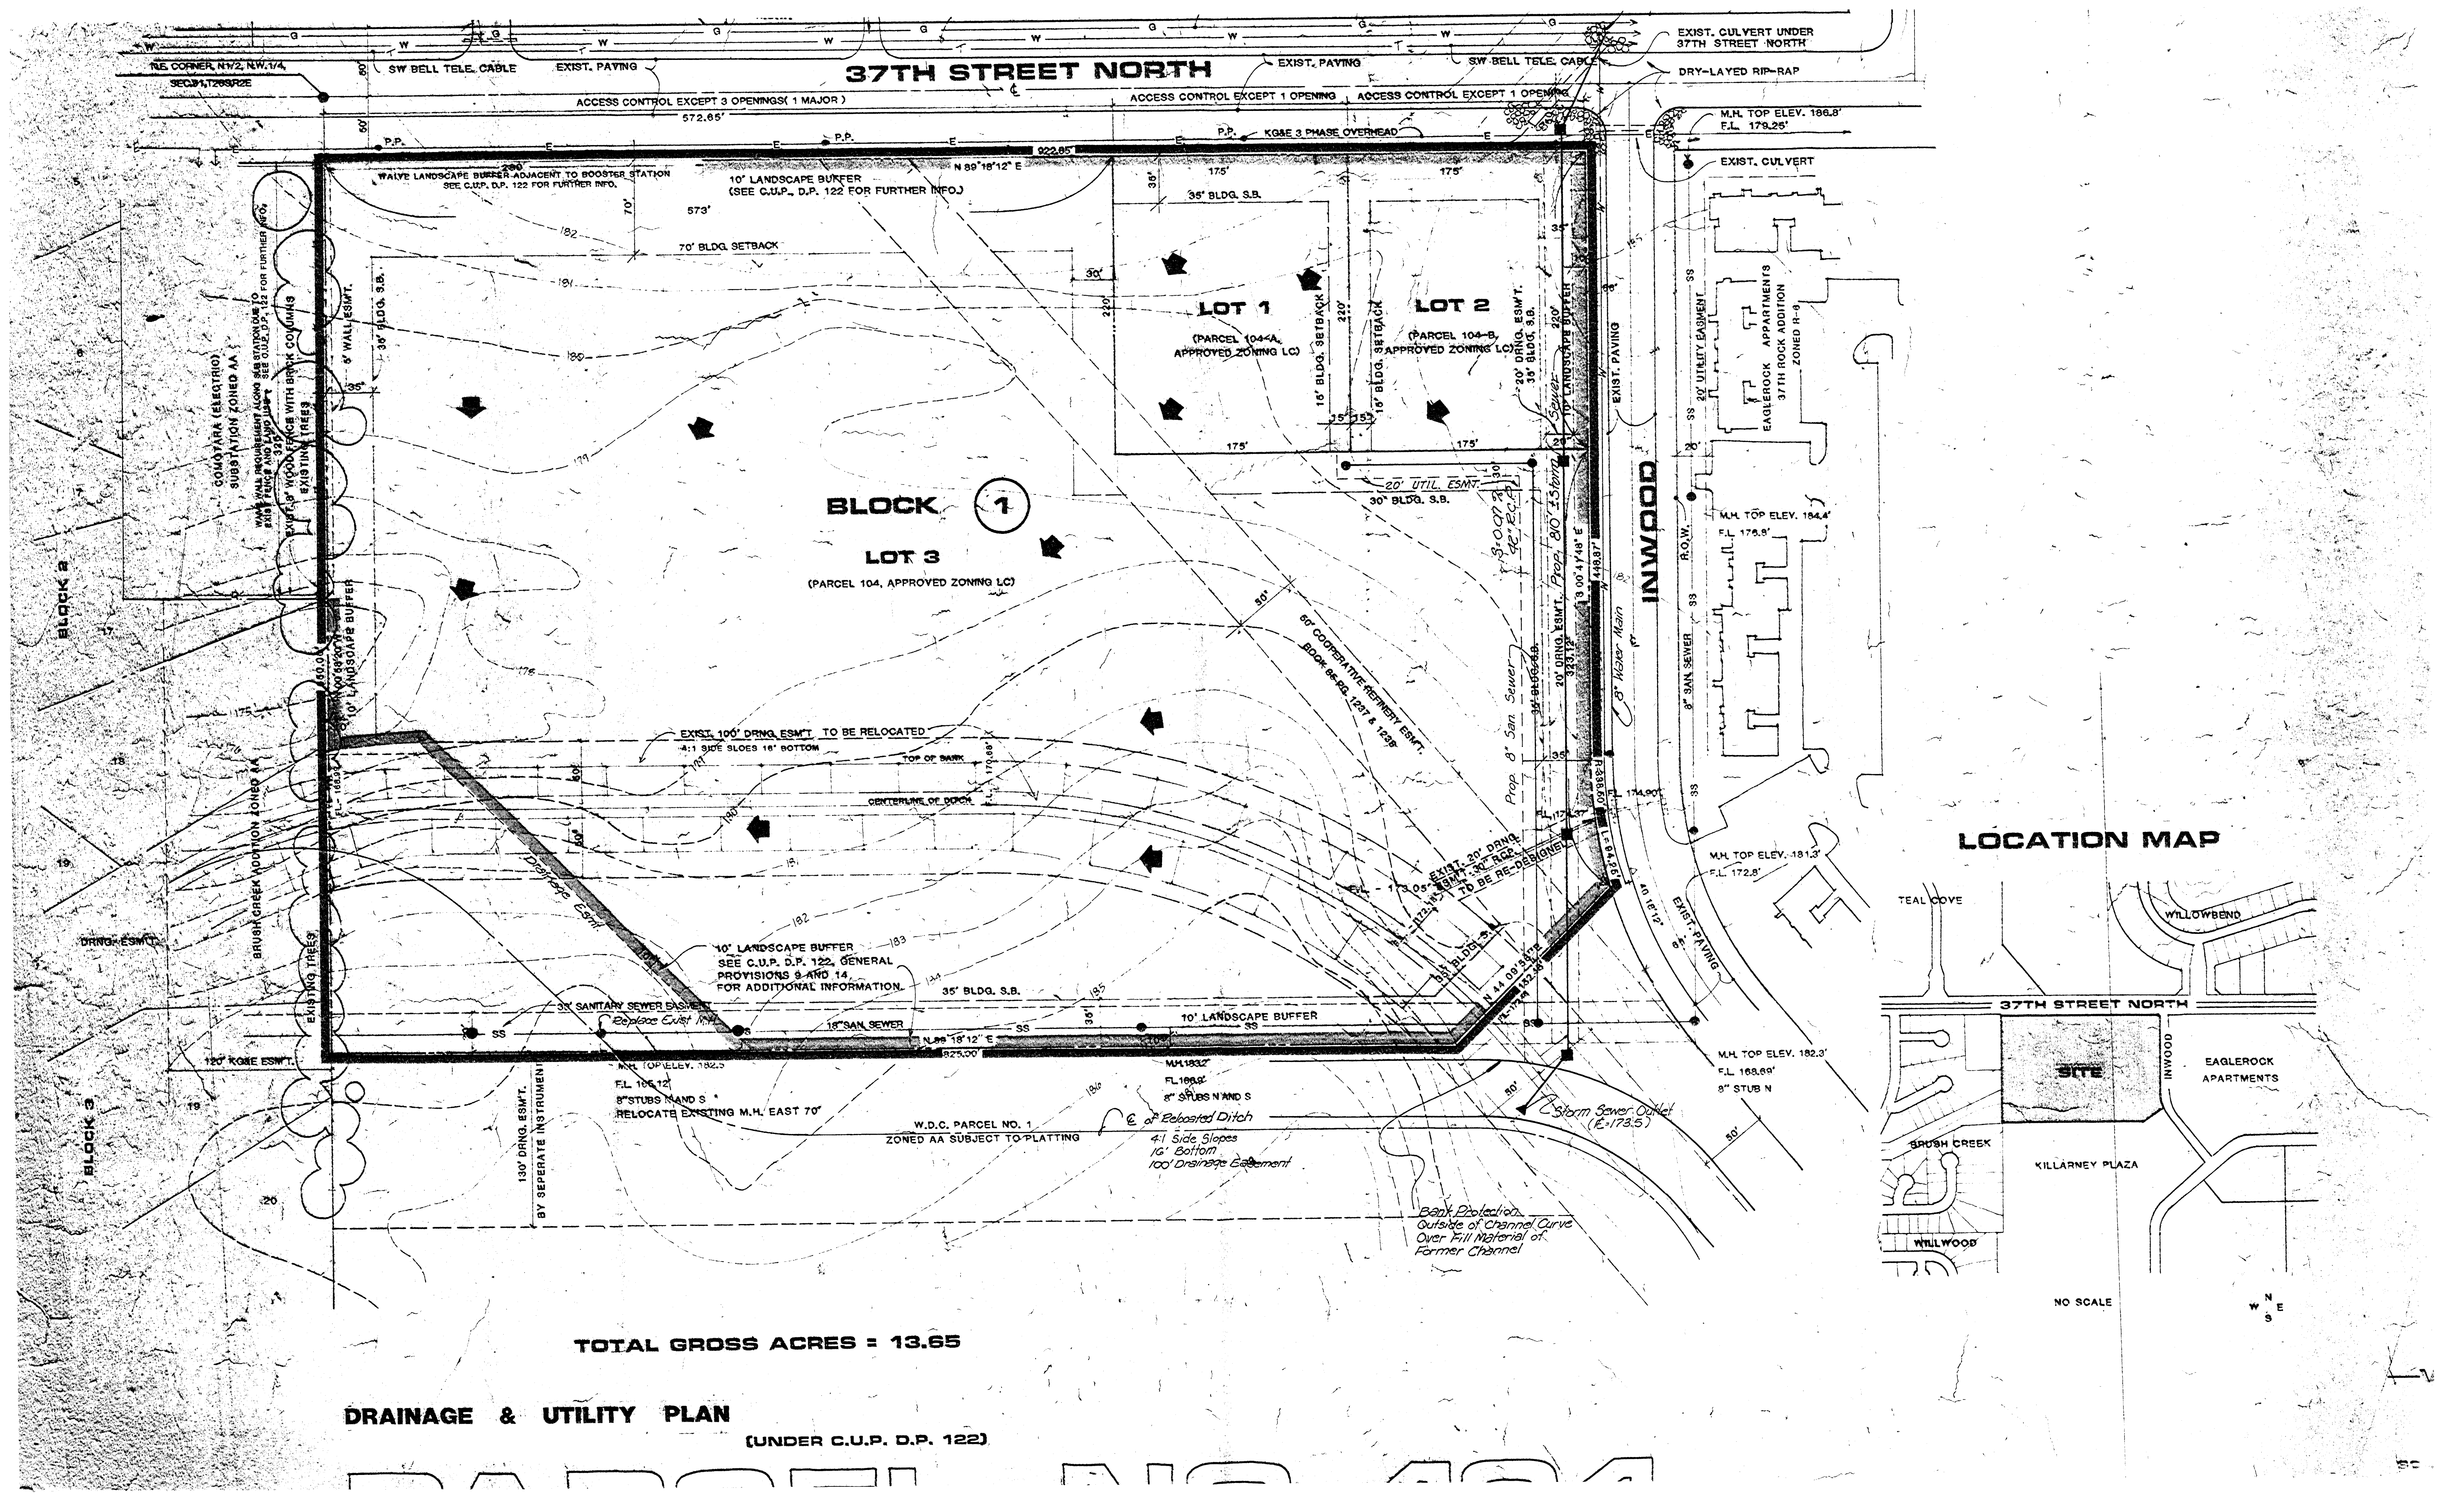

TOTAL GROSS ACRES = 13.65

DRAINAGE & UTILITY PLAN

(UNDER C.U.P. D.P. 122)