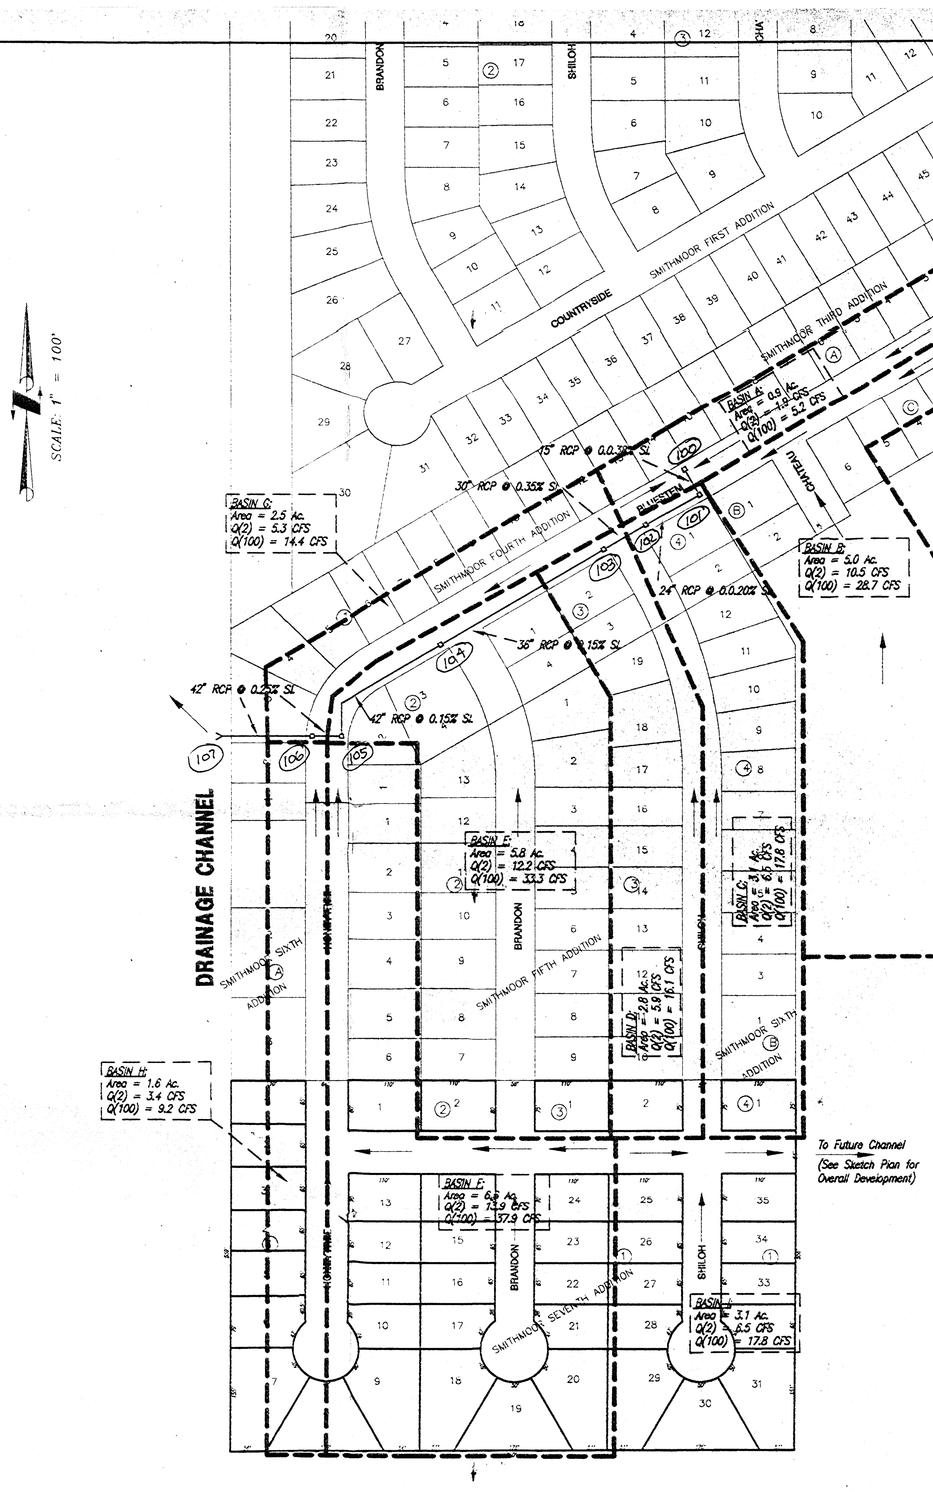

DRAINAGE PLAN
SMITHMOOR SIXTH ADDITION
AND SMITHMOOR SEVENTH ADDITION
WICHITA, SEDGWICK COUNTY, KANSAS

BABAR M. KHAN
LICENSED
9328
7/2/97
KANSAS
PROFESSIONAL ENGINEER

NOTES:

1. All storm sewers shown are existing.
2. Refer to preliminary plats for Smithmoor third, Fourth, Fifth, Sixth & Seventh Additions for topographic information.

MUNICIPAL ENGINEERS, P.A.
254-LAURA, SUITE 201
WICHITA, KANSAS 67211
316-262-3842