DSNR: SAD OPER: SAD SCALE: 1=30.00
Q:\2001\01135\dimensions 06-06-2001 11:29:10 am

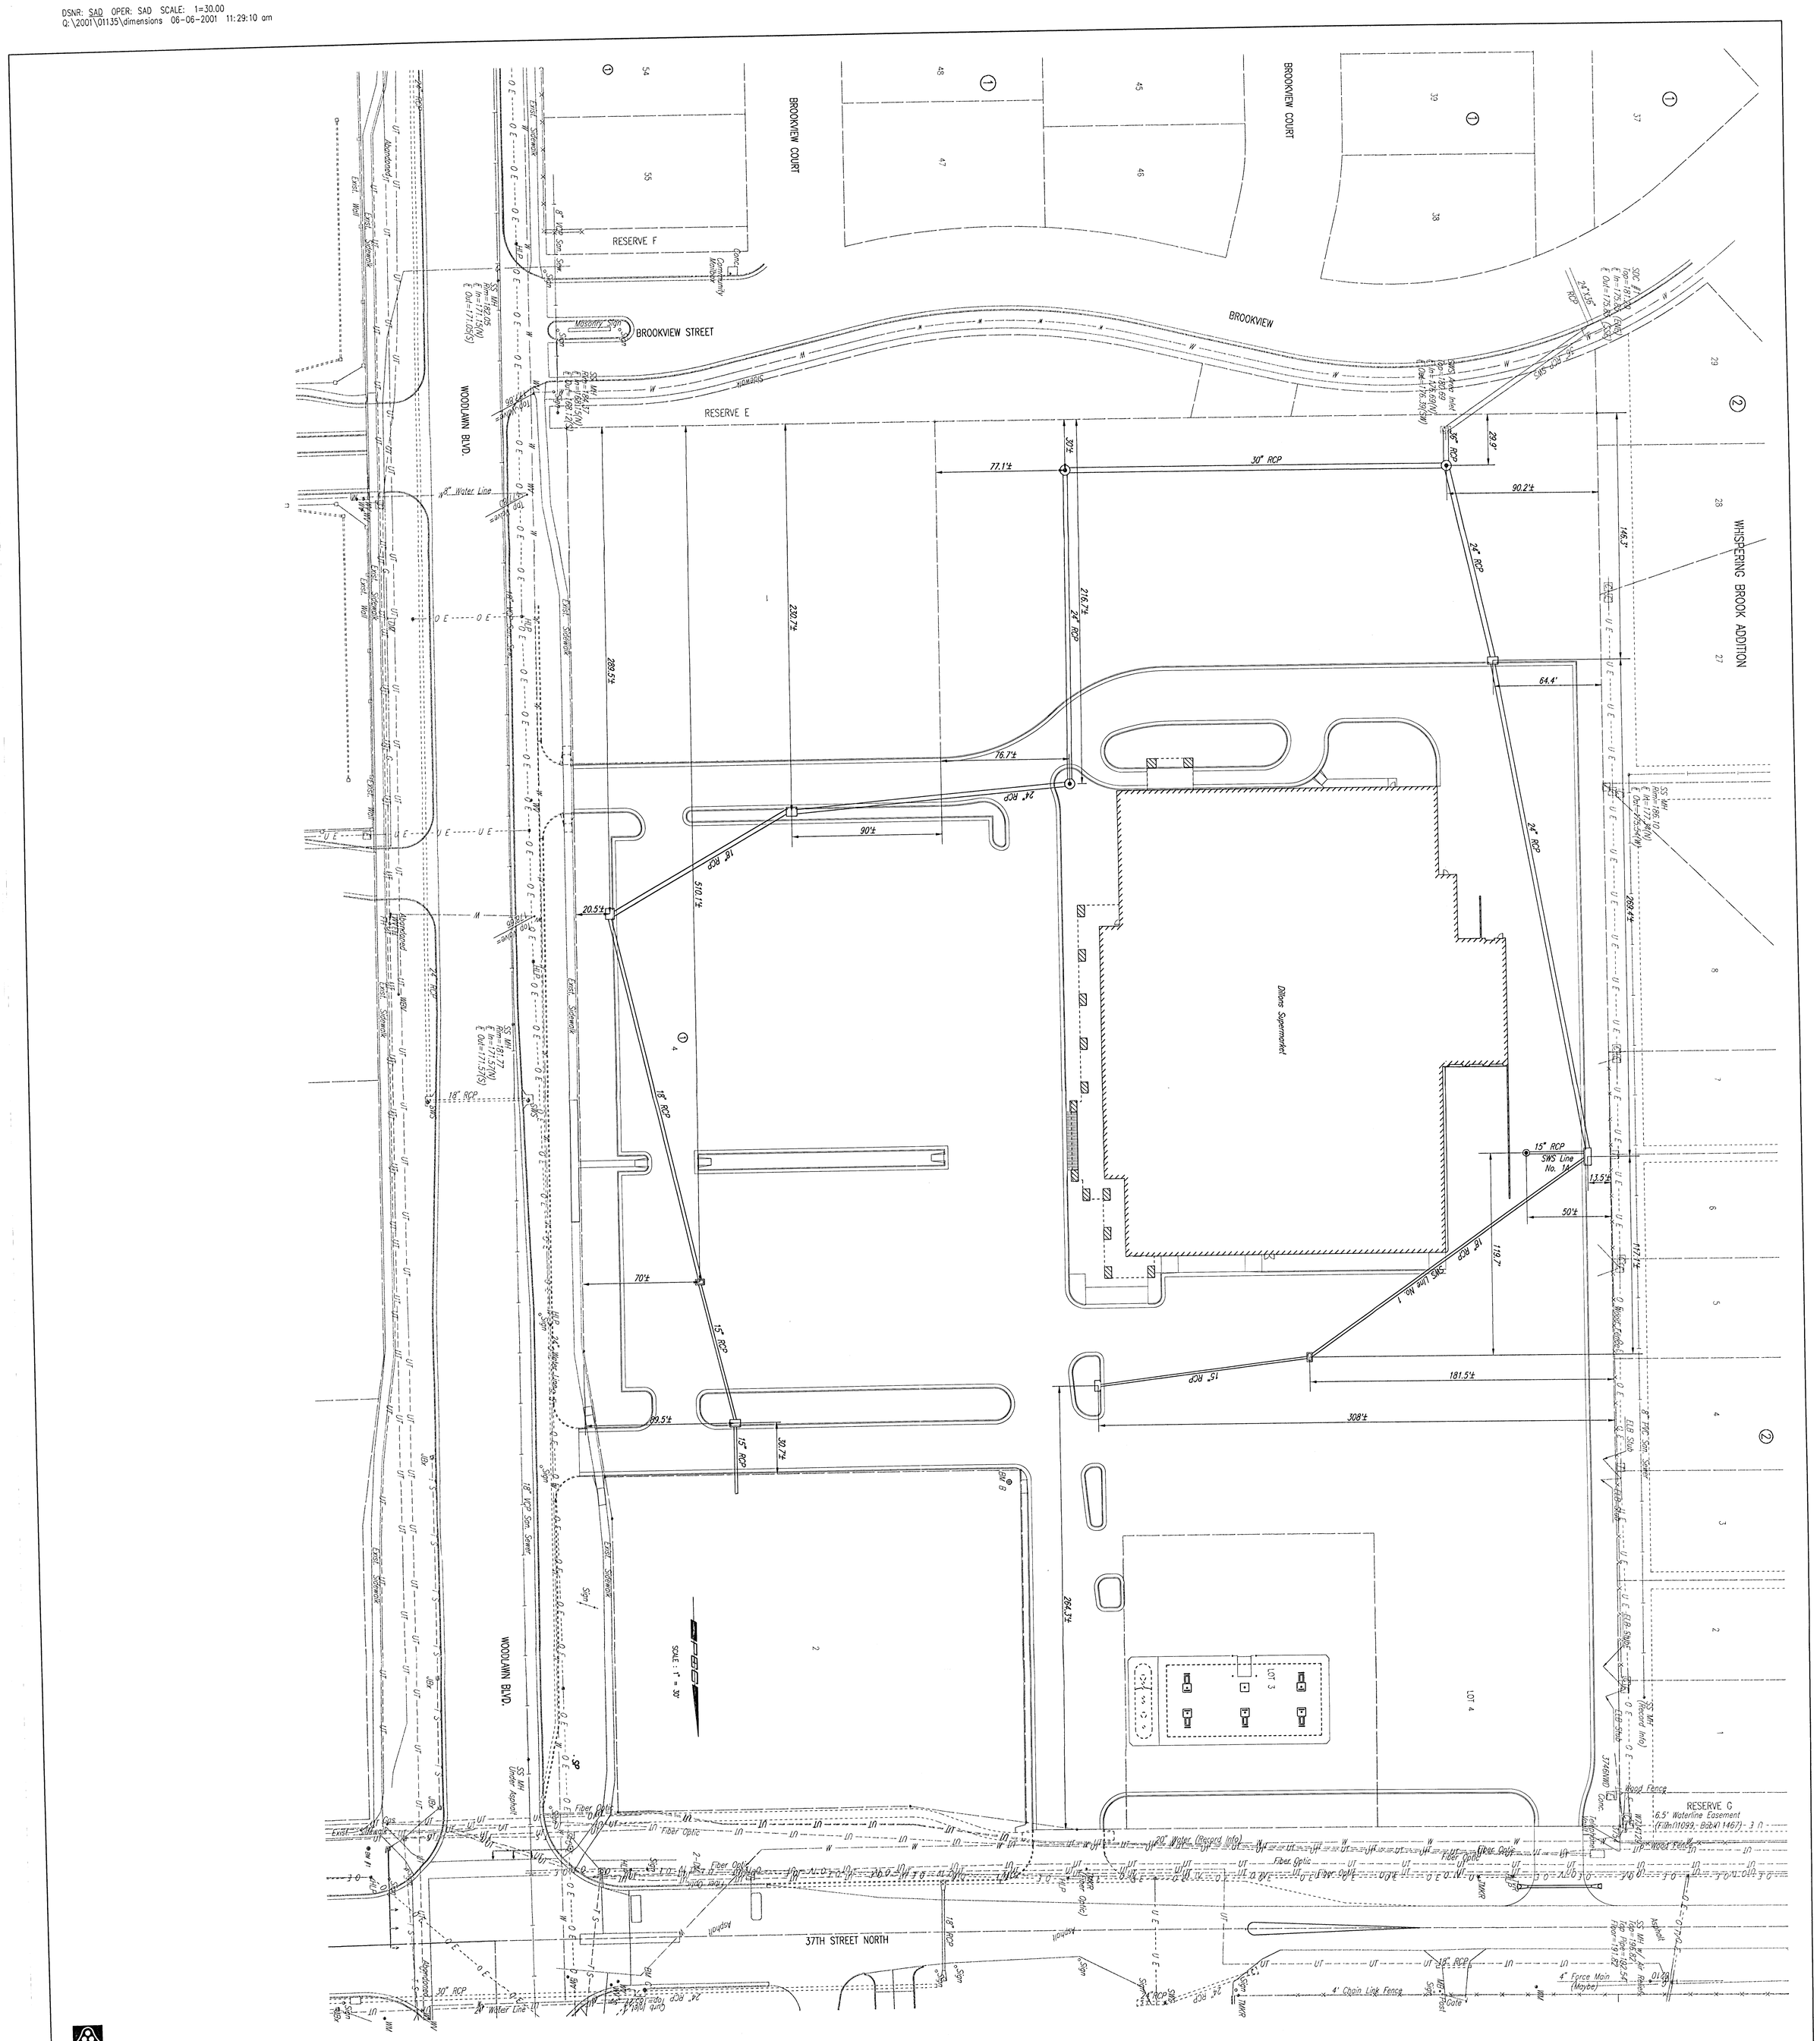

Professional Engineering Consultants, P.A.
1820 W. 6TH STREET • LAWRENCE, KANSAS 66044
785-842-6464 • FAX 785-842-4140

DRAWN	KER
CHECKED	
DATE	JUNE 2001
SCALE	1" = 30'
JOB NO.	01135
SHEET	
OF	
SHEETS	

A NEW BUILDING FOR:

DILLONS SUPERMARKET NO. 56

37TH & WOODLAWN

WICHITA KS.

Dillons STORES DIVISION
ARCHITECTURAL & ENGINEERING DEPARTMENT
2700 EAST FOURTH STREET
HUTCHINSON, KANSAS 67501 1-316-665-5511

ED ATKINSON -- A & E DEPARTMENT SUPERVISOR