
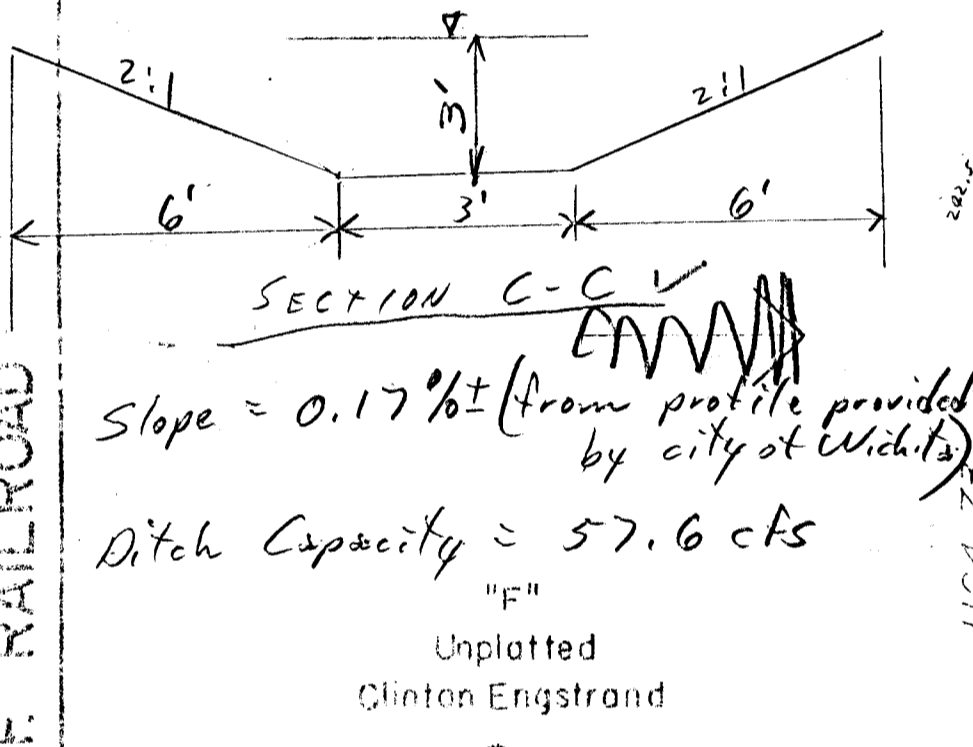



# BRIDGEPORT INDUSTRIAL PARK II

OWNER / DEVELOPER · URBAN RENEWAL AGENCY OF WICHITA, KANSAS **DRAINAGE PLAN**

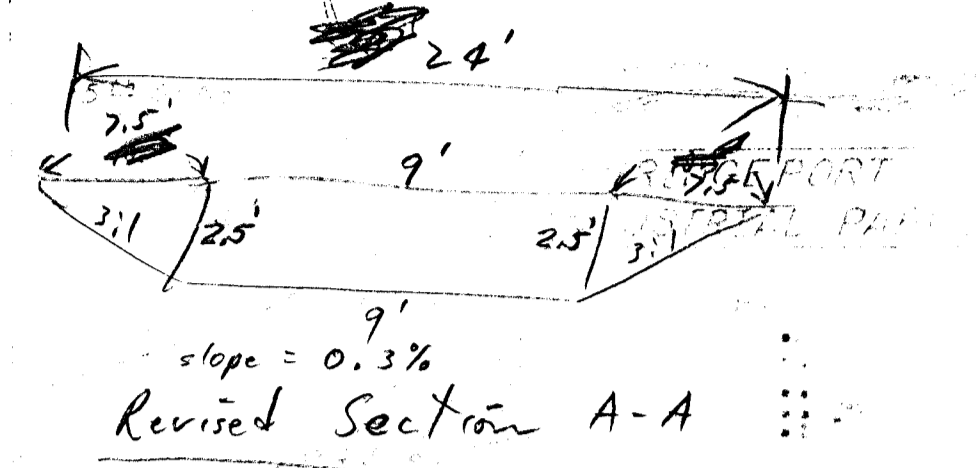

Right of Way of 37th St. North 4.5, 6, 8, 10,1000.

APPROVED:  
 M.S. MITCHELL Max Greene ASST. SUPT/PUB. WKS. MAINT. DATE: \_\_\_\_\_  
 R.W. LINN, P.E. CITY ENGINEER DATE: \_\_\_\_\_

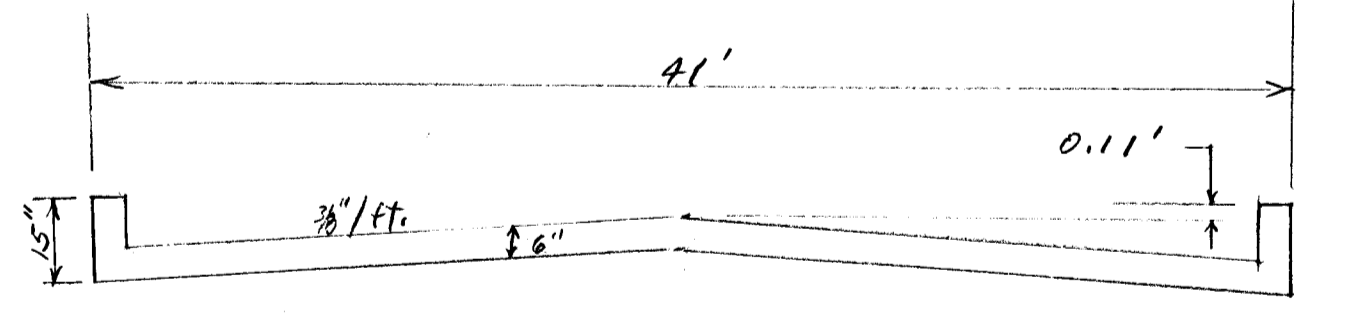

Legend:  
 ○ = 3" Iron Pipe  
 □ = R/W Monuments  
 △ = Thimble  
 27" 0.65% x 4' = 3.2' Eff.  
 260-E 601  
 BELAMATER, FREUND & ASSOC., P.A. ENGINEERS & ARCHITECTS WICHITA, KANSAS

Scale = 1" = 100'  
 February 10, 1973

RETURN TO DFA