

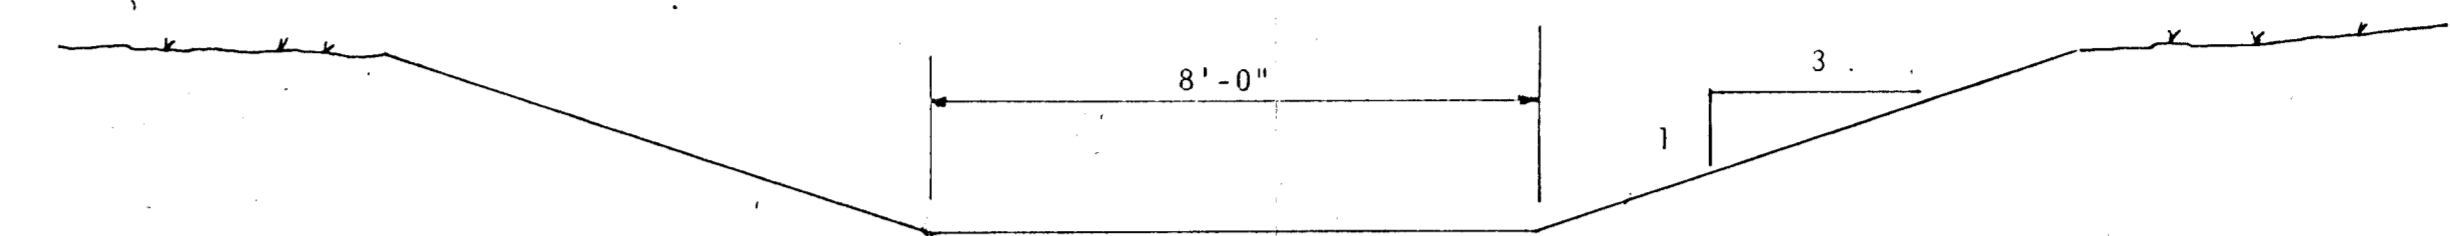


TYPICAL SECTION A-A

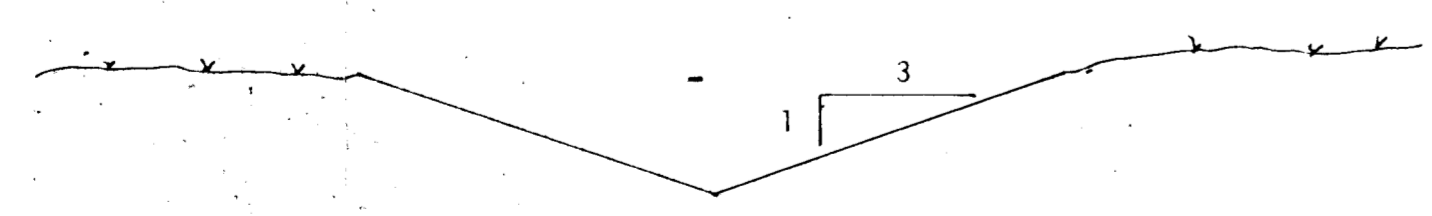


TYPICAL SECTION B-B

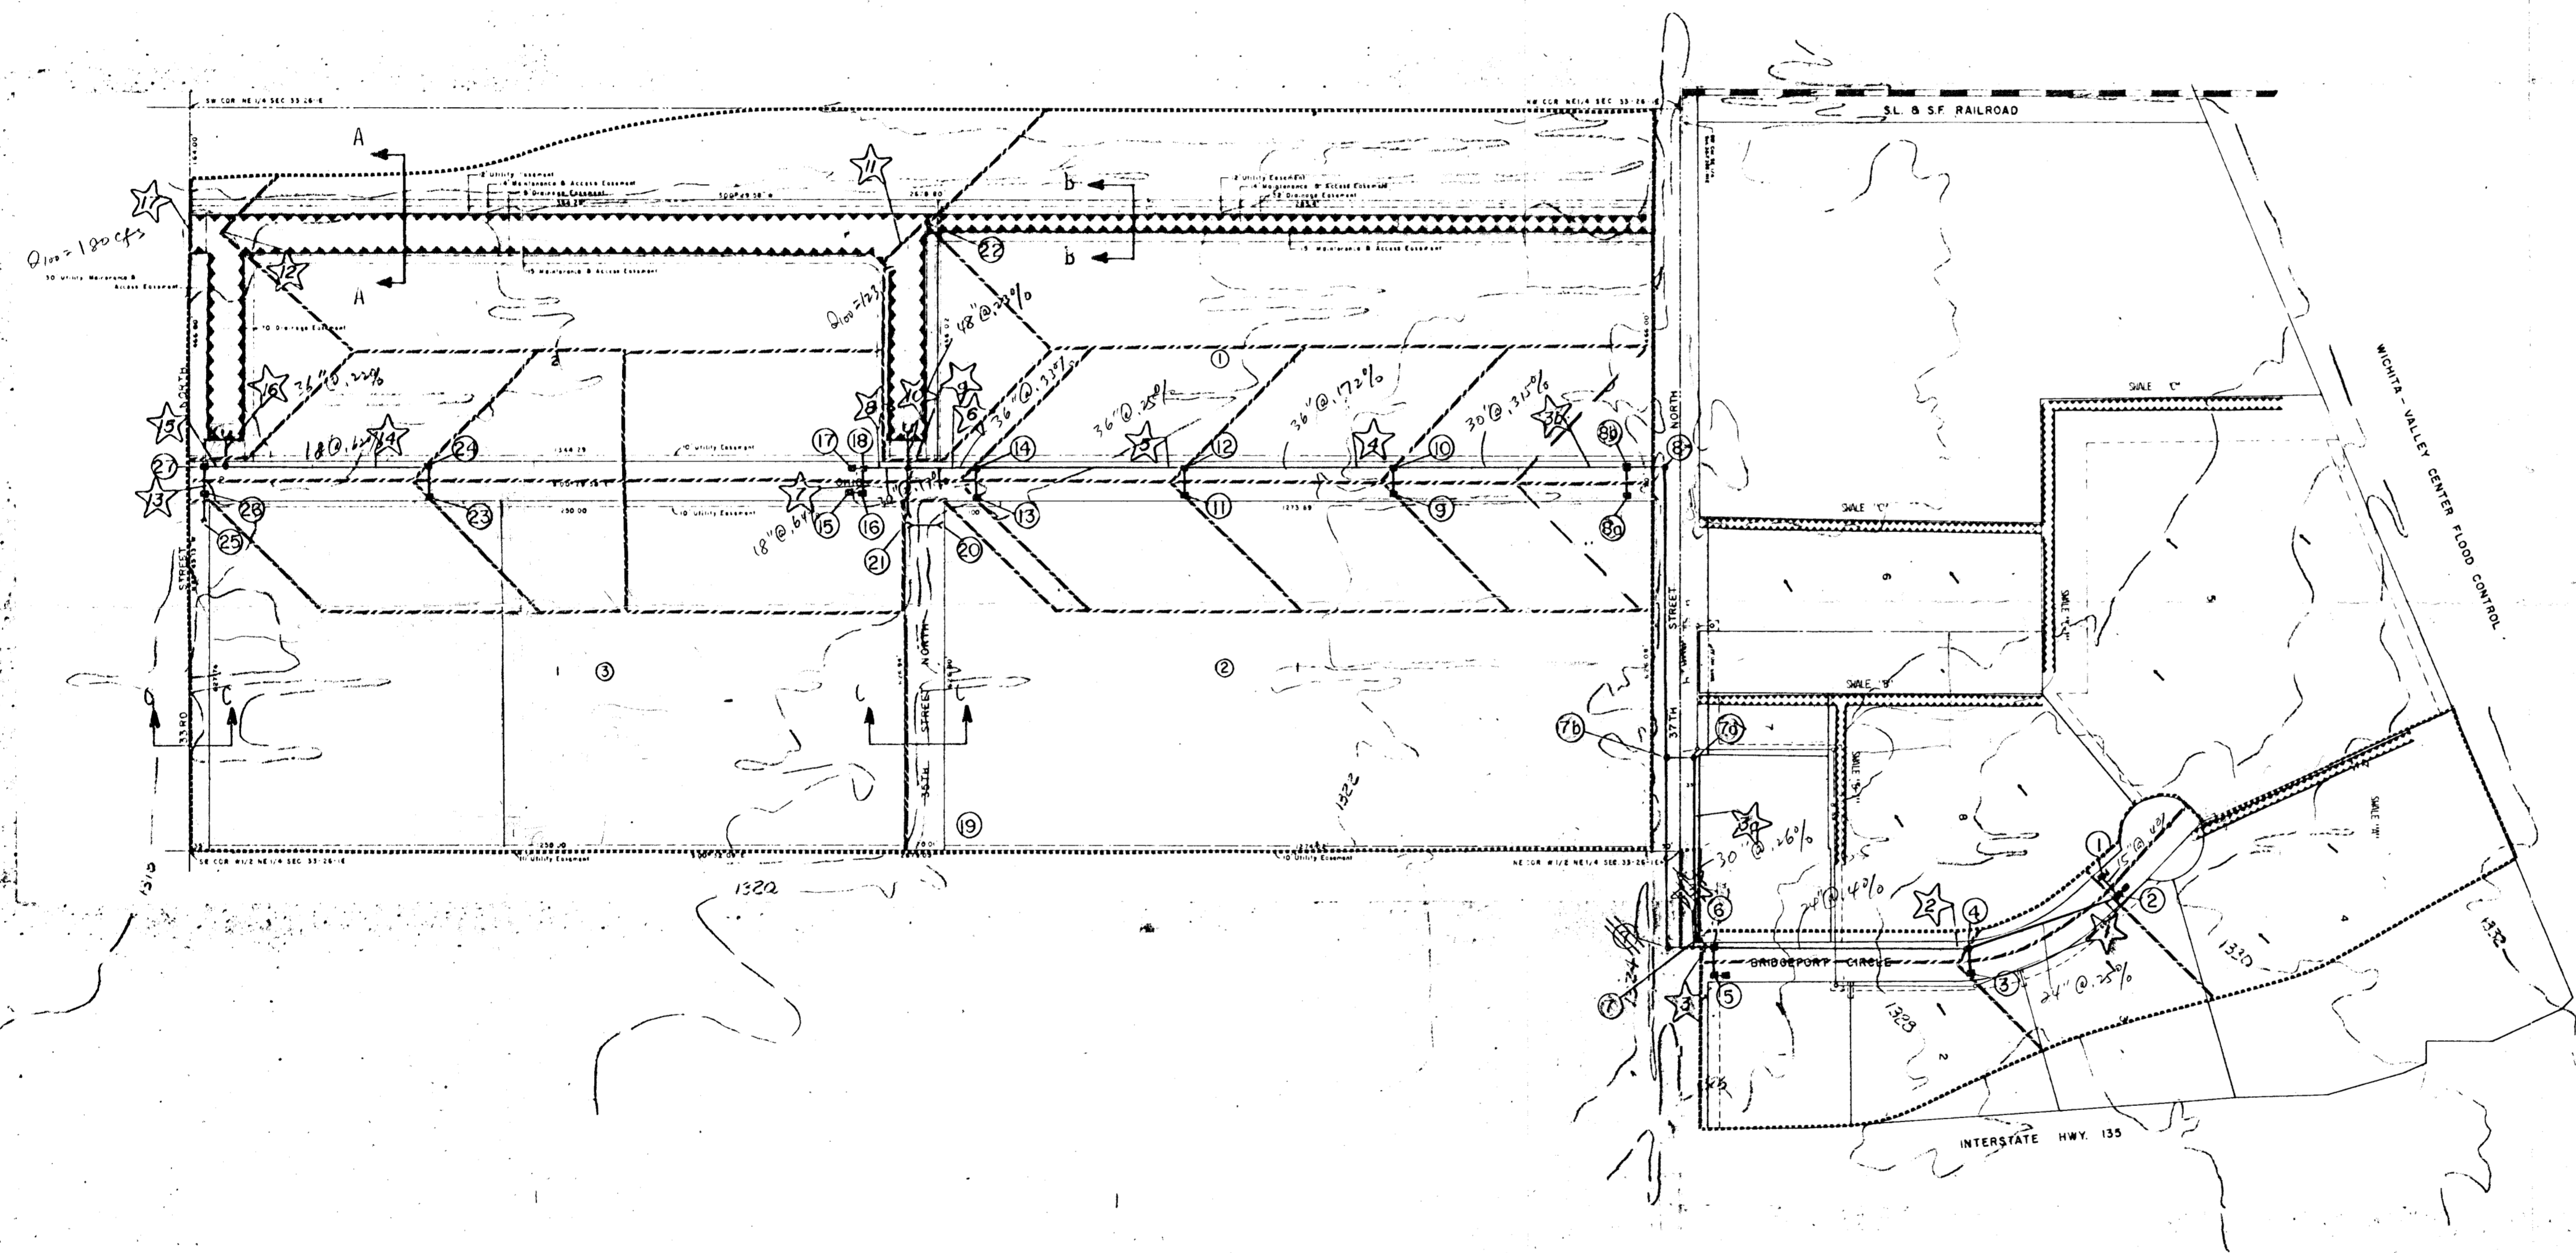

TYPICAL SECTION C-C

- ⊕ POINT REFERENCE
- ★ MAJOR COLLECTION POINTS
- REVISED FROM 1-4-80 PLAN

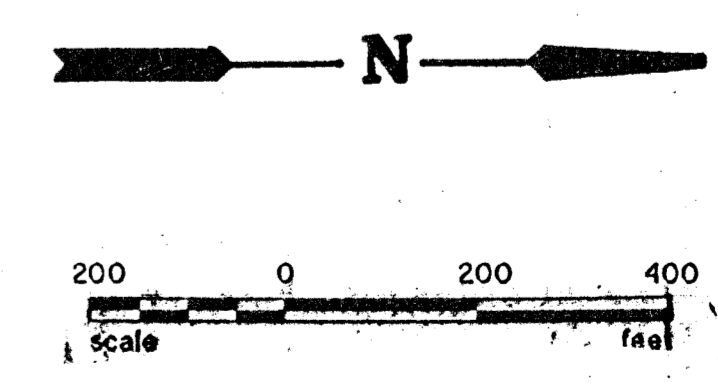

dp	BRIDGEPORT INDUSTRIAL PARKS II & III	
	Drainage Plan	
ENGINEER: T. J. T. DRAWN BY: J. G. P. DATE: JAN. 3, 1980	CONSULTING ENGINEERS	CHECKED BY: T. J. T. SCALE: NOTED SHEET 6 OF 6