


To Neodesha To Ellsworth

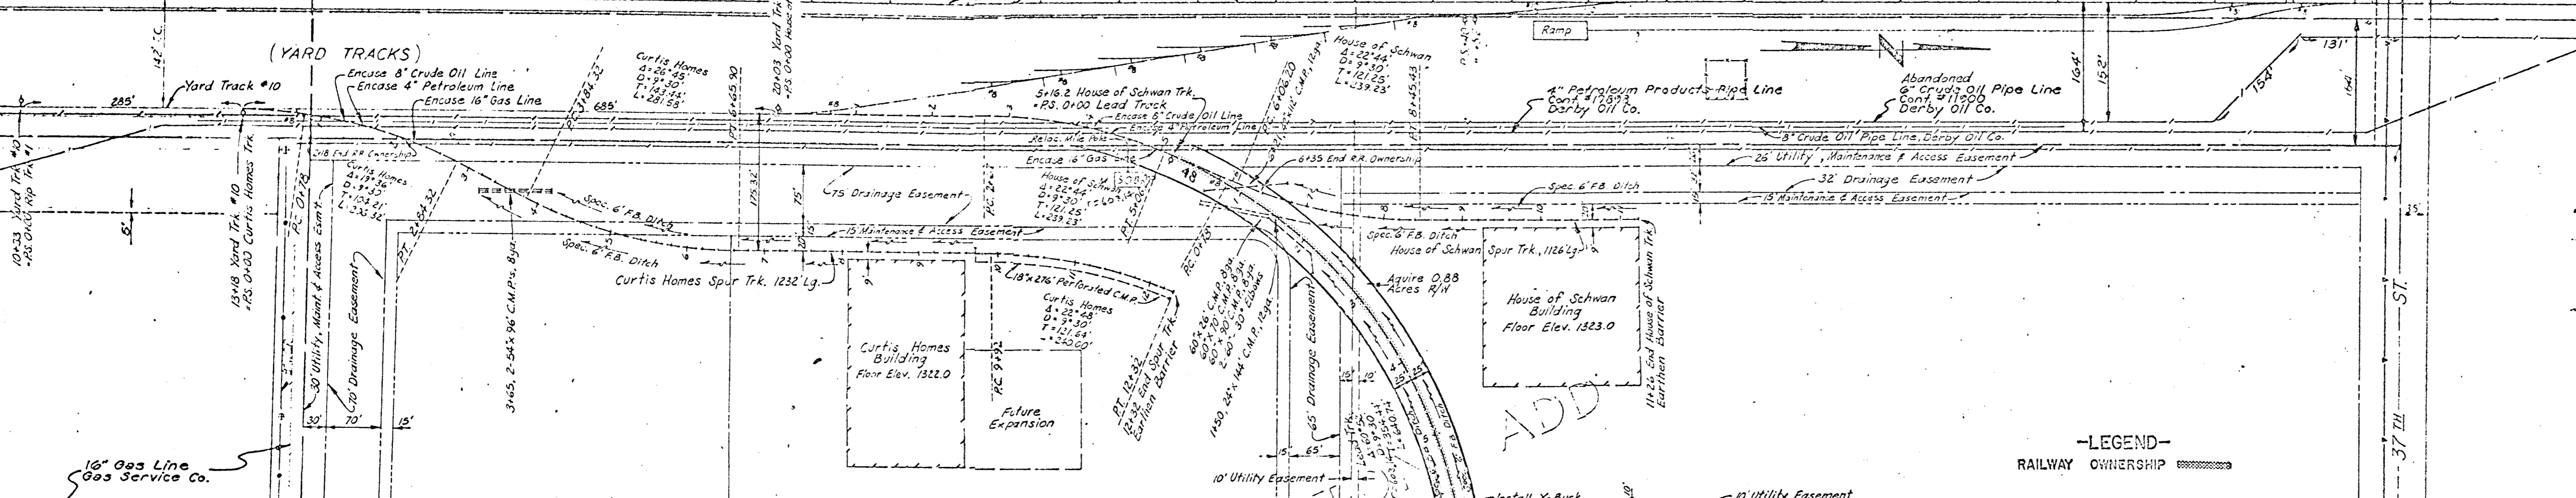

LEGEND
 RAILWAY OWNERSHIP

Note: All Pipes under Railway Tracks shall be Corrugated Metal Asphalt Coated and Asbestos Bonded.

Has any one approved drainage or RR Crossing

REVISION	BURLINGTON NORTHERN RAILROAD COMPANY
	SPRINGFIELD REGION
	SPRINGFIELD DIVISION
	PLAN
	LEAD TRACK
	LINE SEGMENT 1004 M.P. F-508
	WICHITA, SEDGWICK CO., KANSAS
	SCALE: 1" = 100'
	MARCH 19, 1932
	ENGINEERING DIVISION
	SPRINGFIELD, MO.