


BRIDGEPORT I

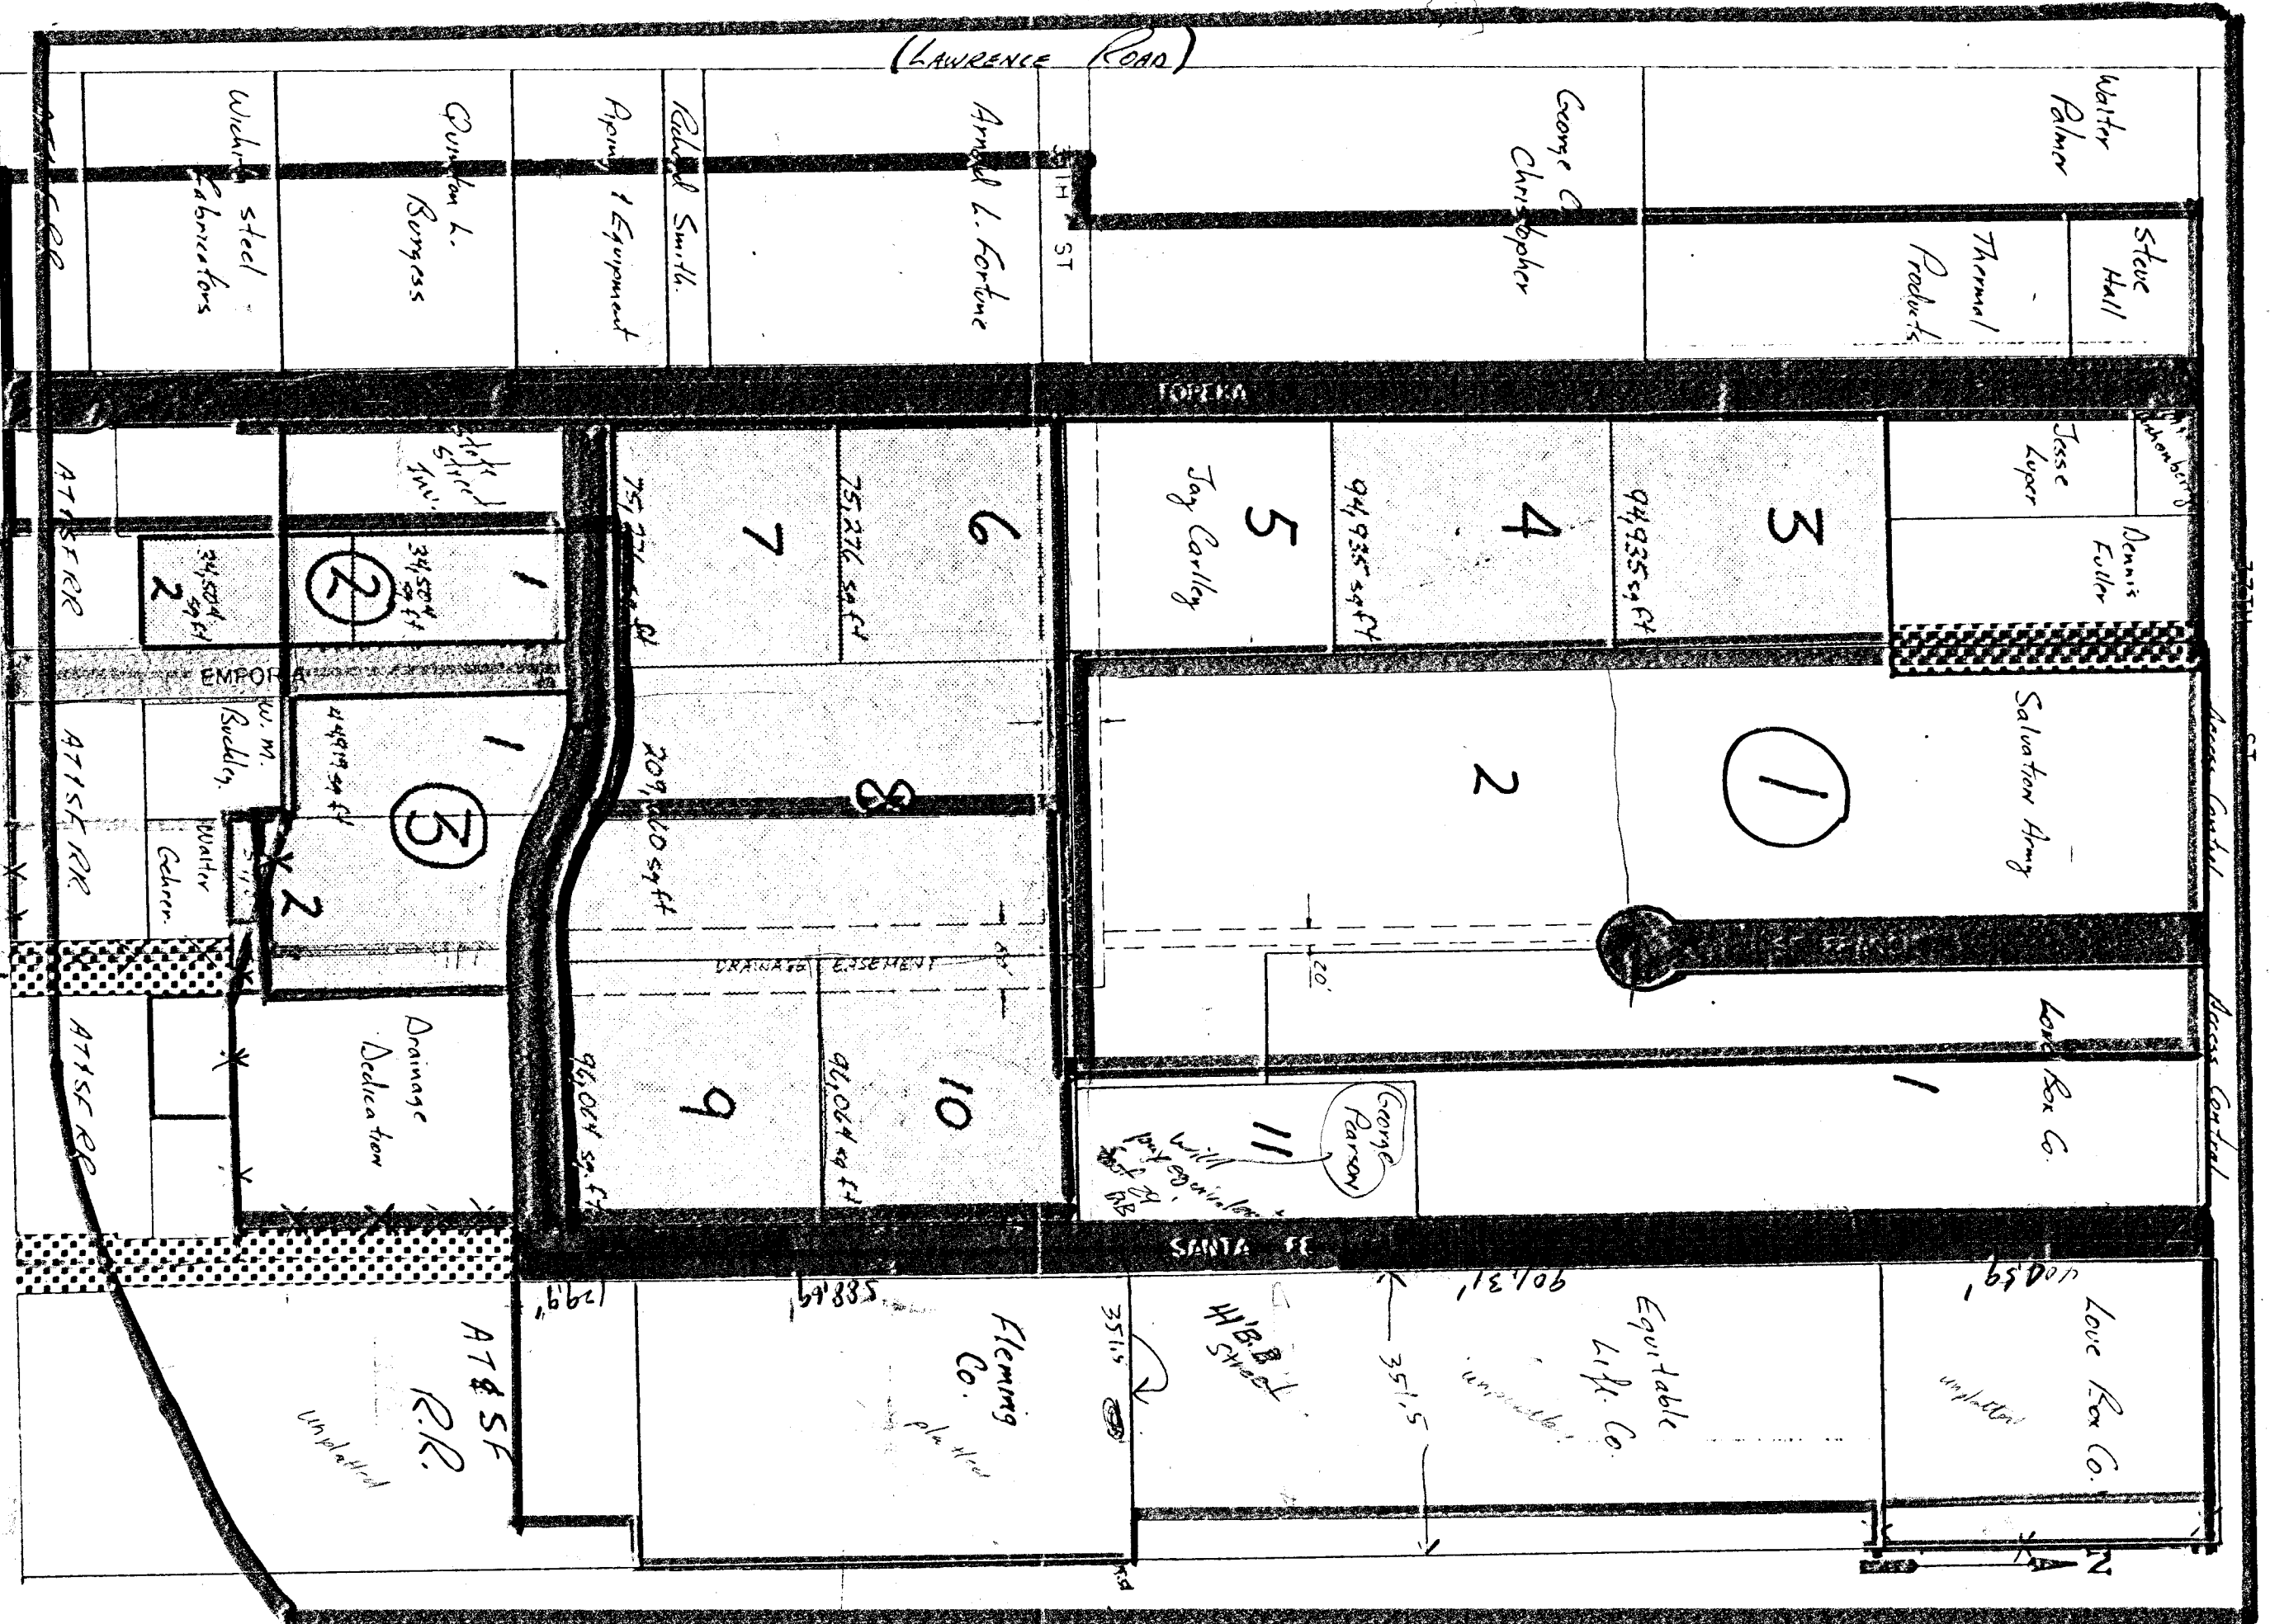

STREETS TO BE VACATED
CITY-OWNED PROPERTY

STREET BENEFIT DISTRICTS
TOPEKA ST. FRANCIS
SANTA FE 34TH STREET
EMPORIA

Not to be vacated

DRAINAGE DISTRICT