
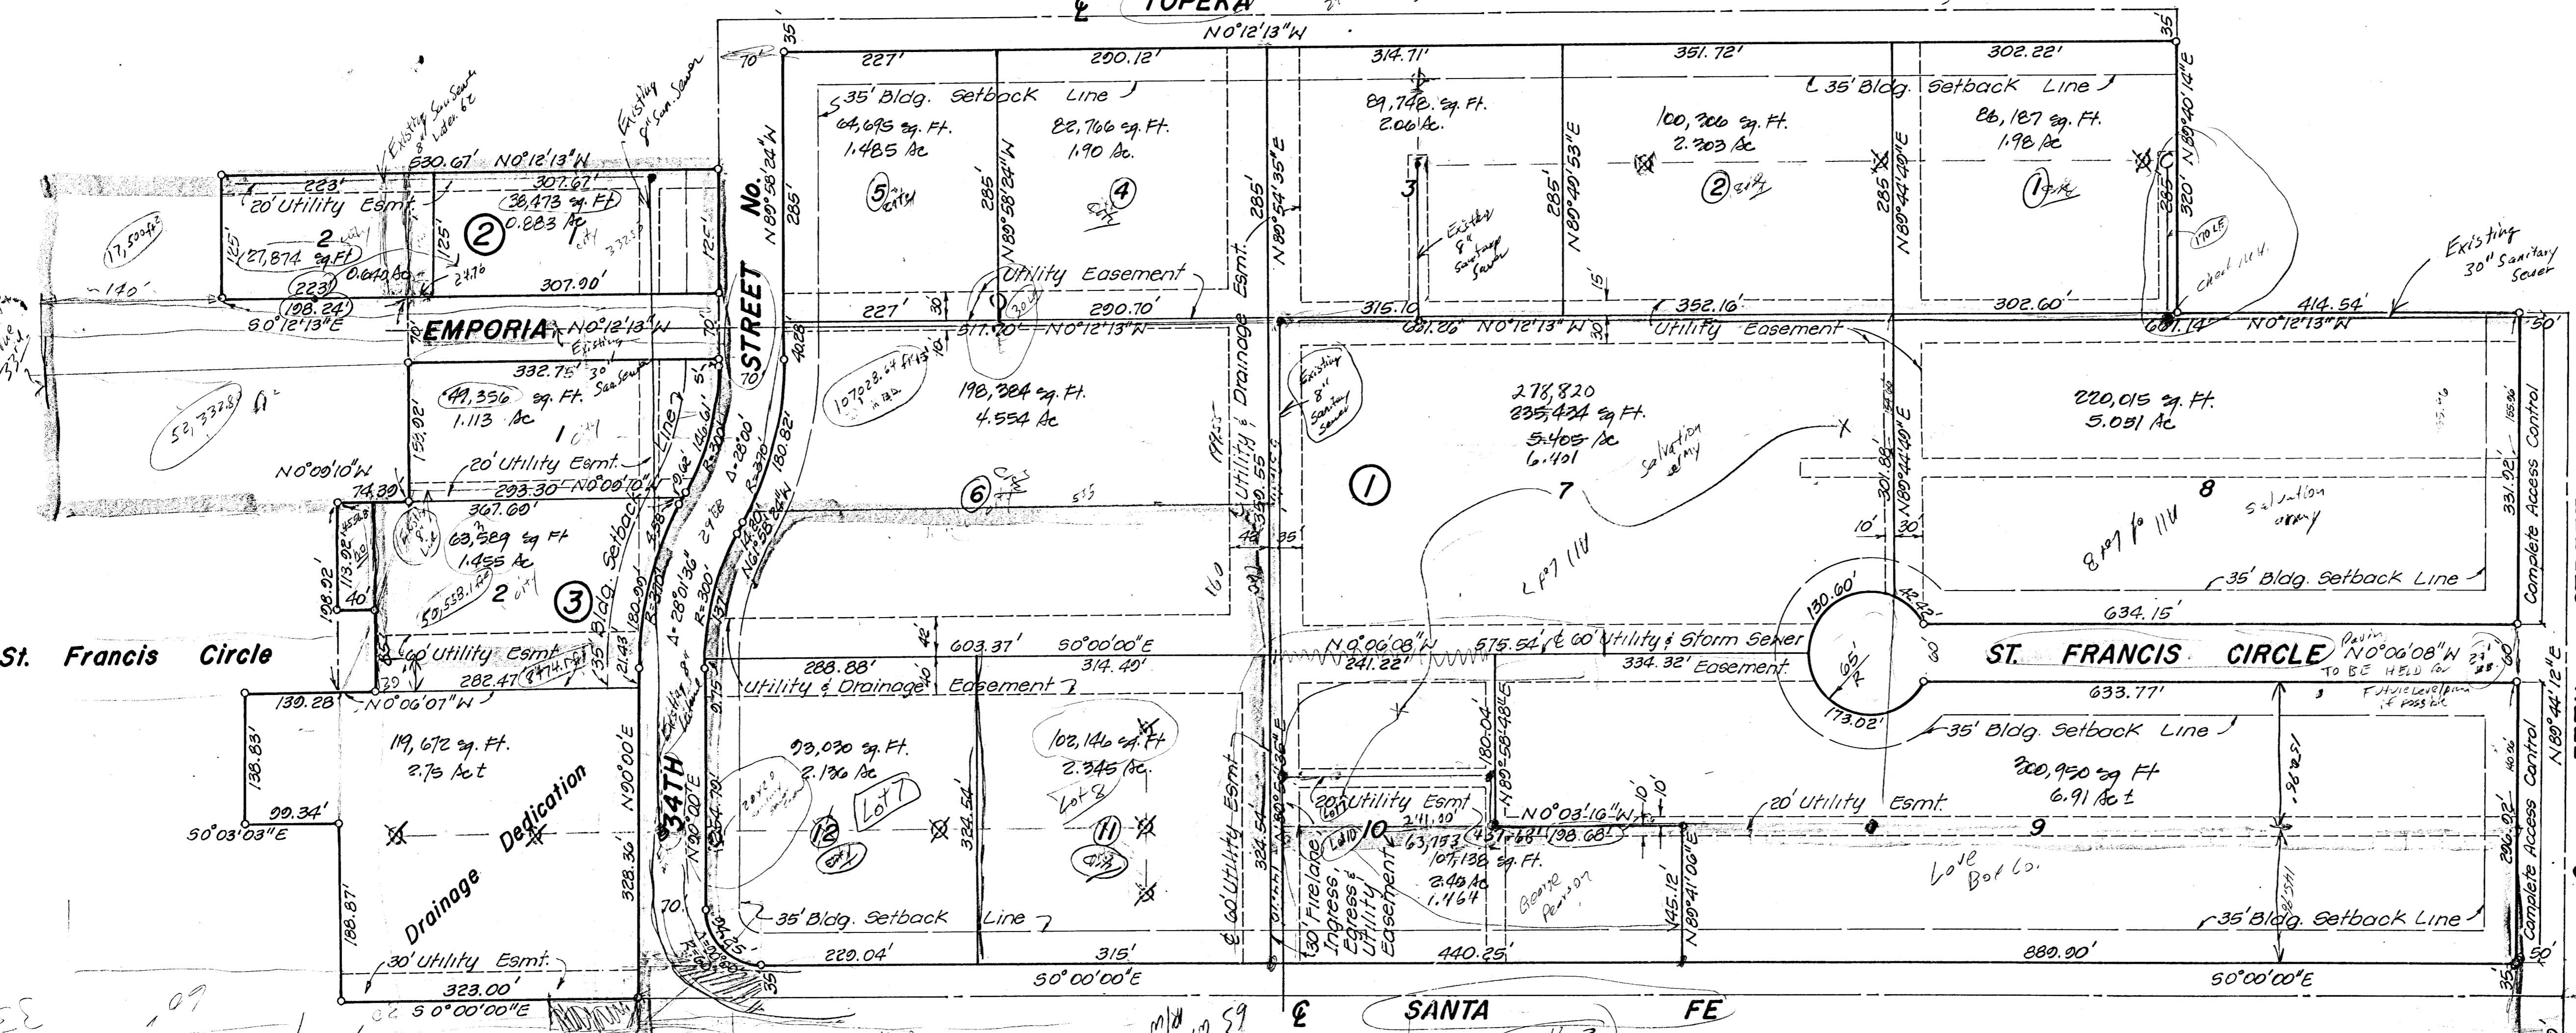


TOPEKA

3' must be dedicated 30' R/W

NORTH

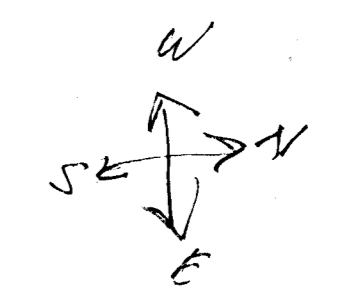

St. Francis Circle

Drainage Dedication

ST. FRANCIS CIRCLE

SANTA FE


- To be abandon - laterals
- ✗ To be a bandon - Manholes
- To be installed - laterals
- o To be installed - Manholes

7 lots in B to for sewer Lot 1, 2, 4, 5, 6, 11, 12

15000  
17000  
31900  
63900

231500  
88500  
343000

4754  
4704  
2352

68421.7  
23578.3

498835  
171900  
-670735

NE Cor. NW 1/4, Sec. 33, T20S, R1E of 6th PM.

not included  
do not do the 37th St. N

244,565.00

17,000

52,332.8

50,558.1

130.83'

99.34'

188.87'

323.00'

50'03'03"E

50'00'00"E

50'00'00"E

50'00'00"E

50'00'00"E

223'

27,874 sq. Ft.

198.24'

60'12'13"E




























