


WICHITA, SEDGWICK COUNTY, KANSAS.

Scale 1"=100'

N.W. Cor. 1 T26S, R1

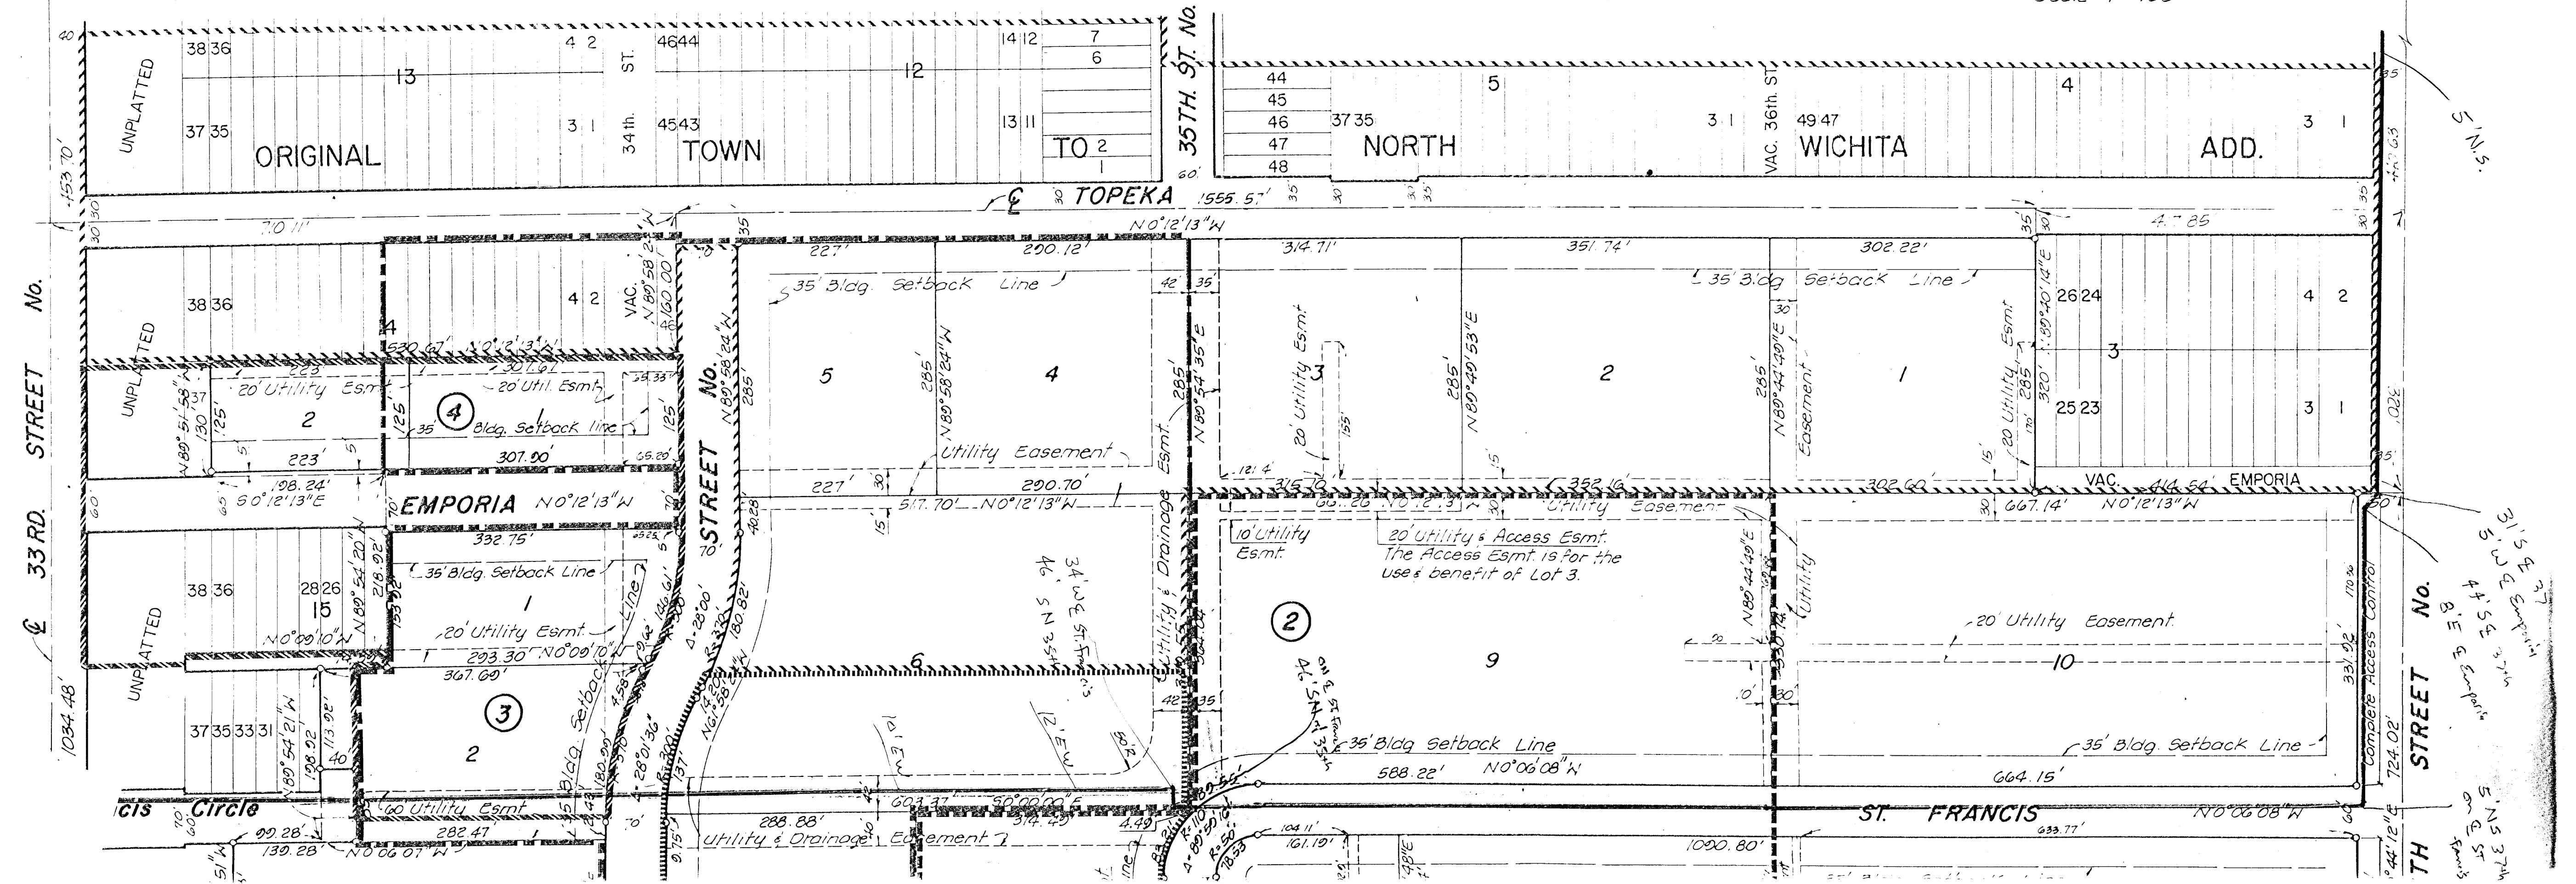

