




Sedgwick County
 Register of Deeds - Bill Meek
 DOC. #/FLM-PG: 28944917
 Recording Fee: \$16.00
 Receipt #: 1676925
 Authorized By: 
 Pages Recorded: 3
 Cashier Initials: AL

Date Recorded: 1/10/2008 1:59:47 PM




CERTIFICATE OF CORRECTION TO MINIMUM BUILDING PAD ELEVATIONS
 AND AFFECTED LOTS

SILVERTON ADDITION
 WICHITA, SEDGWICK COUNTY, KANSAS

State of Kansas) SS We, *Baughman Company, P.A., Surveyors*
 Sedgwick County) in aforesaid county and state do hereby certify that certain errors
 do exist regarding the elevations and affected Lots as indicated in
 the "MINIMUM BUILDING PAD TABLE" block for Lots 12 through 21,
 Lots 33 through 37, and Lots 45 through 48, Block A, and Lots 12
 through 36, and Lots 39 through 68, Block C, and Lots 13 through
 25, and Lots 49 through 53, and Lots 62 through 65, Block D, as
 shown of the face of the above referenced plat and that corrections
 of said elevations and affected Lots are necessary. The Minimum
 Building Pad Elevation for the lowest opening to the structures on
 Lots 12 through 21, and Lots 33 through 37, and Lots 45 through
 48, Block A, shall be 1360.9 NGVD29, rather than 1362.5 NGVD29 as
 shown. The Minimum Building Pad Elevation for the lowest opening
 to the structures on Lots 12 through 36, and Lots 39 through 68,
 Block C, shall be 1360.9 NGVD29, rather than 1362.5 NGVD29 as
 shown. The Minimum Building Pad Elevation for the lowest opening
 to the structures on Lots 13 through 25, and Lots 49 through 53,
 and Lots 62 through 65, Block D, shall be 1362.1 NGVD29, rather
 than 1364.0 NGVD29 as shown.

The accompanying drawing is a true and
 correct exhibit of the corrections as noted.
Baughman Company, P.A.

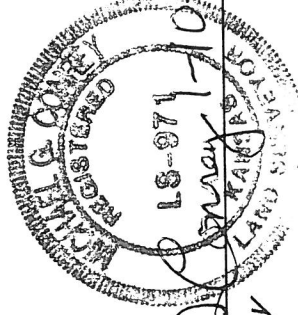

Michael G. Conrey 1-10-2008, Surveyor
 Michael G. Conrey

Baughman Company, P.A.
 315 Ellis
 Wichita, Ks 67211

MINIMUM BUILDING PAD ELEVATIONS FOR LOWEST OPENING TO THE STRUCTURES		
LOT	BLOCK	ELEVATION
		NGVD29
12-21,33-37	A	1362.5
45-48	A	1362.5
12-36	C	1362.5
39-68	C	1362.5
10-11	D	1366.6
13-25	D	1364.0
49-53,62-65	D	1364.0
67-71	D	1366.6
10-18	E	1366.6

**INCORRECT ELEVATIONS
AND AFFECTED LOTS**

MINIMUM BUILDING PAD ELEVATIONS FOR LOWEST OPENING TO THE STRUCTURES		
LOT	BLOCK	ELEVATION
		NGVD29
12-21,33-37	A	1360.9
45-48	A	1360.9
12-36	C	1360.9
39-68	C	1360.9
10-11	D	1366.6
13-25	D	1362.1
49-53,62-65	D	1362.1
67-71	D	1366.6
10-18	E	1366.6

**CORRECTED ELEVATIONS
AND AFFECTED LOTS**

AFFIDAVIT

State of Kansas)
Sedgwick County) SS

James L. Armour, P.E., City Engineer
for the City of Wichita, Kansas, being first duly sworn, on oath, states:


I have examined the final plat of "SILVERTON ADDITION", Wichita, Sedgwick County, Kansas, and have found that certain errors do exist regarding the elevations and affected Lots as indicated in the "MINIMUM BUILDING PAD TABLE" block for Lots 12 through 21, Lots 33 through 37, and Lots 45 through 48, Block A, and Lots 12 through 36, and Lots 39 through 68, Block C, and Lots 13 through 25, and Lots 49 through 53, and Lots 62 through 65, Block D as shown of the face of the above referenced plat and that corrections of said elevations and affected Lots are necessary. The Minimum Building Pad Elevation for the lowest opening to the structures on Lots 12 through 21, and Lots 33 through 37, and Lots 45 through 48, Block A, shall be 1360.9 NGVD29, rather than 1362.5 NGVD29 as shown. The Minimum Building Pad Elevation for the lowest opening to the structures on Lots 12 through 36, and Lots 39 through 68, Block C, shall be 1360.9 NGVD29, rather than 1362.5 NGVD29 as shown. The Minimum Building Pad Elevation for the lowest opening to the structures on Lots 13 through 25, and Lots 49 through 53, and Lots 62 through 65, Block D, shall be 1362.1 NGVD29, rather than 1364.0 NGVD29 as shown.

FURTHER AFFIANT SAITH NOT


James L. Armour, P.E.

Dated this 10th day of JANUARY, 2008.

State of Kansas) SS The foregoing instrument acknowledged before me, this 10th day of January, 2008, by James L. Armour, P.E., City Engineer for the City of Wichita, Kansas.

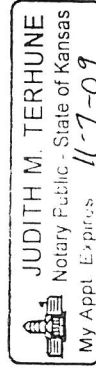


Judith M. Terhune, Notary Public

My App't. Exp't. 11-7-09