


LEGAL DESCRIPTION

LOT 24 & 25 - BLOCK 1
COUNTRY PLACE ESTATES
WICHITA, KANSAS
1725 GATEWOOD

1725 GATEWOOD
VAN DUSEN CONSTRUCTION

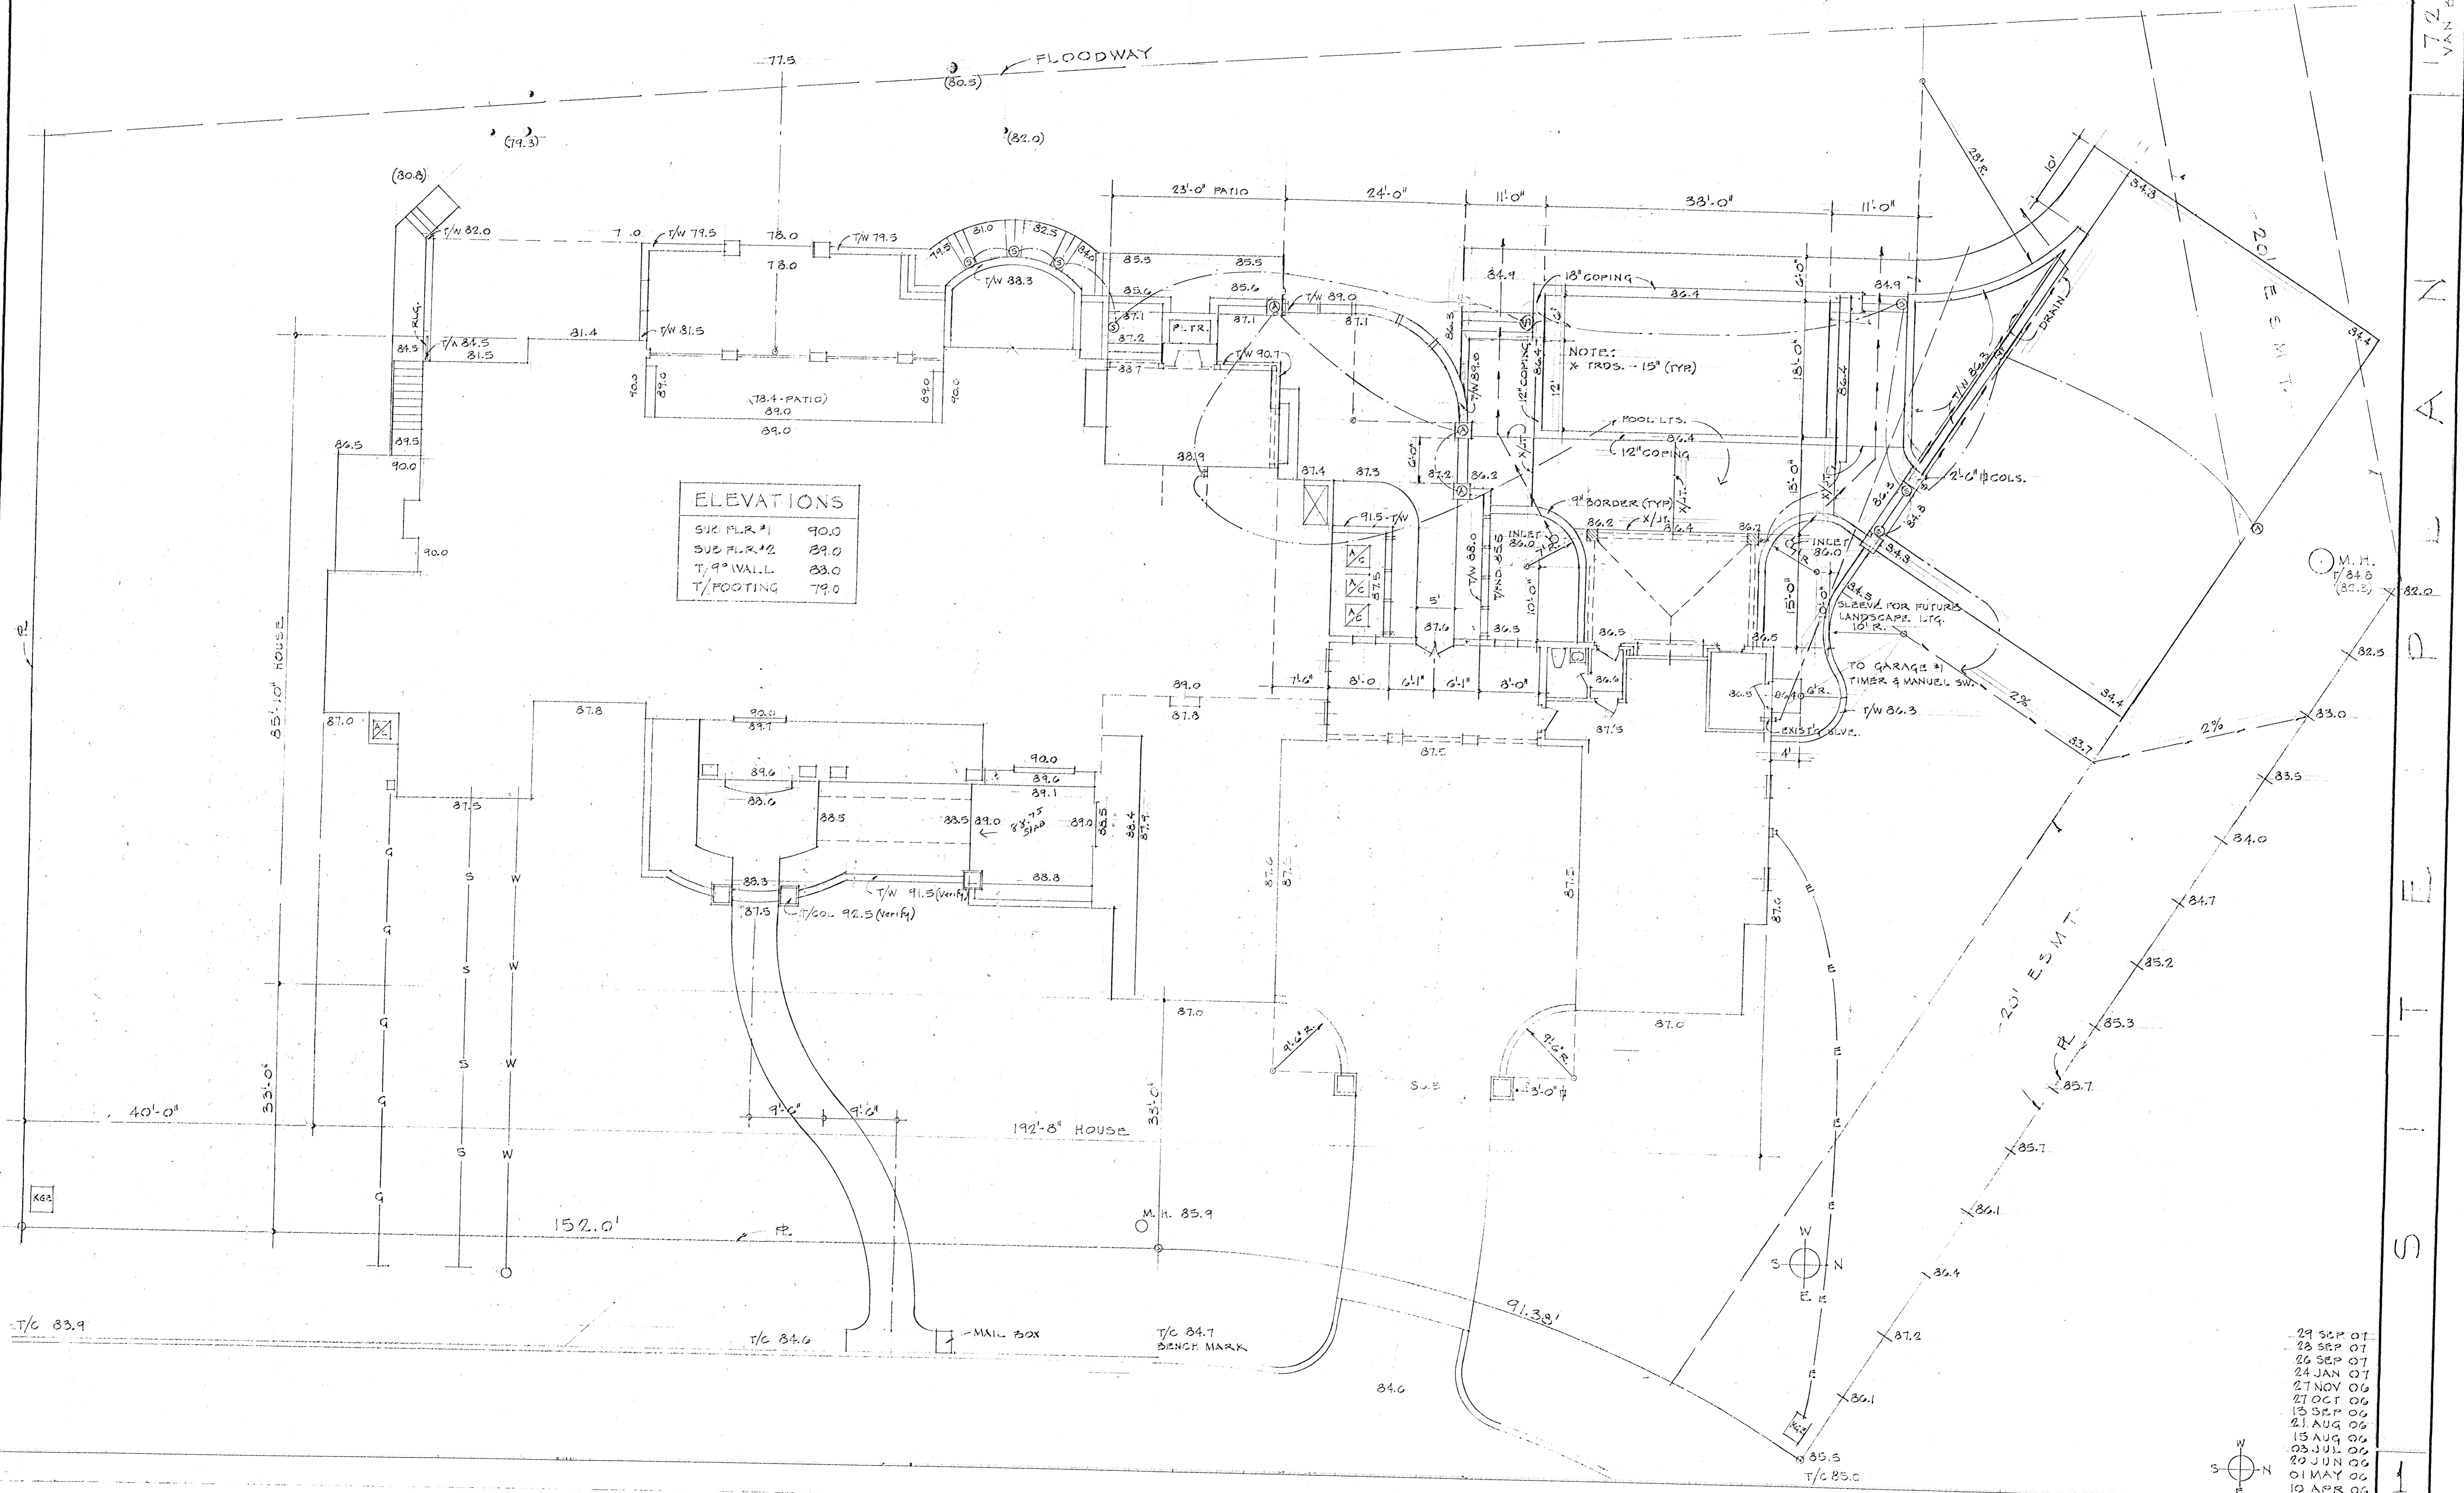

ELEVATIONS

SUB FLR #1	90.0
SUB FLR #2	89.0
TYP WALL	88.0
TYP FOOTING	79.0

NOTE:
X PROS. - 15" (TYP)

TO GARAGE #1
TIMER & MANUAL SW.
T/W 84.3

- 29 SEP 07
- 28 SEP 07
- 26 SEP 07
- 24 JAN 07
- 27 NOV 06
- 27 OCT 06
- 15 SEP 06
- 21 AUG 06
- 15 AUG 06
- 03 JUL 06
- 20 JUN 06
- 01 MAY 06
- 10 APR 06

