


HARRY HARRY

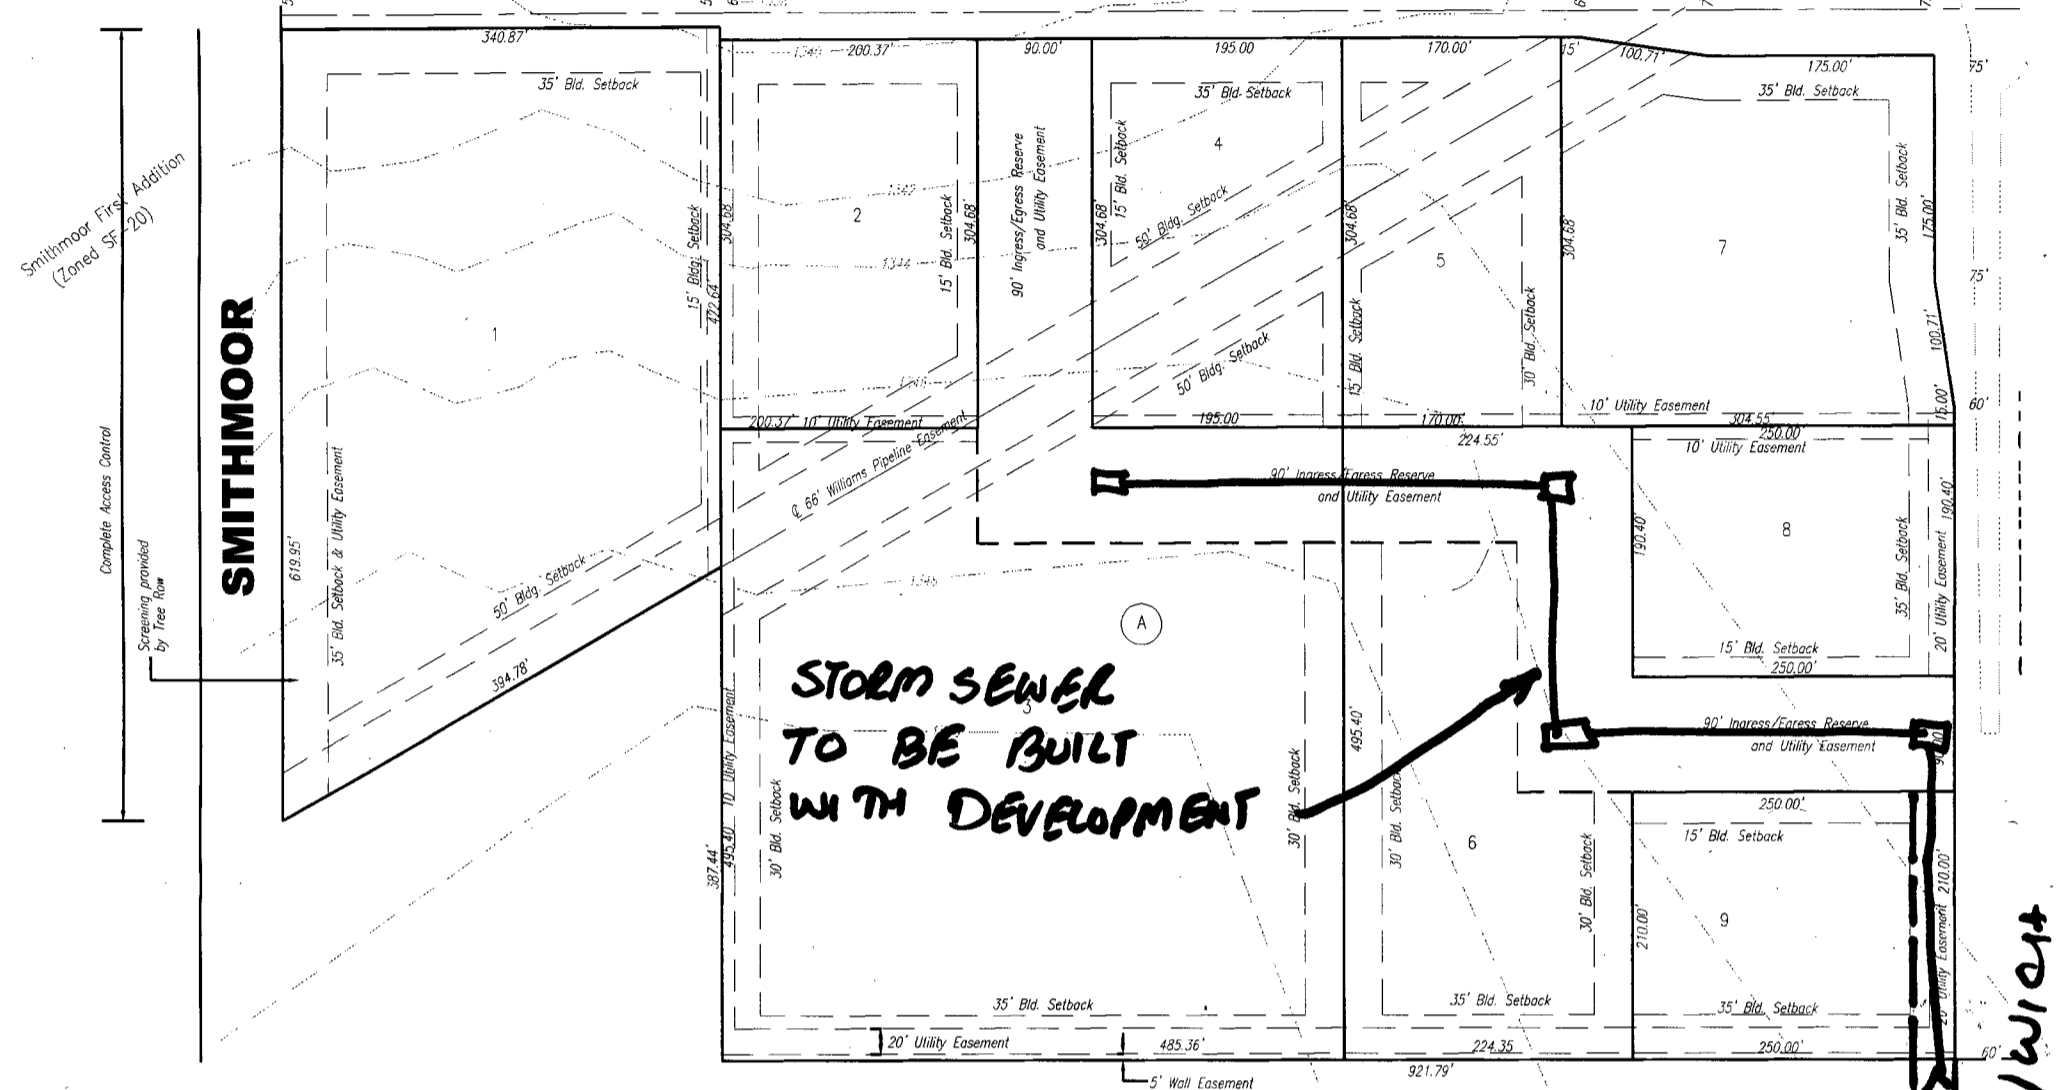

DRAINAGE CONCEPT

SMITHMOOR COMMERCIAL

ADDITION

5' BOTTOM DITCH
Proposed Smithmoor Addition

30' D.E

GREENWICH

0.5 AC. ADDITIONAL DETENTION POND

