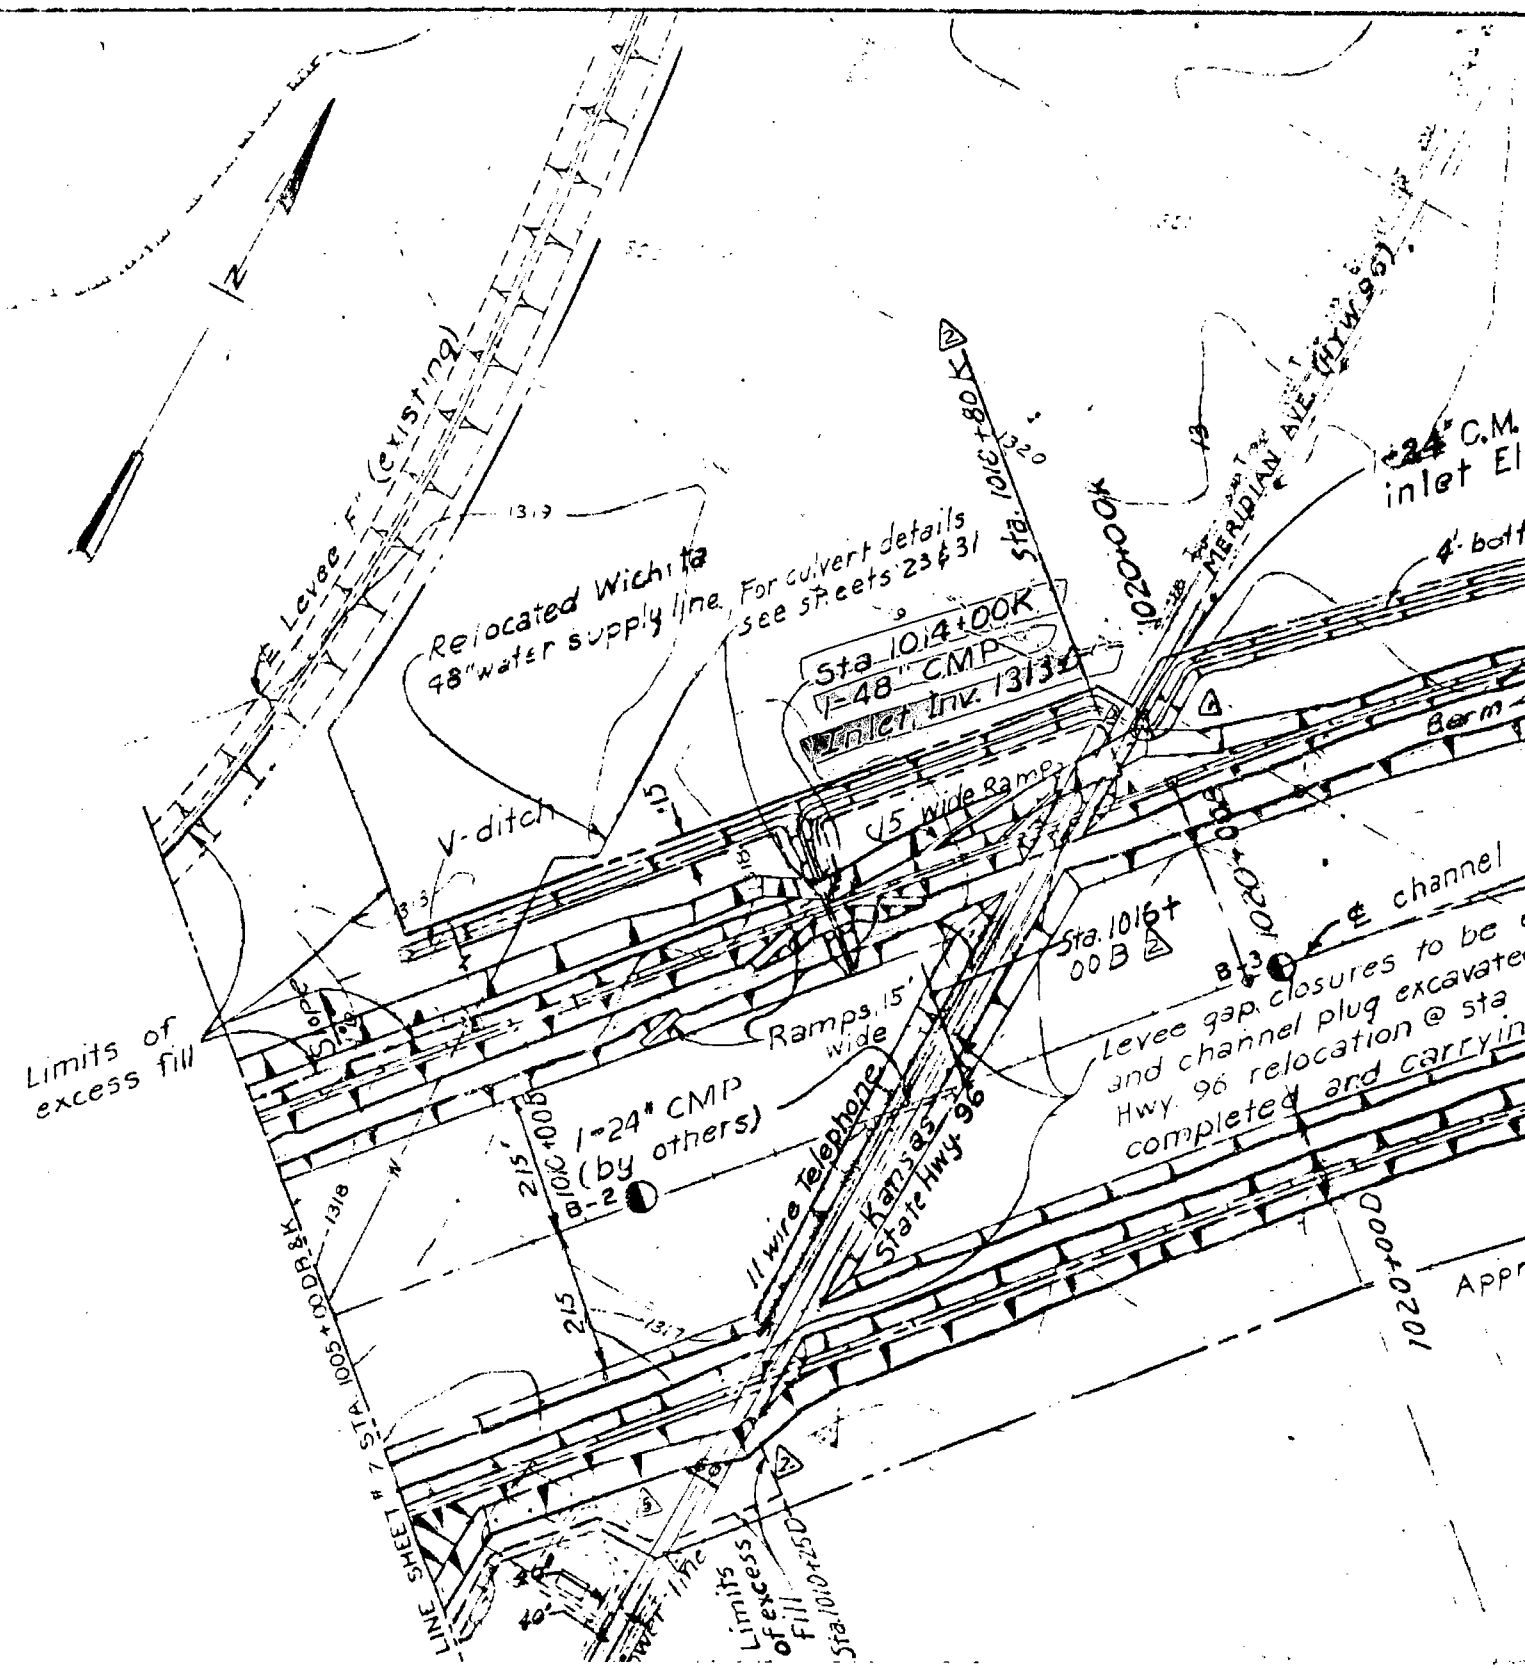

Levee "F" (existing)
Relocated Wichita 48" water supply line
For culvert details see sheets 23 & 31
Sta. 1014+00K
1-48" CMP
Inlet Inv. 1313±
Sta. 1016+80K
1020+00K
MERIDIAN AVE. (HYW 96)
1-24" C.M.
inlet El
4' bott
Berm
15' wide Ramp
V-ditch
Limits of excess fill
Slope
Ramps 15' wide
1-24" CMP (by others)
B-2
B-3
Sta. 1016+00B
1020+00B
℄ channel
Levee gap closures to be
and channel plug excavate
Hwy. 96 relocation @ sta
completed and carryin
11 wire Telephone
Kansas State Hwy. 96
1010+00D
1020+00D
Appr
LINE SHEET # 7 STA. 1005+00DB&K
Limits of excess Fill
Sta. 1010+25D