


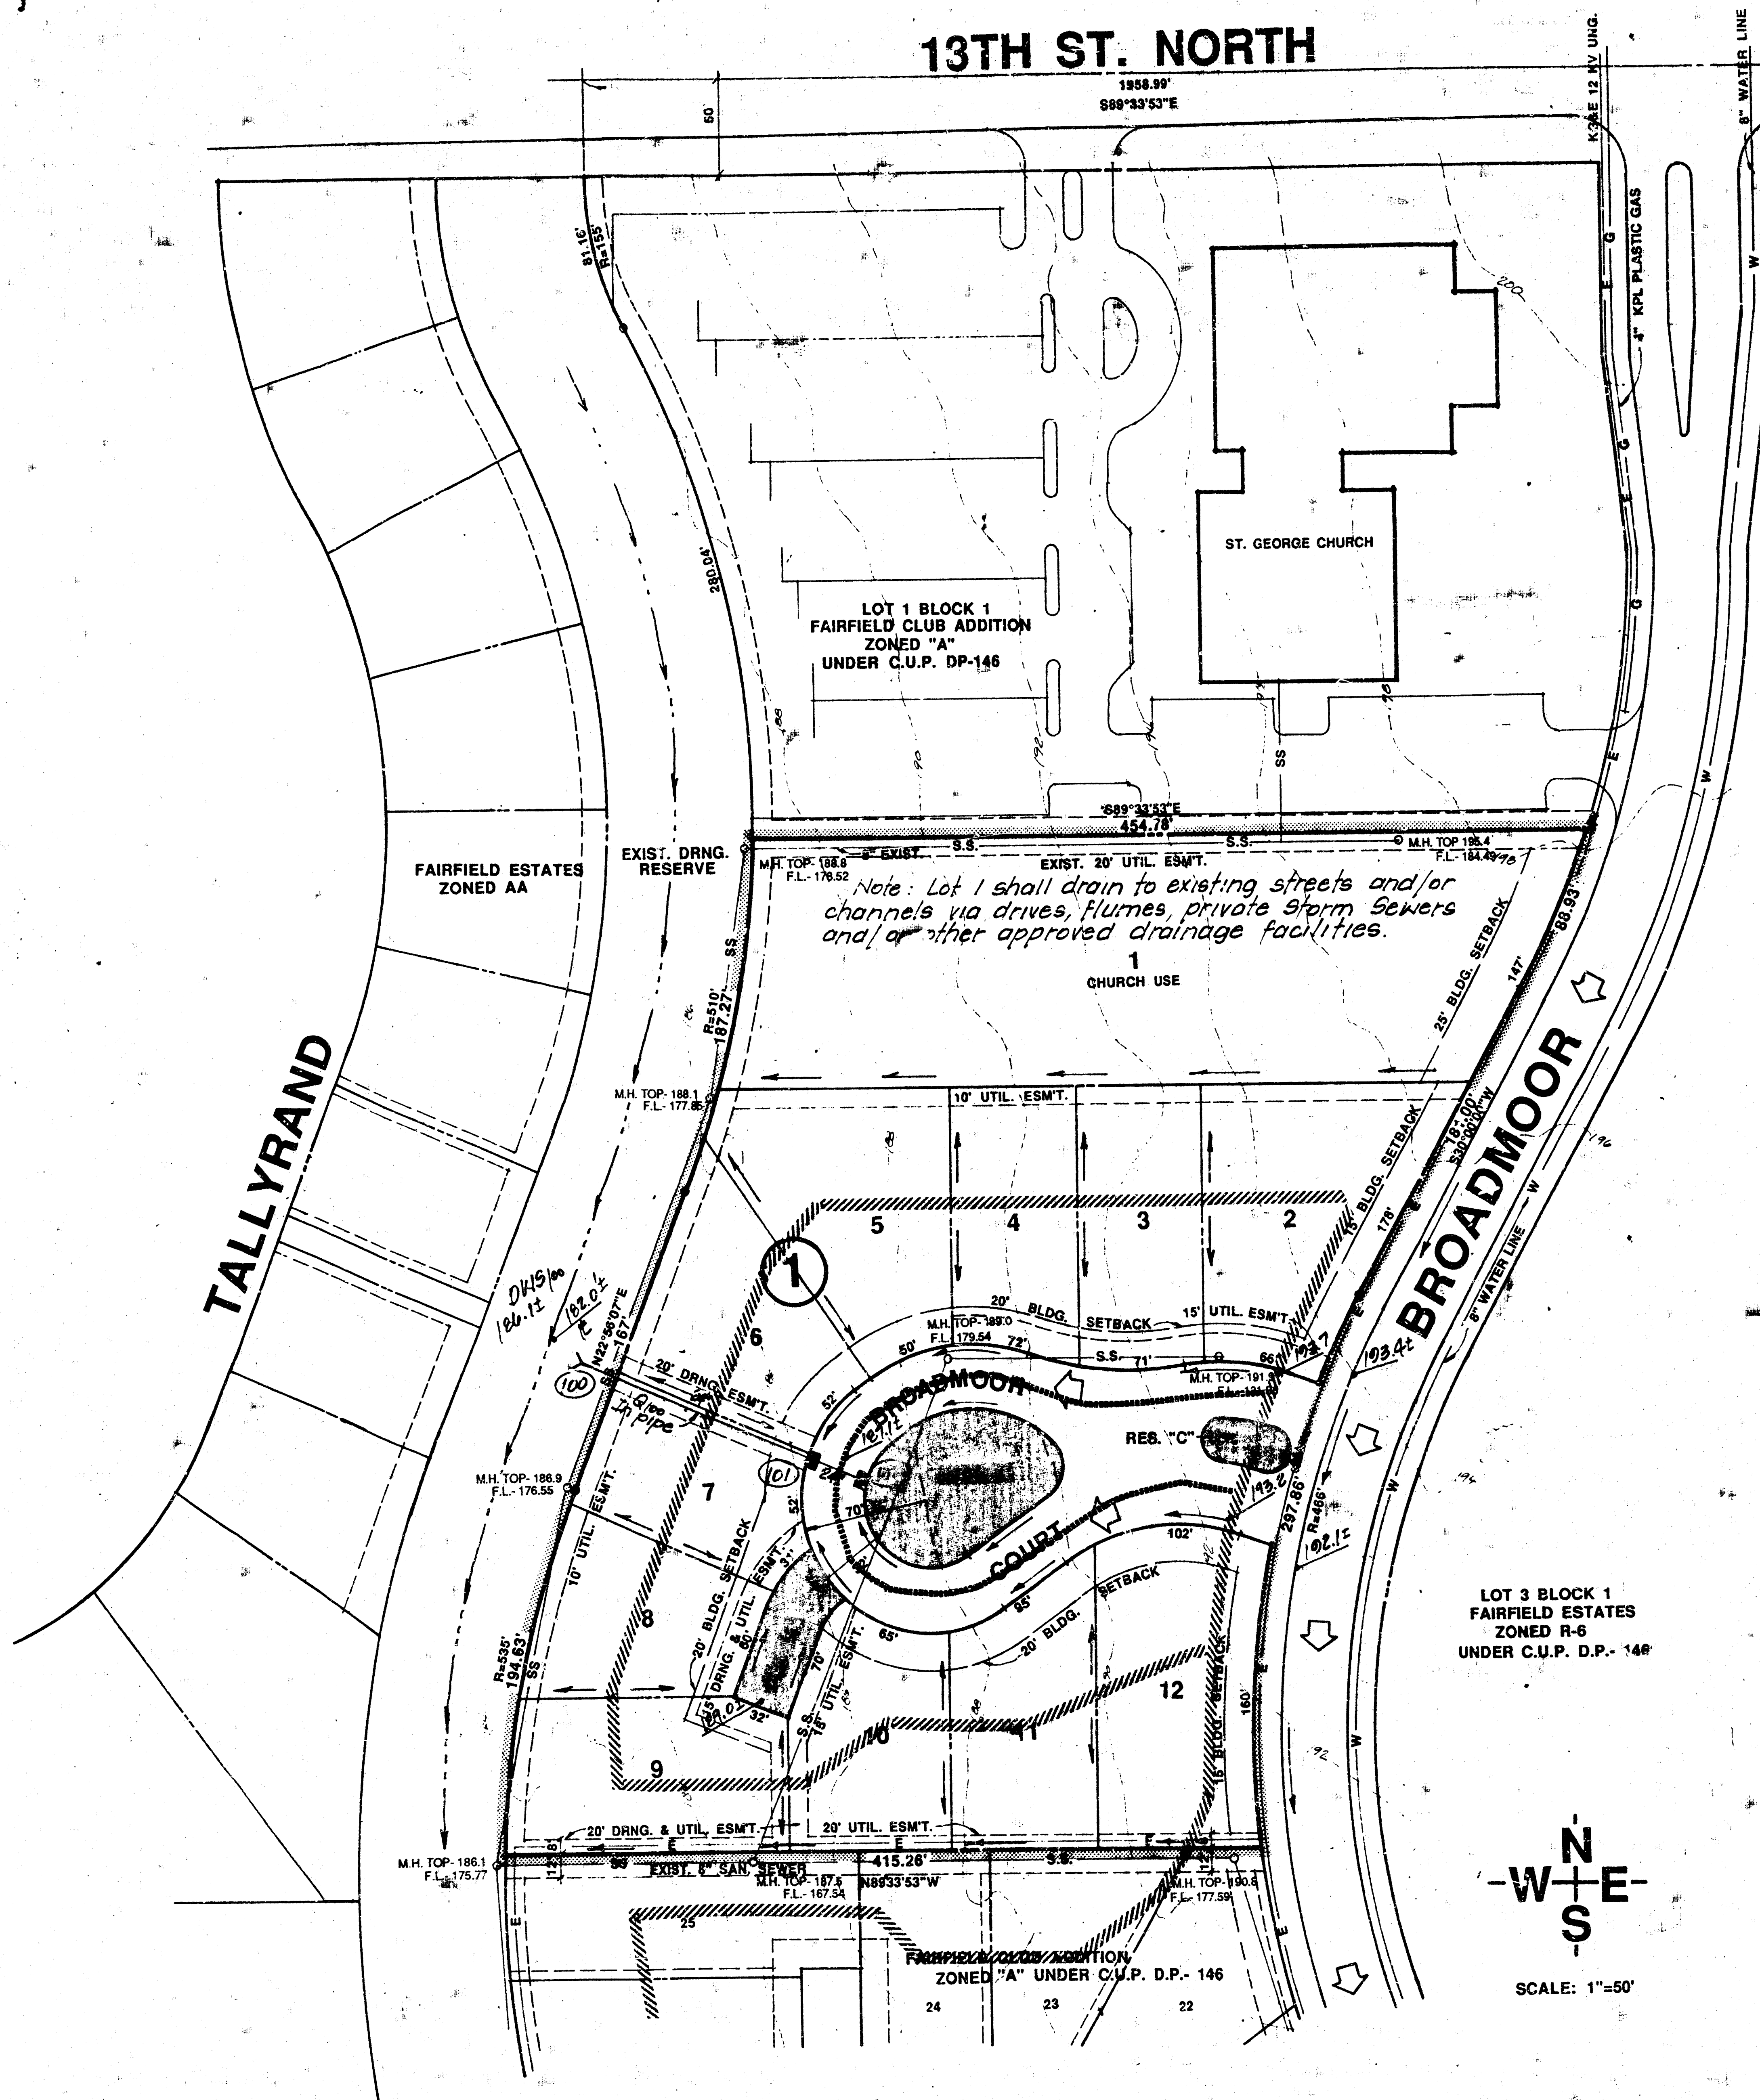

LEGEND

- Drainage Direction - Minor Storm
- ⇨ Drainage Direction - Major Storm
- Proposed Storm Water Sewer Inlet
- Drainage Basin Boundary
- Drainage Sub-Basin Boundary
- 94.2 Estimated Future Street Elevation
- (100) Node Identification Point

NOTES:


BENCHMARK: CITY OF WICHITA BENCHMARK DISC 42" NORTH AND 38" EAST OF INTERSECTION OF ROCK ROAD AND 13TH STREET NORTH. ELEV.- 186.85 CITY DATUM

SEE AMENDED FAIRFIELD RESIDENTIAL C.U.P. DP-146 FOR ADDITIONAL REQUIREMENTS.

RESERVE "A" IS PLATTED FOR DRAINAGE, UTILITIES CONFINED TO EASEMENTS AND PRIVATE DRIVE ACCESS TO LOTS 7, 8 AND 9.


RESERVE "B" IS PLATTED FOR LANDSCAPING, ENTRY MONUMENTS, GAZEBOS, AND UTILITIES CONFINED TO EASEMENTS.

RESERVE "C" IS PLATTED FOR LANDSCAPING, ENTRY MONUMENTS AND UTILITIES CONFINED TO EASEMENTS.

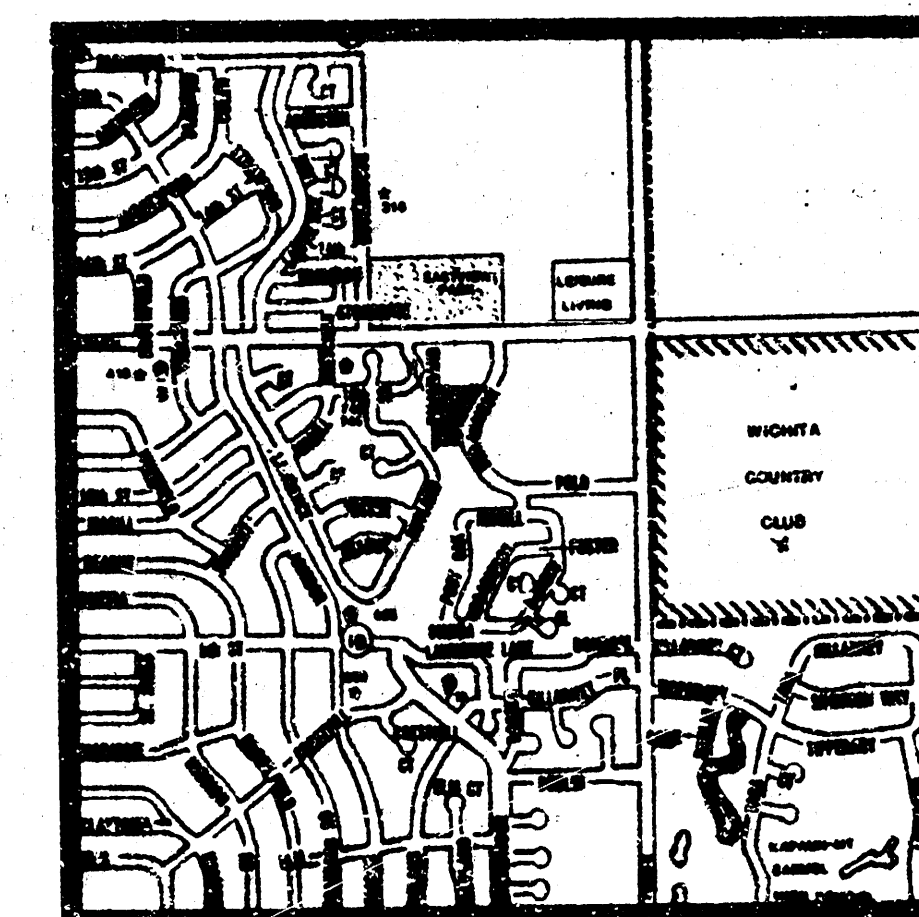

LOCATION MAP
NO SCALE

**APPROVED
DRAINAGE PLAN**

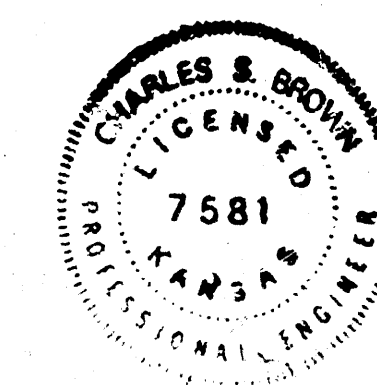

DRAINAGE PLAN CONCEPT 5/13/01

THE ABBEY AT FAIRFIELD

OWNER: RALPH RUDY 716 N. GOW, WICHITA, KANSAS 67207



BILL G. YUNG DESIGN
4112 E 29TH STREET NORTH WICHITA, KS 67203
316-863-3367 FAX 316-863-8225

DATE: APRIL 2, 1981
REV.

SHEET TITLE
PRELIMINARY PLAN

PROJECT
THE ABBEY AT FAIRFIELD

SHEET
OF

FILMED FROM THE BEST
AVAILABLE COPY

