
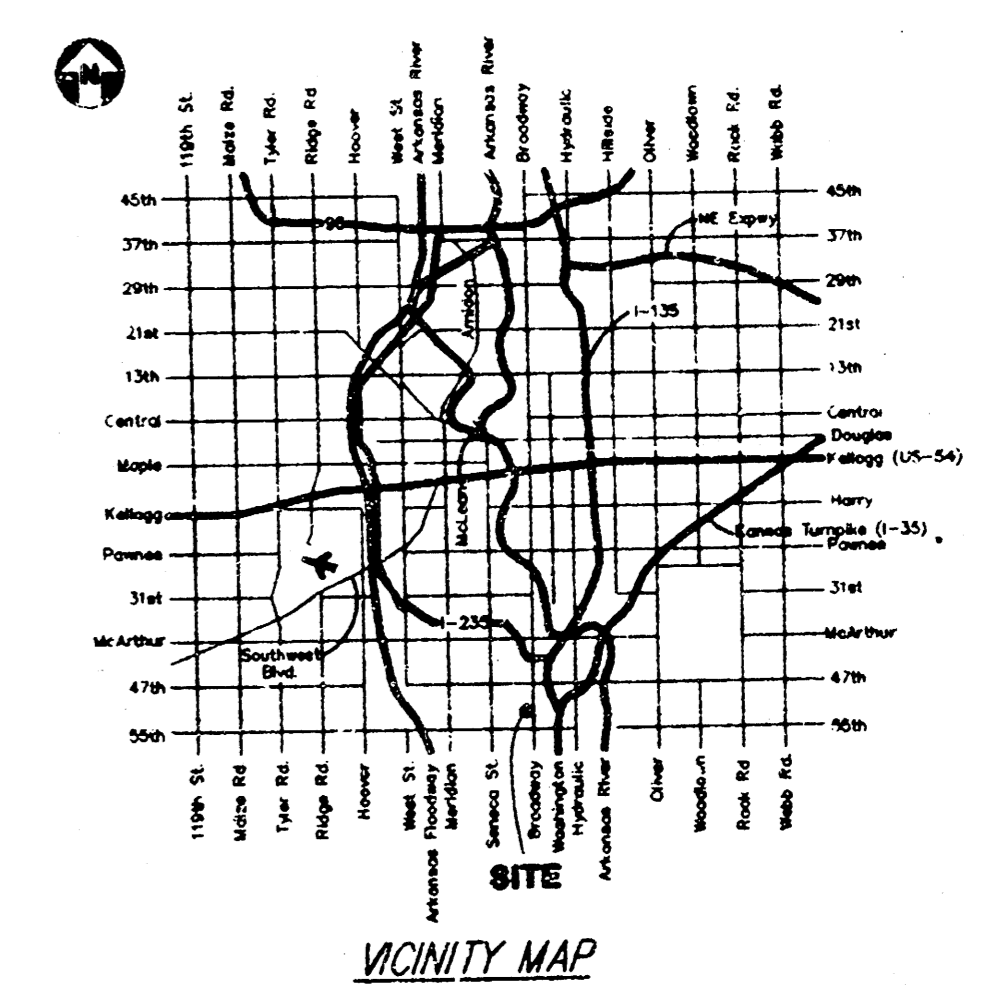
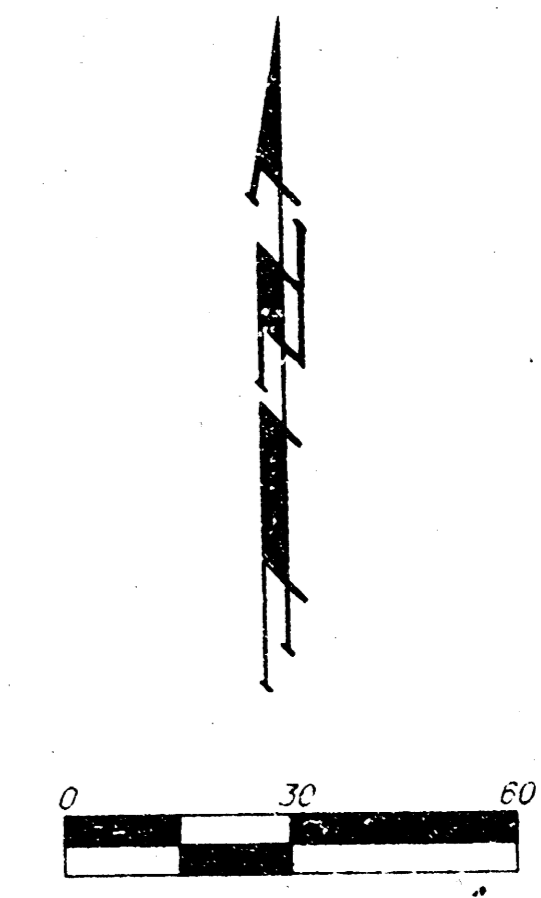


# DRAINAGE PLAN AUTOZONE ADDITION WICHITA, SEDGWICK COUNTY, KANSAS

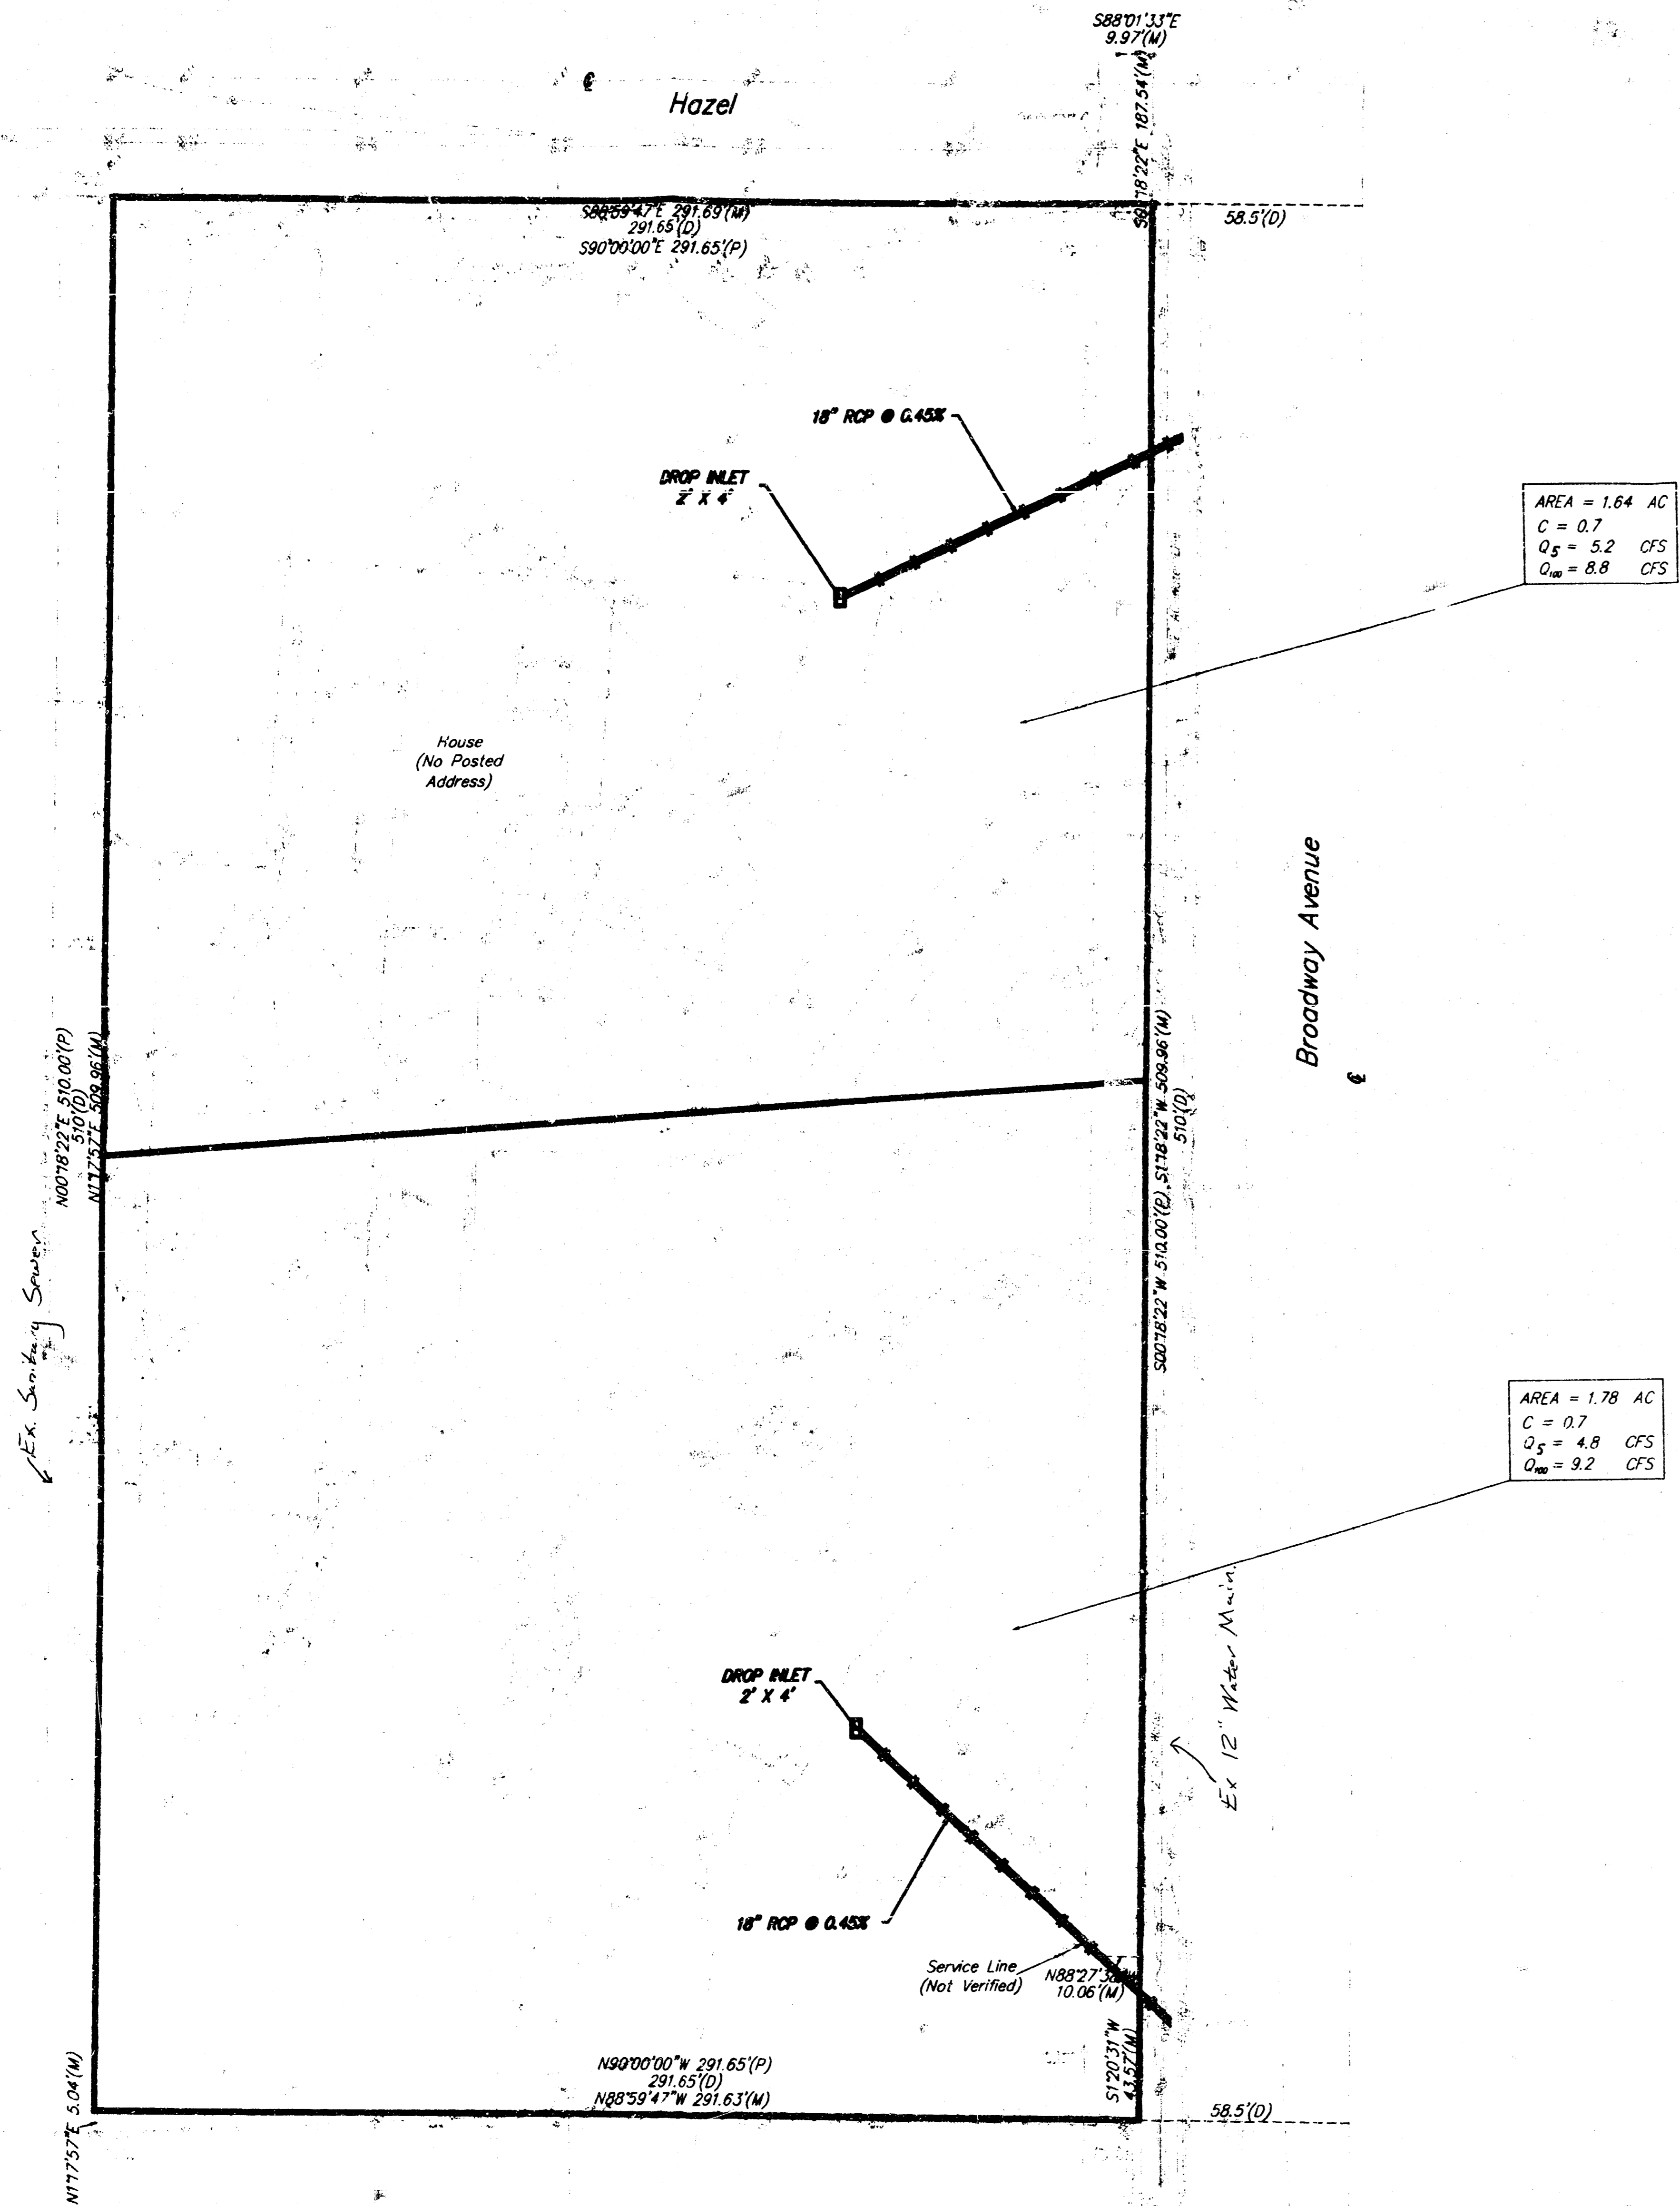

June 17, 1996