PRELIMINARY PLAT
B.B.B.R. ADDITION

NOTES

1. DRAINAGE IS EXCEPT WHEN PREPARED BY BAUSERMAN CO. P.A.
2. TOPOGRAPHIC [illegible] PREPARED BY BAUSERMAN CO. P.A. FIELD SURVEY AUGUST - 1989.
3. BENCH MARK : CHISELED [illegible] TOP OF CURB EAST SIDE INLET NORTH SIDE OF KELLOGG DRIVE ROAD 424 SOUTH SIDE OF U.S. 54, APROX. 330' WEST OF [illegible] ELEV.= 126.35 CITY DATUM.
4. REQUESTS [illegible] NORTH BOUNDARY OF LOT 1 [illegible] THE SITE [illegible] (FOR POSSIBLE [illegible] BELOW)

OWNER IS [illegible] STREET [illegible] OF DUBON AVE.
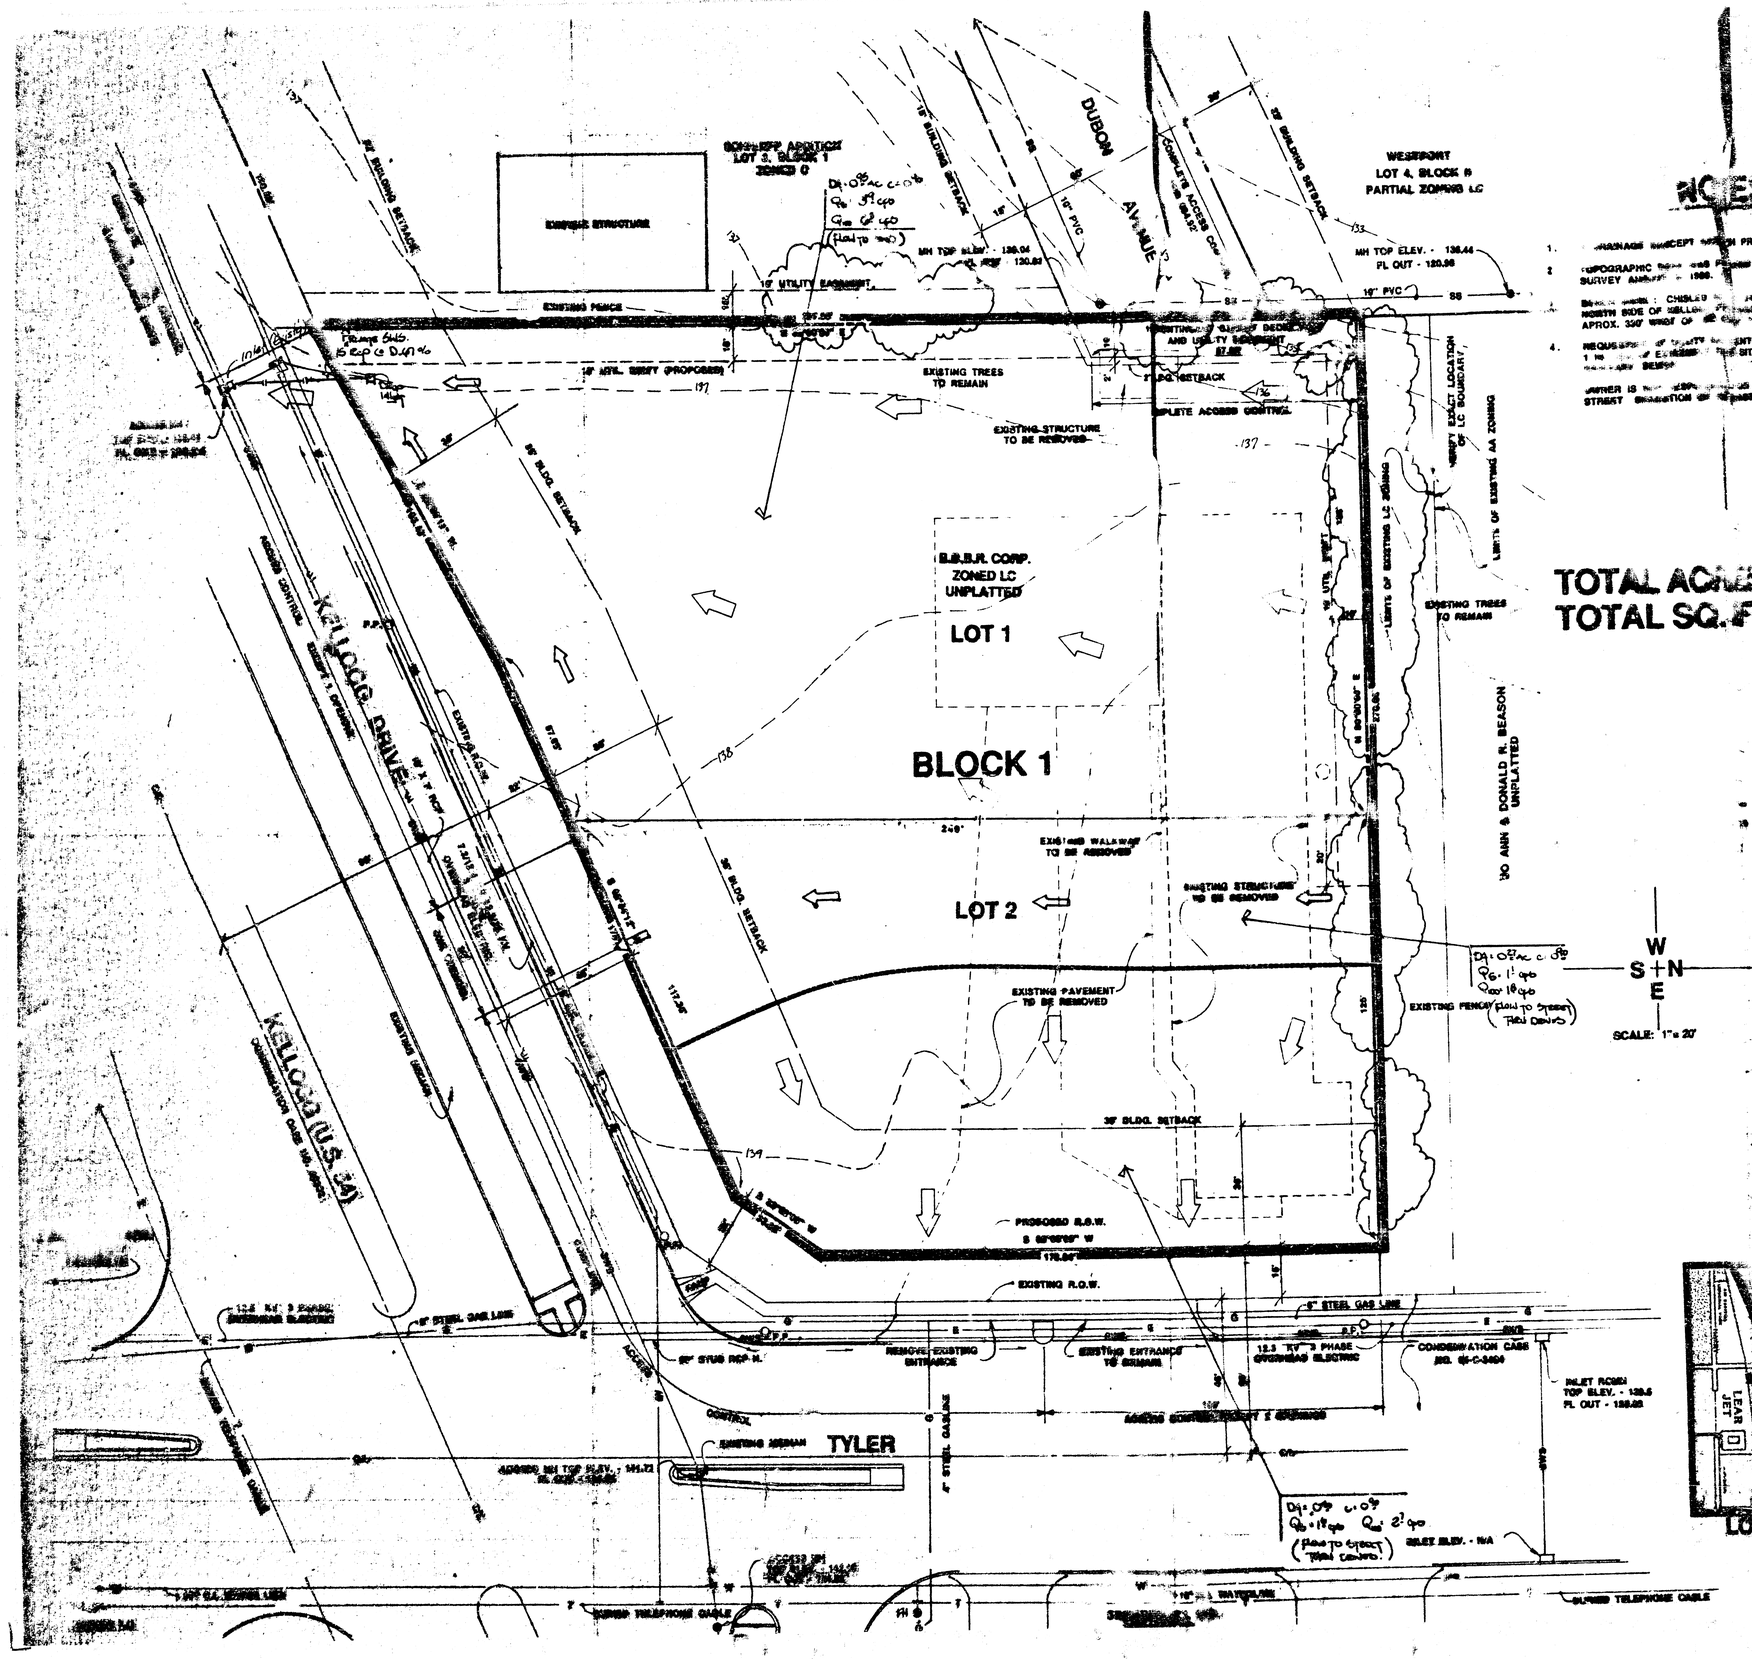
TOTAL ACRES = 1.[illegible]
TOTAL SQ. FT. = [illegible]