


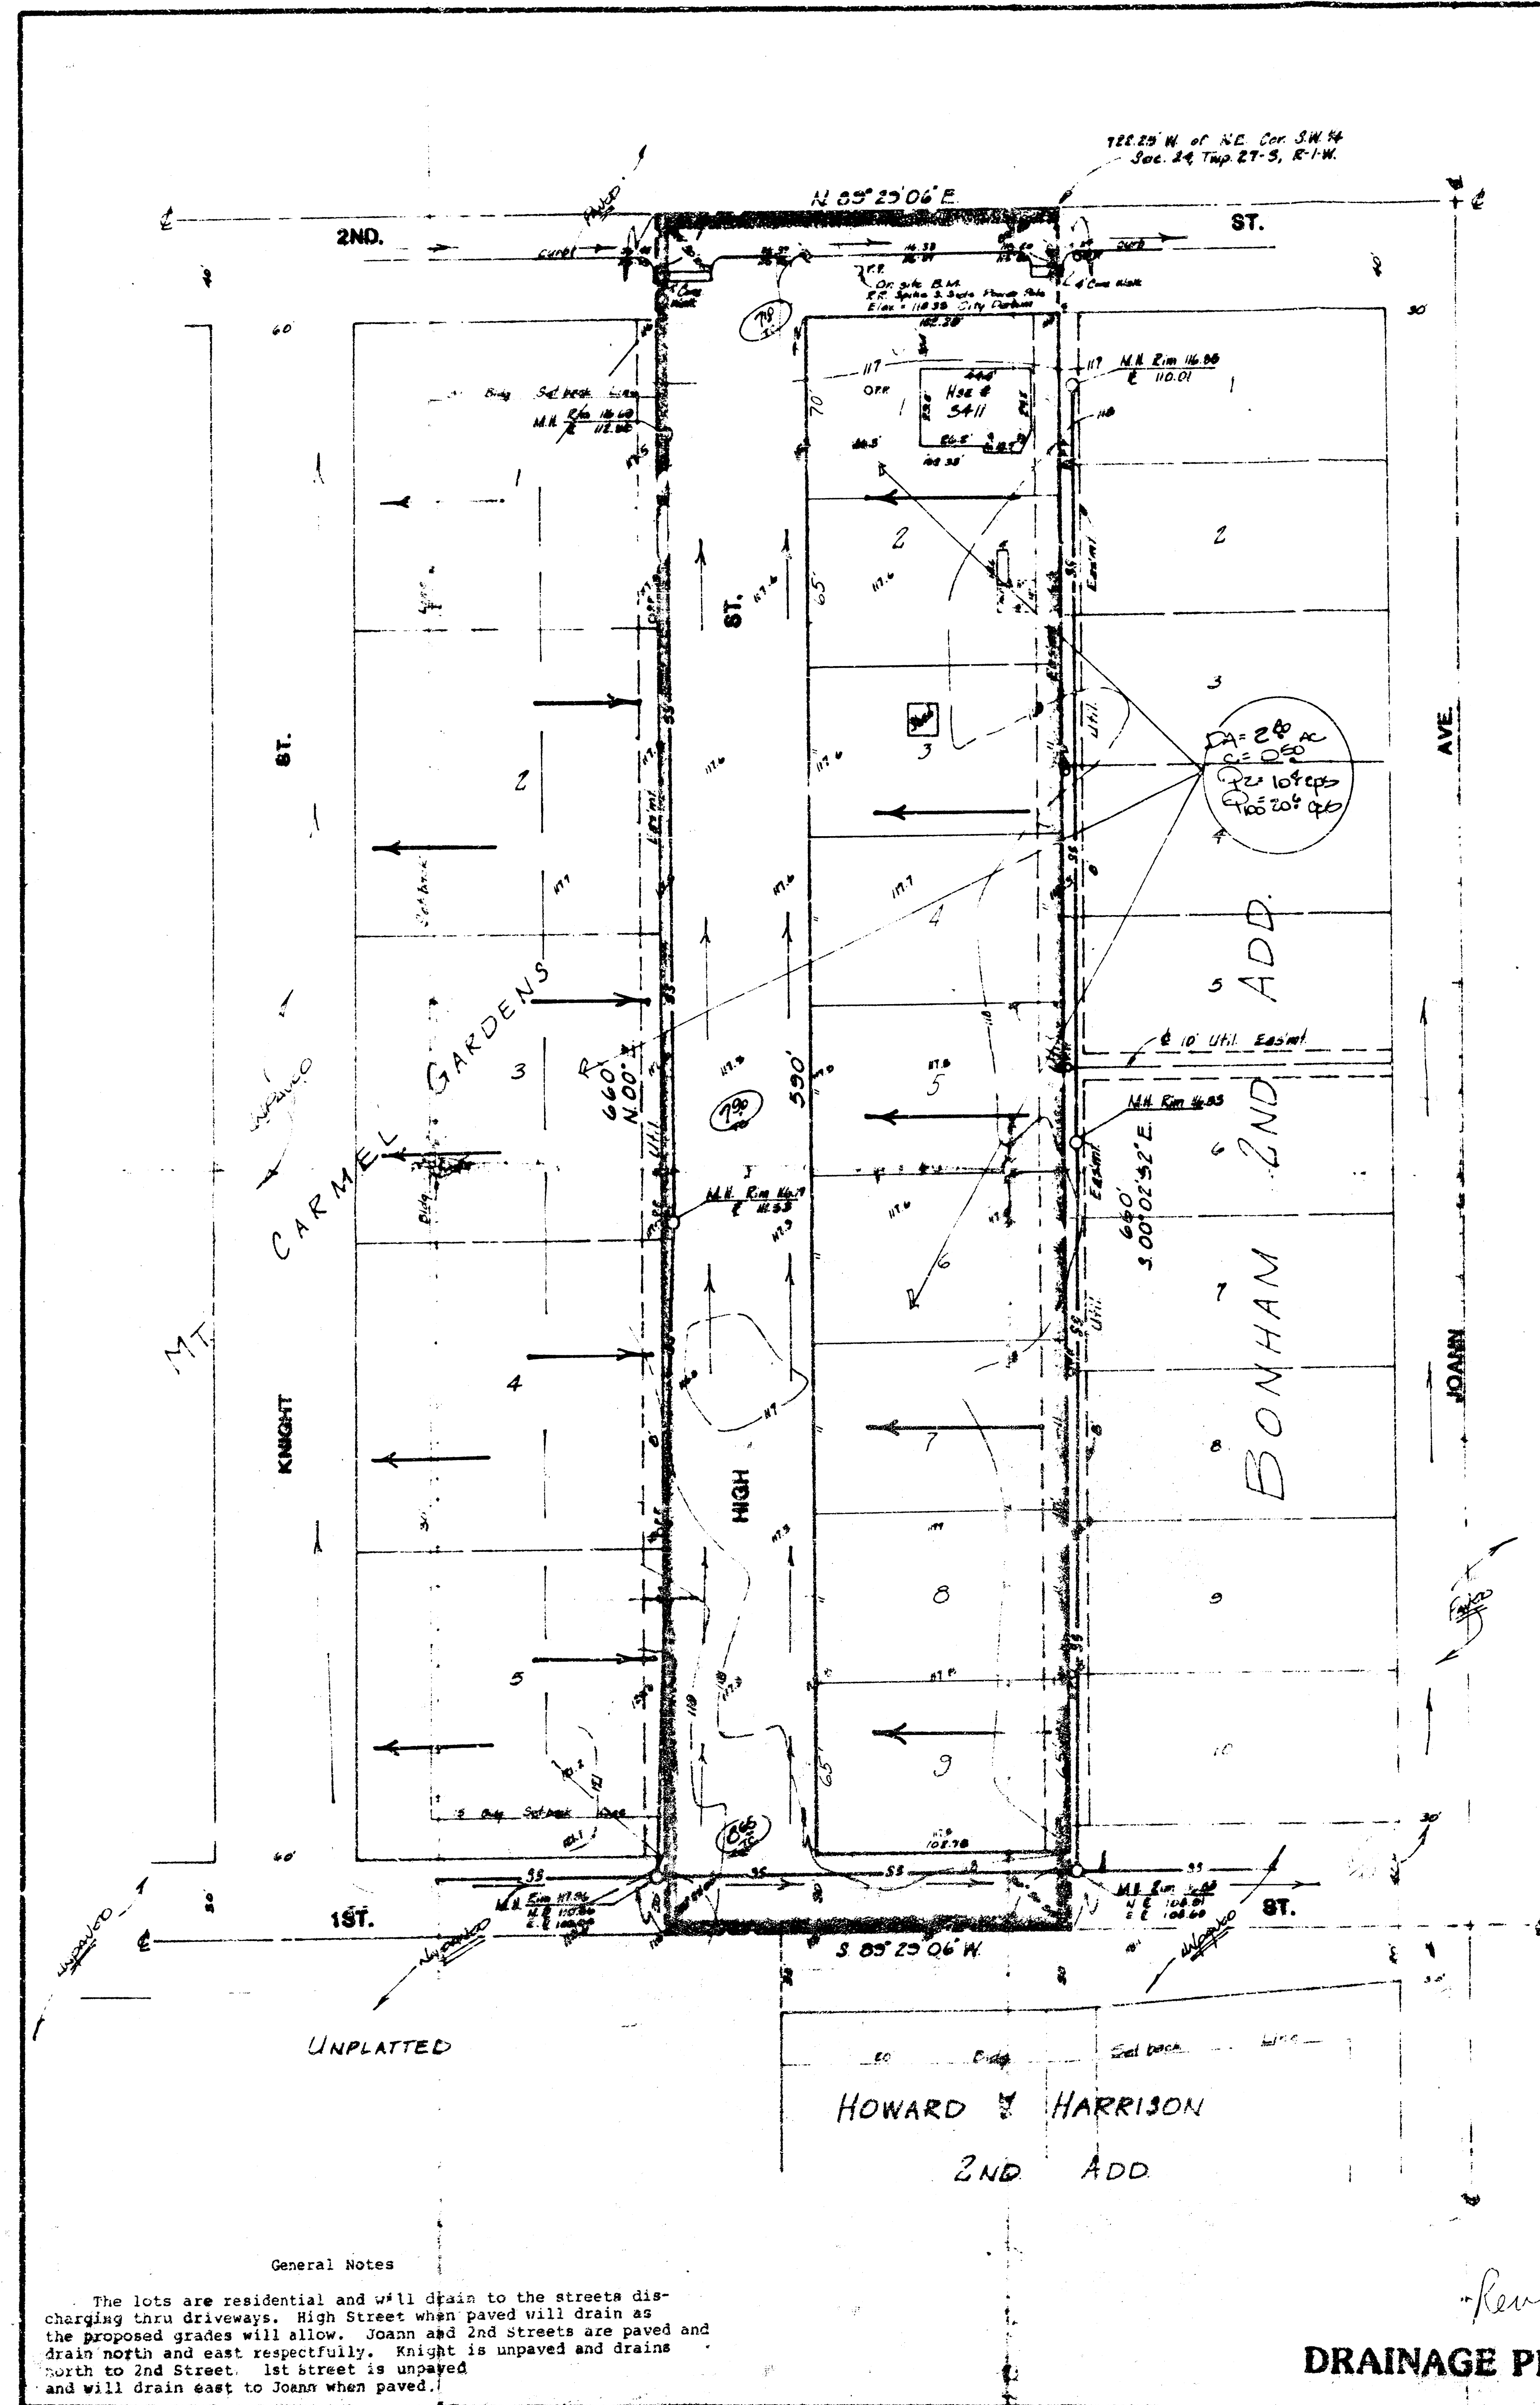

PRELIMINARY PLAT

BADER 3RD ADDITION

PART OF THE S.W. 1/4
SEC. 24, TWP. 27-3, R-1-W.

CEALD BADER



Scale: 1"=40'
Elevation - City Datum

BENCH MARK:
City Standard Disc 34 W
1/8 S of & West St
and 2nd St
Elevation - 116.87 City Datum



VICINITY MAP
1"=200'

BAURMAN COMPANY, P.A.
SURVEYING & ENGINEERING


**FILMED FROM THE BEST
AVAILABLE COPY**

PRELIMINARY PLAT

BADER 3RD ADDITION

PART OF THE S.W. 1/4
SEC. 24, TWP. 27-S, R-1-W W.

GERALD BADER

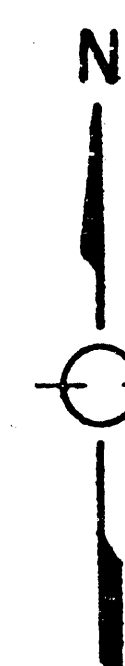


Scale: 1"=40'
Elevation - City Datum

BENCH MARK
City Standard Disc 34 W
110 S of 4 West St
and 2nd S
Elevation - 118.87 City Datum



VERIFICATION BY
1"=200'

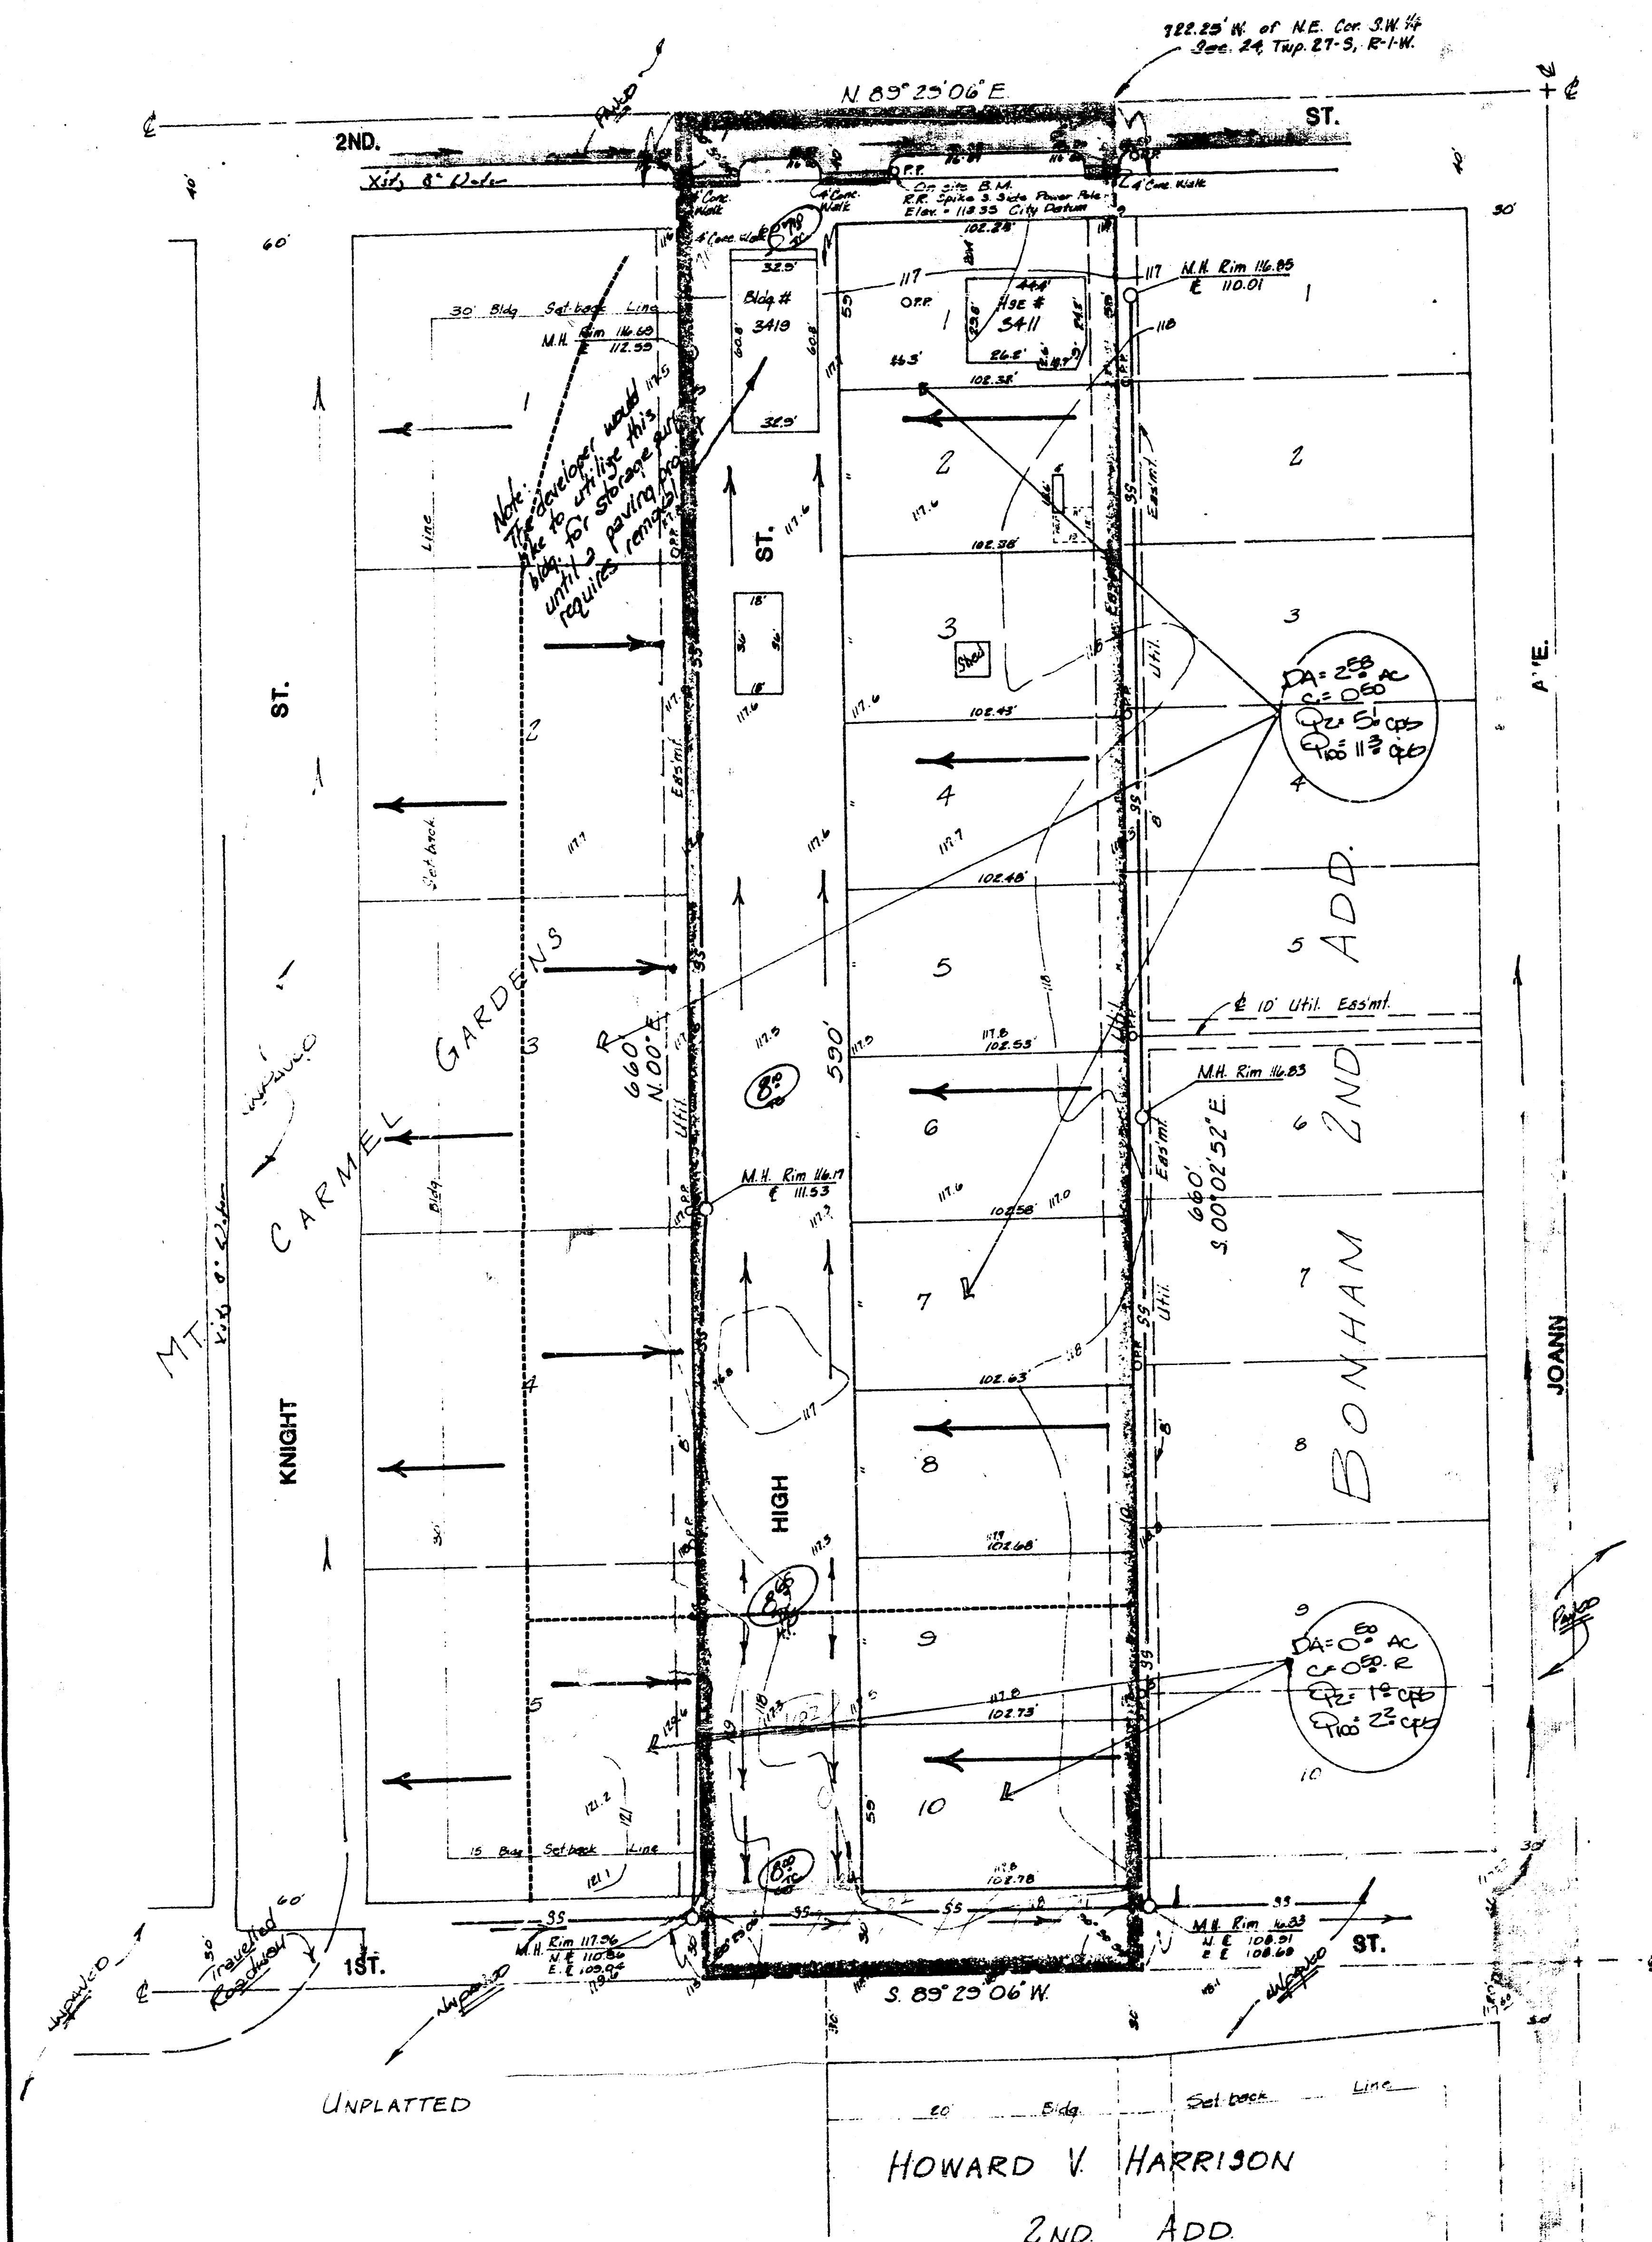

General Notes

The lots are residential and will drain to the streets discharging thru driveways. High Street when paved will drain as the proposed grades will allow. Joann and 2nd Streets are paved and drain north and east respectively. Knight is unpaved and drains north to 2nd Street. 1st Street is unpaved and unopened presently and will drain east to Joann when paved and opened to traffic.

DRAINAGE PLAN

6-10-66

BAUGHMAN COMPANY, P.A.
SURVEYING & ENGINEERING

FILMED FROM THE BEST
AVAILABLE COPY