


1" = 40'
ELEV. = CITY DATUM

BENCH MARK:
SQUARE CORNER ON TOP OF CURB
AT S. END OF CURB RETURN AT
S.W. CORNER OF DOUGLAS AND
TYLER
ELEV. = 142.75 CITY DATUM

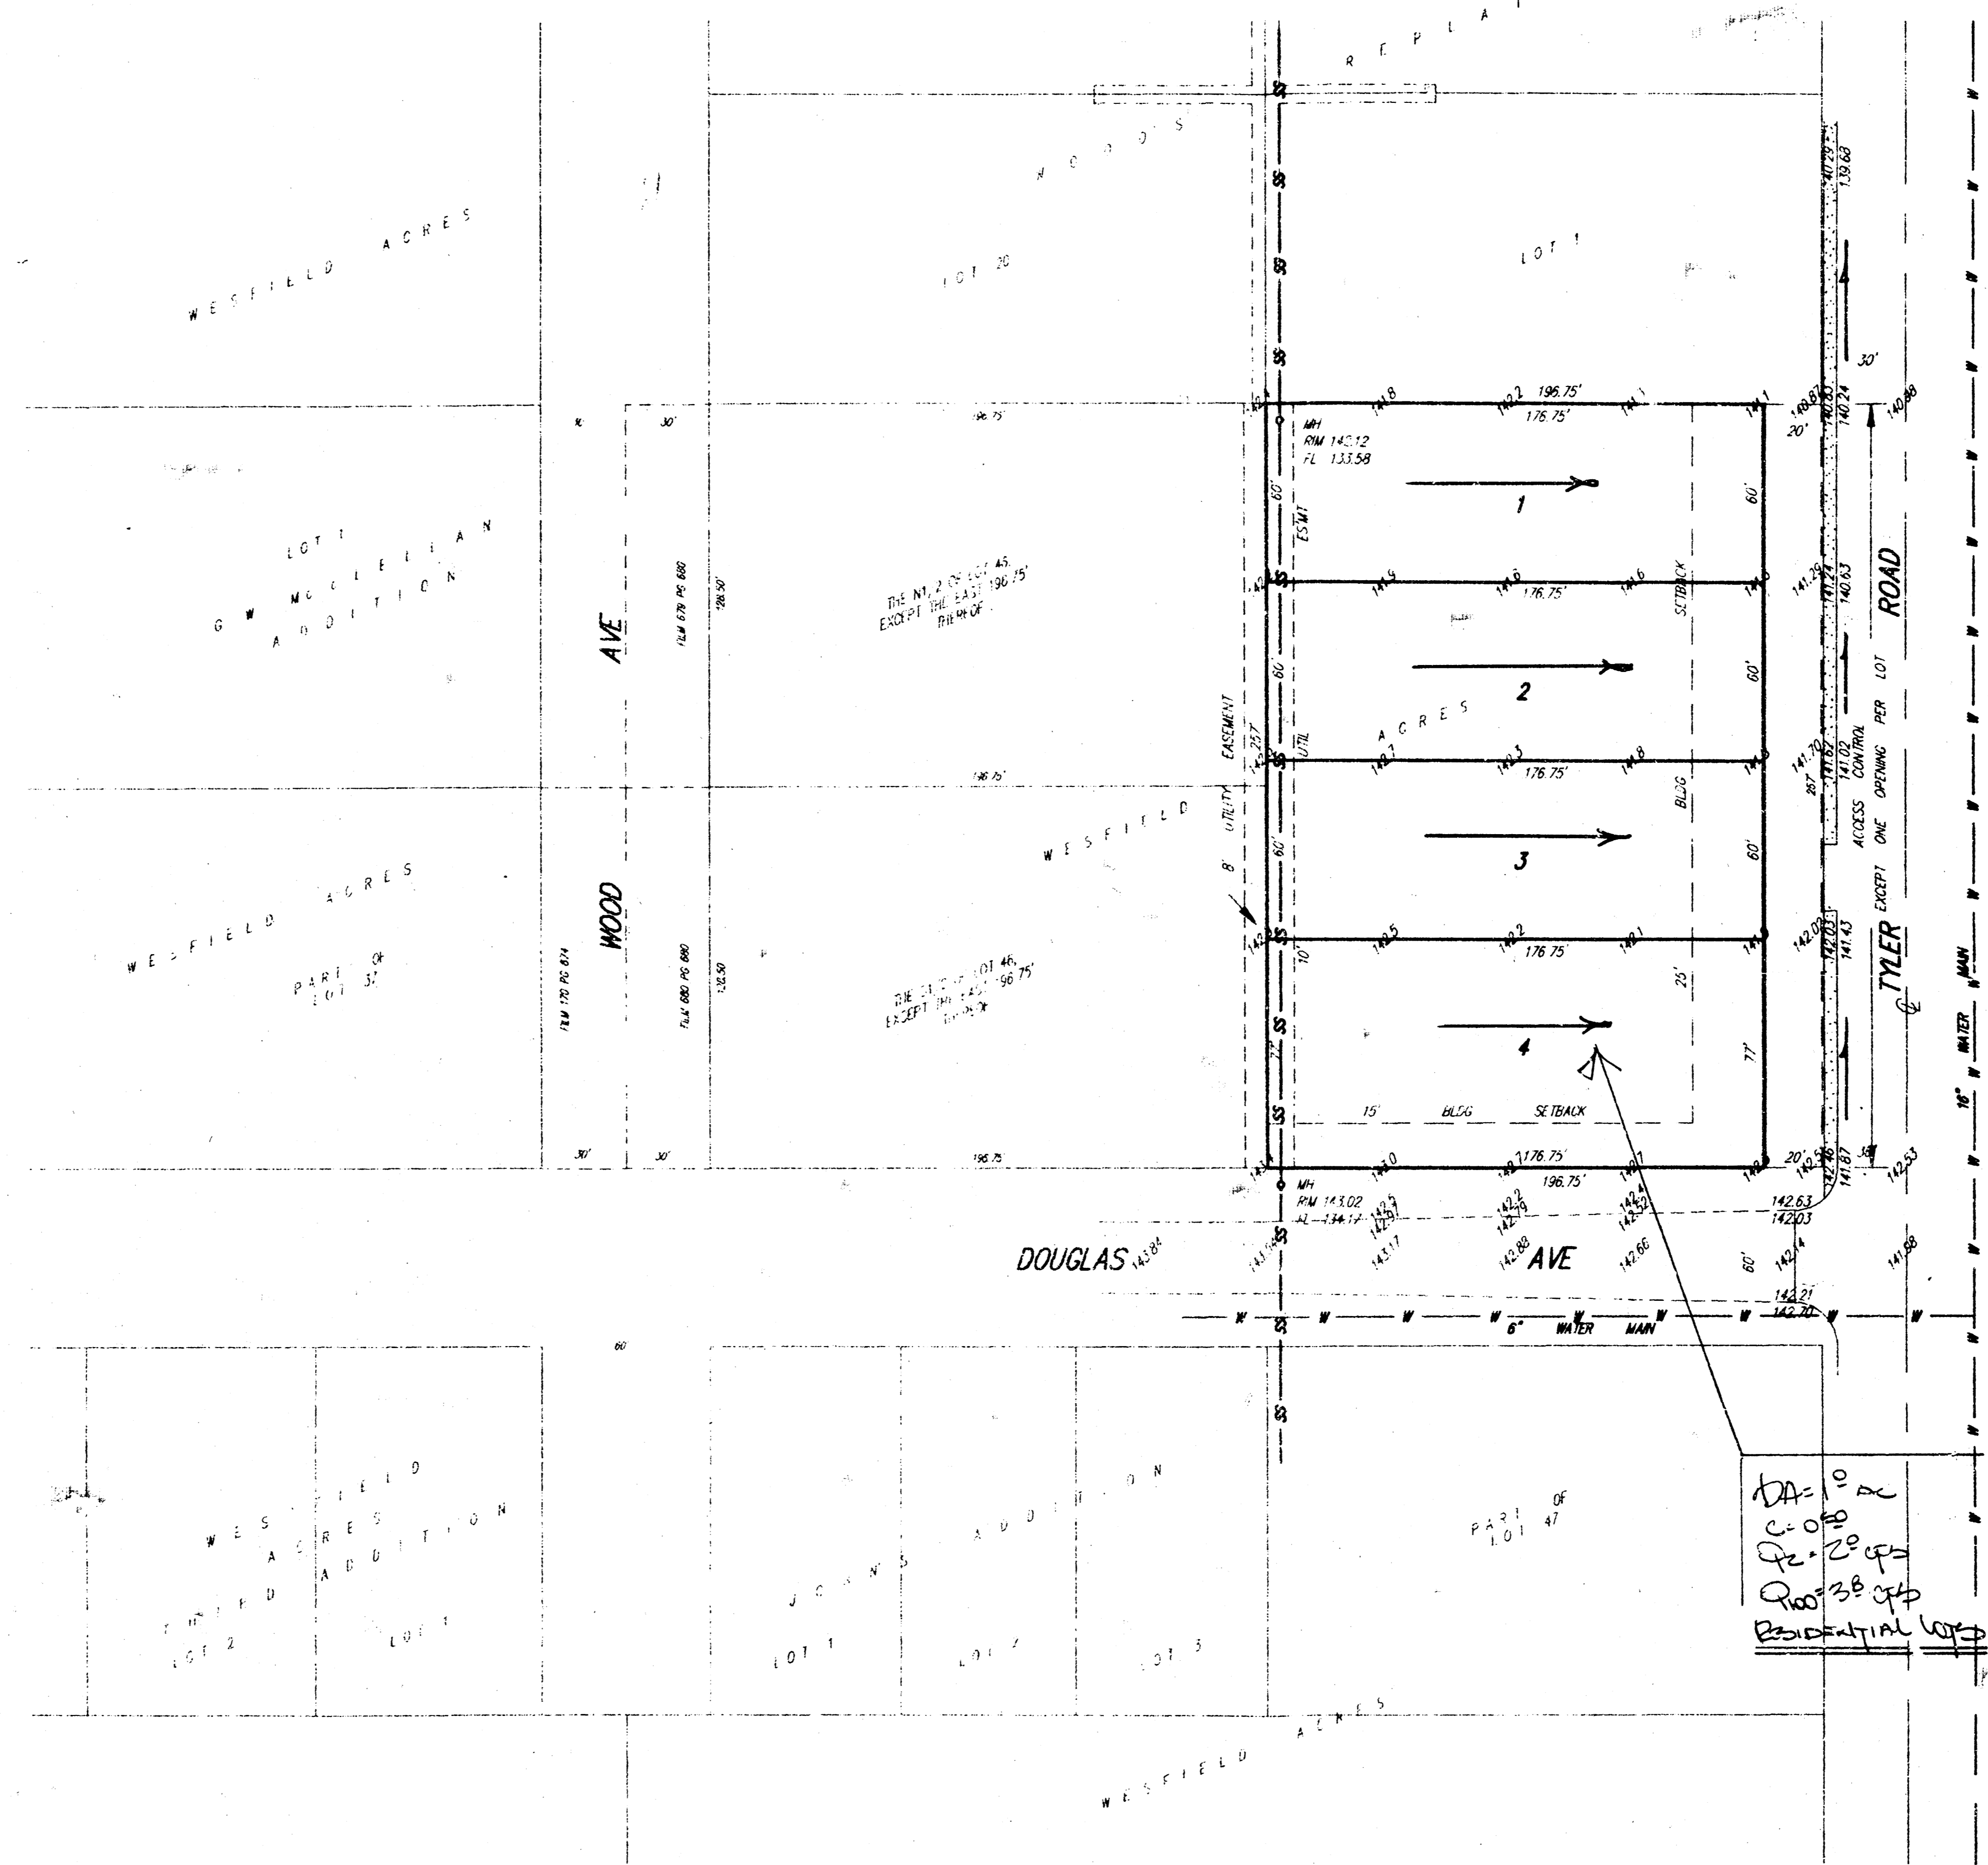

DA 10
C-050
P-20
RESIDENTIAL LOT

SKETCH PLAT

R. BEARD ADDITION

WICHITA, SEDGWICK COUNTY, KANSAS

THE EAST 196.75 FEET OF LOT 46,
WESTFIELD ACRES, SEDGWICK COUNTY,
KANSAS.

RONNIE BEARD
7817 W. NANTUCKET
WICHITA, KS 67212
PH. 722-4894

DRAINAGE PLAN

BAUGHMAN COMPANY P. A.
SURVEYING & ENGINEERING
316/282-7271 • 315 ELLIS • WICHITA, KANSAS 67211

1 SEP 92