


betts

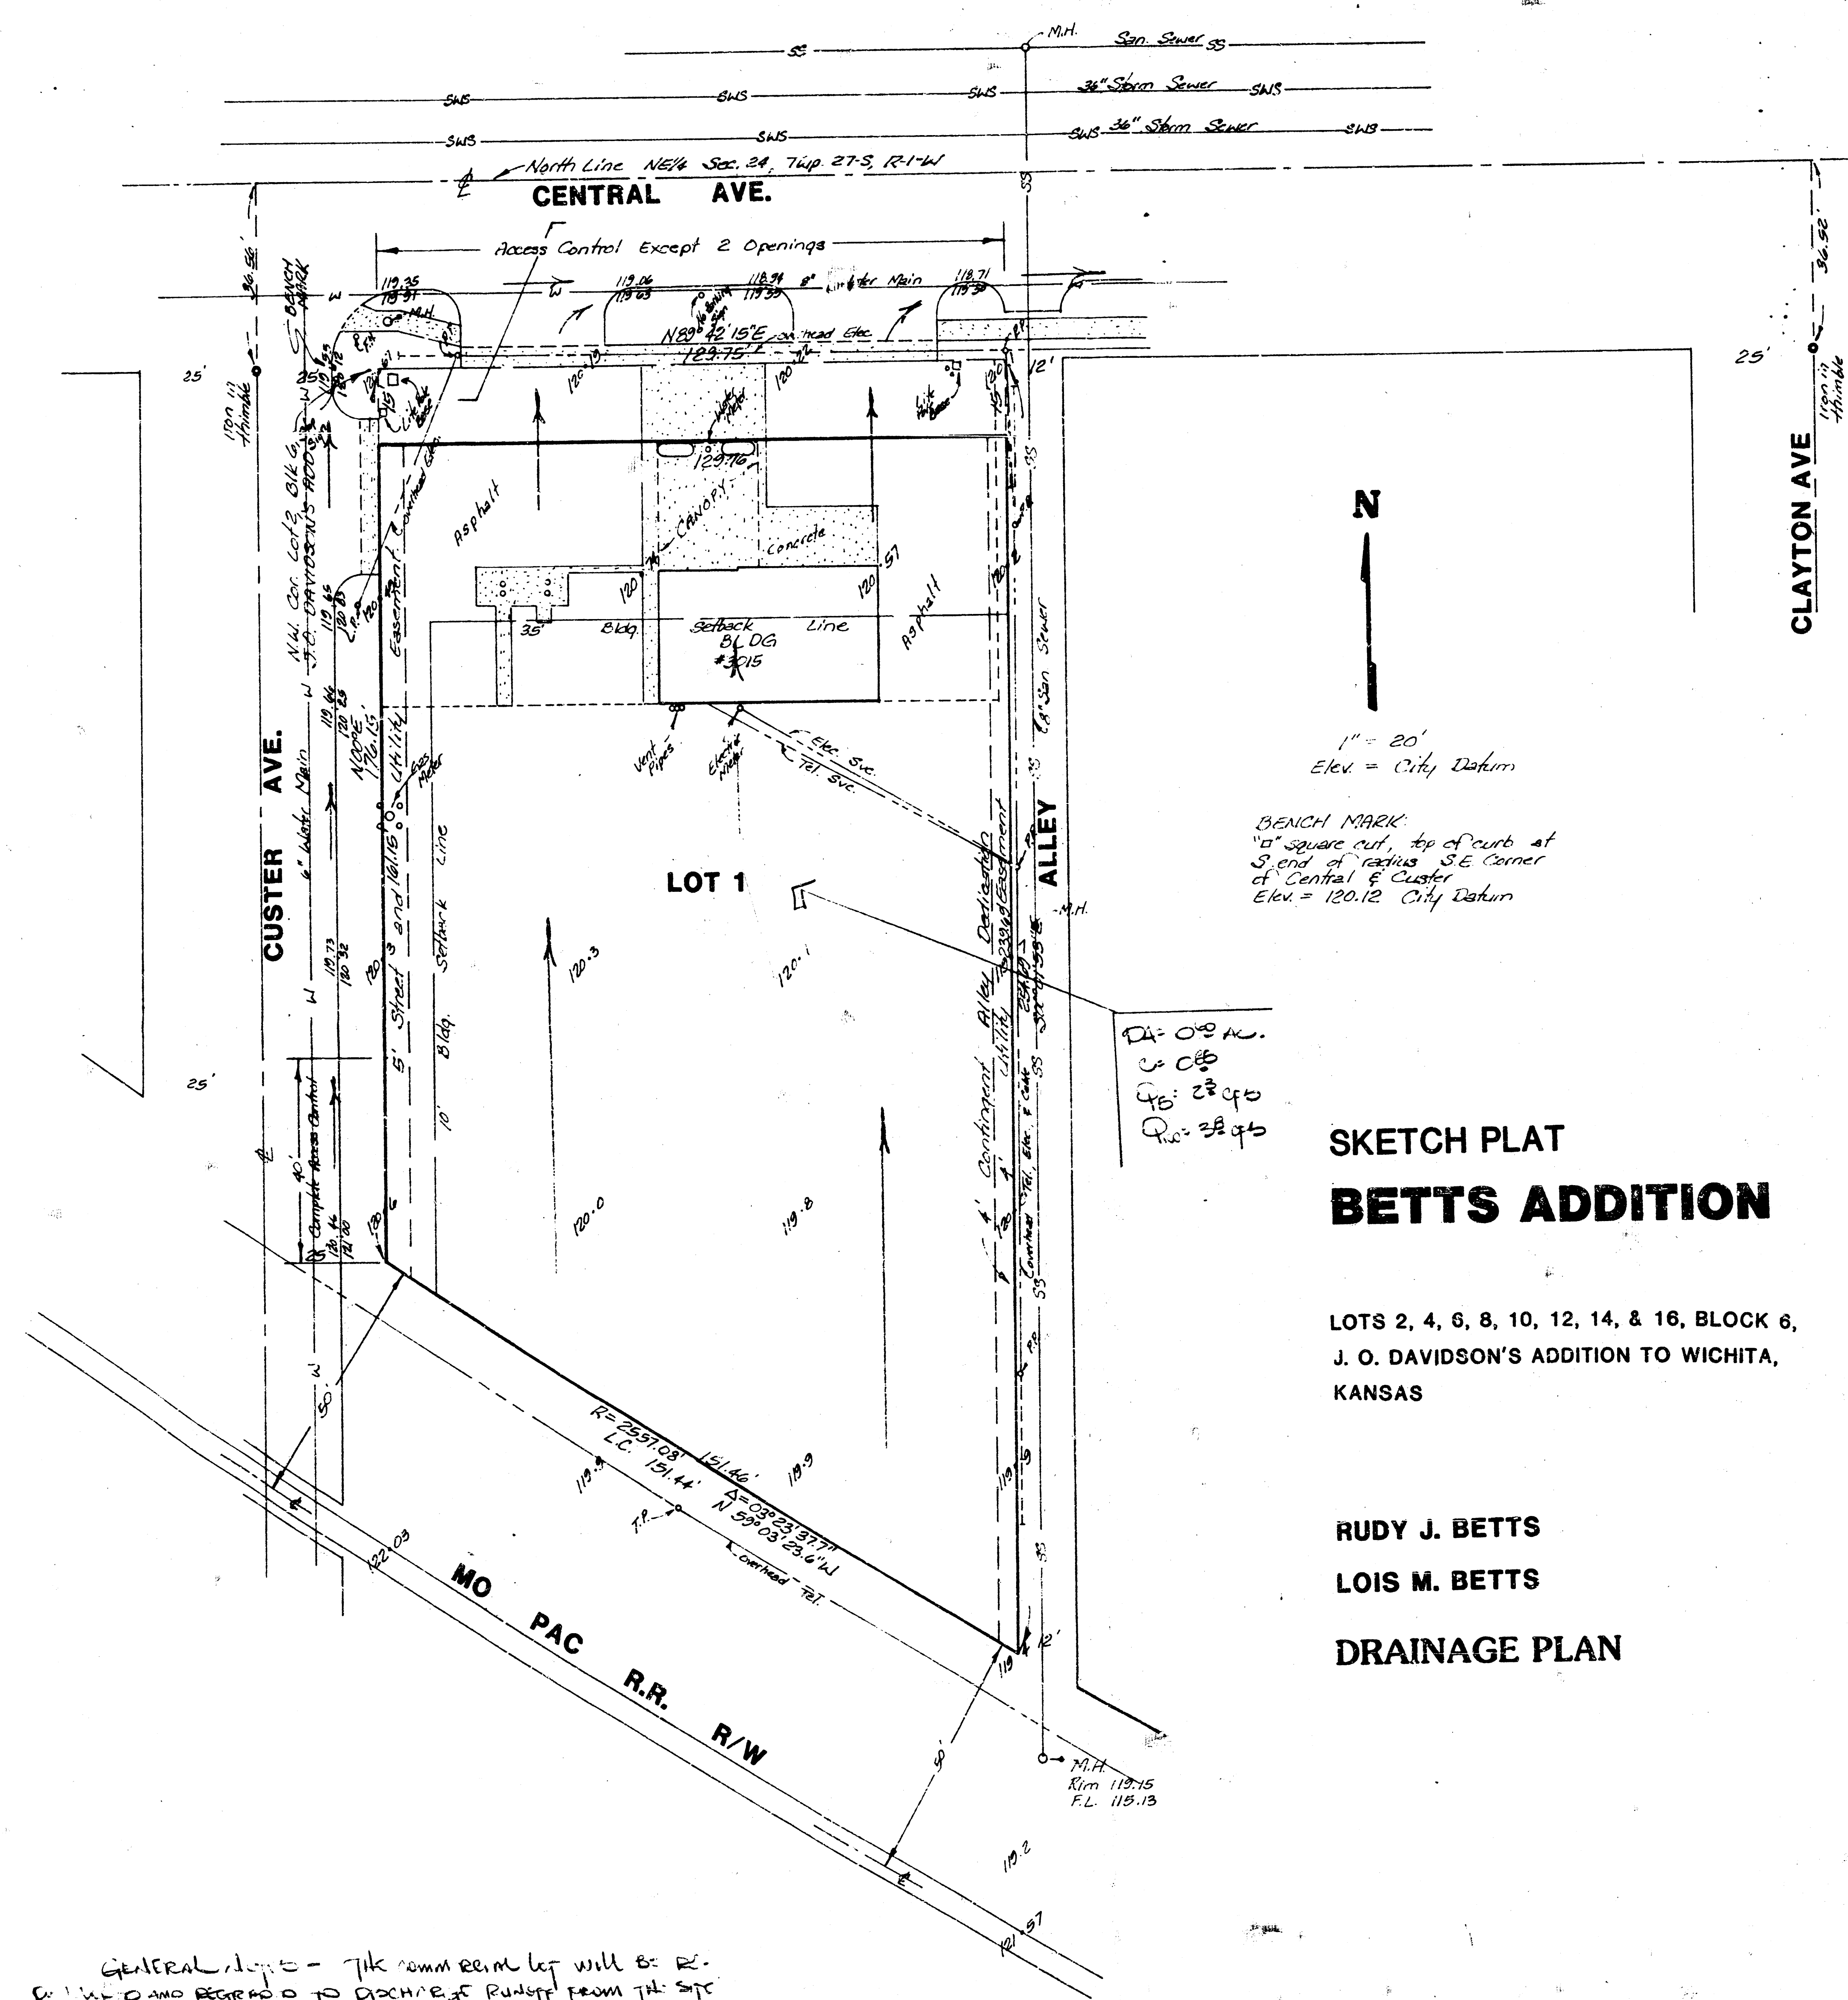

SKETCH PLAT
BETTS ADDITION

LOTS 2, 4, 6, 8, 10, 12, 14, & 16, BLOCK 6,
J. O. DAVIDSON'S ADDITION TO WICHITA,
KANSAS

RUDY J. BETTS
LOIS M. BETTS
DRAINAGE PLAN

