


BRAMMER ADDITION
(Drainage)

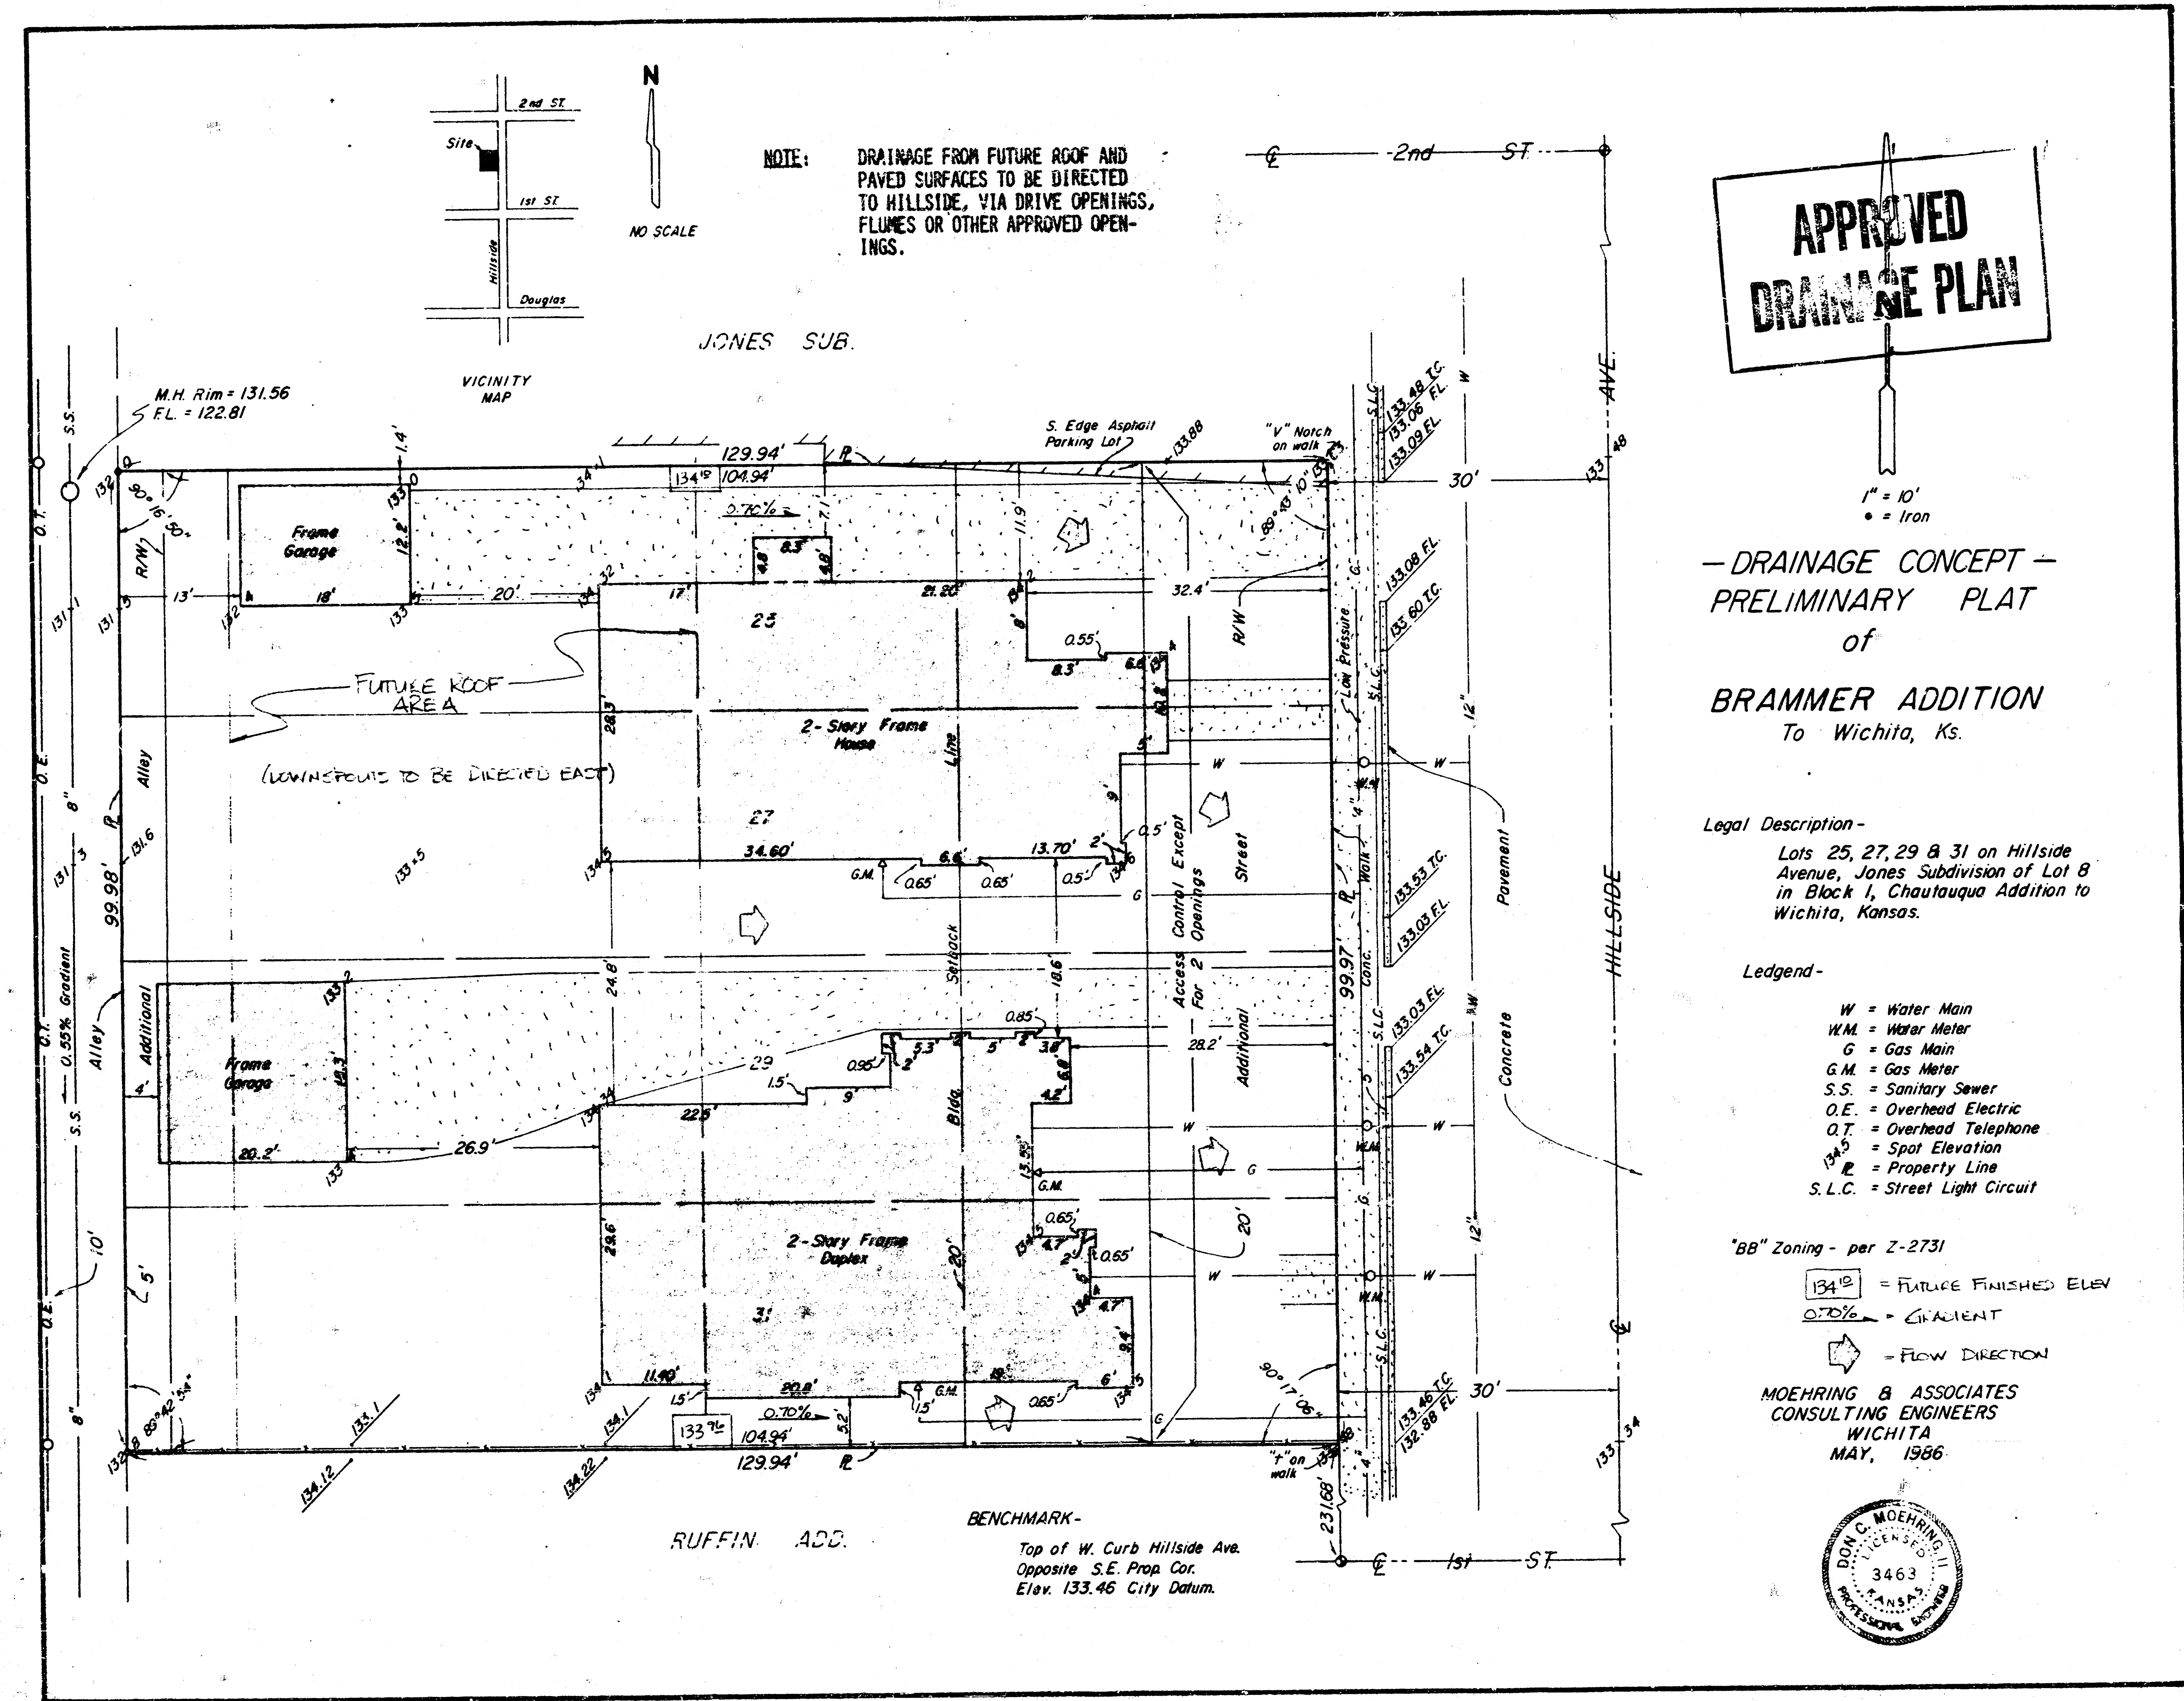

**APPROVED
DRAINAGE PLAN**

1" = 10'
• = Iron

— DRAINAGE CONCEPT —
PRELIMINARY PLAT
of
BRAMMER ADDITION
To Wichita, Ks.

Legal Description -
Lots 25, 27, 29 & 31 on Hillside
Avenue, Jones Subdivision of Lot 8
in Block 1, Chautauqua Addition to
Wichita, Kansas.

- Ledgend -
- W = Water Main
 - WM = Water Meter
 - G = Gas Main
 - GM = Gas Meter
 - S.S. = Sanitary Sewer
 - O.E. = Overhead Electric
 - O.T. = Overhead Telephone
 - Spot Elevation
 - P.L. = Property Line
 - S.L.C. = Street Light Circuit

"BB" Zoning - per Z-2731

134.10 = FUTURE FINISHED ELEV

0.70% = GRADIENT

→ = FLOW DIRECTION

MOEHRING & ASSOCIATES
CONSULTING ENGINEERS
WICHITA
MAY, 1986

