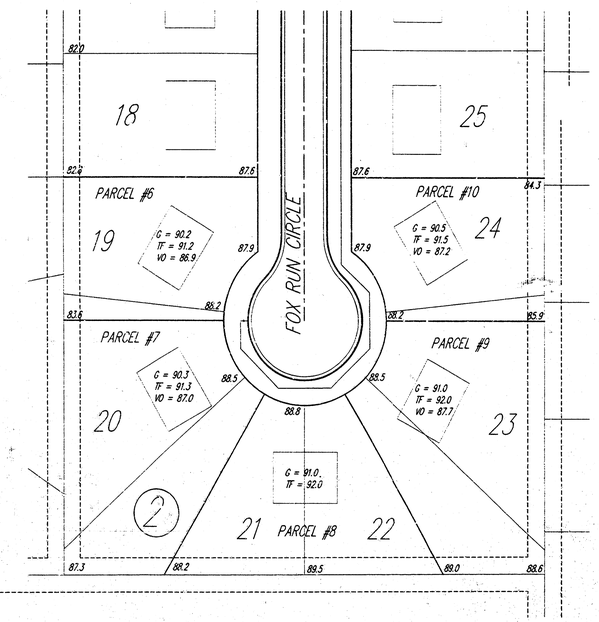

APPROVED
DRAINAGE PLAN

BRENTWOOD VILLAGE

REVISED LOT GRADING PLAN
PART OF BLOCK 2 – BRENTWOOD VILLAGE ADDITION

SRB
SAVOY, RUGGLES & BOHM, P.A.
ENGINEERING & SURVEYING

REVISED, N OCI 6 NOV 2000