


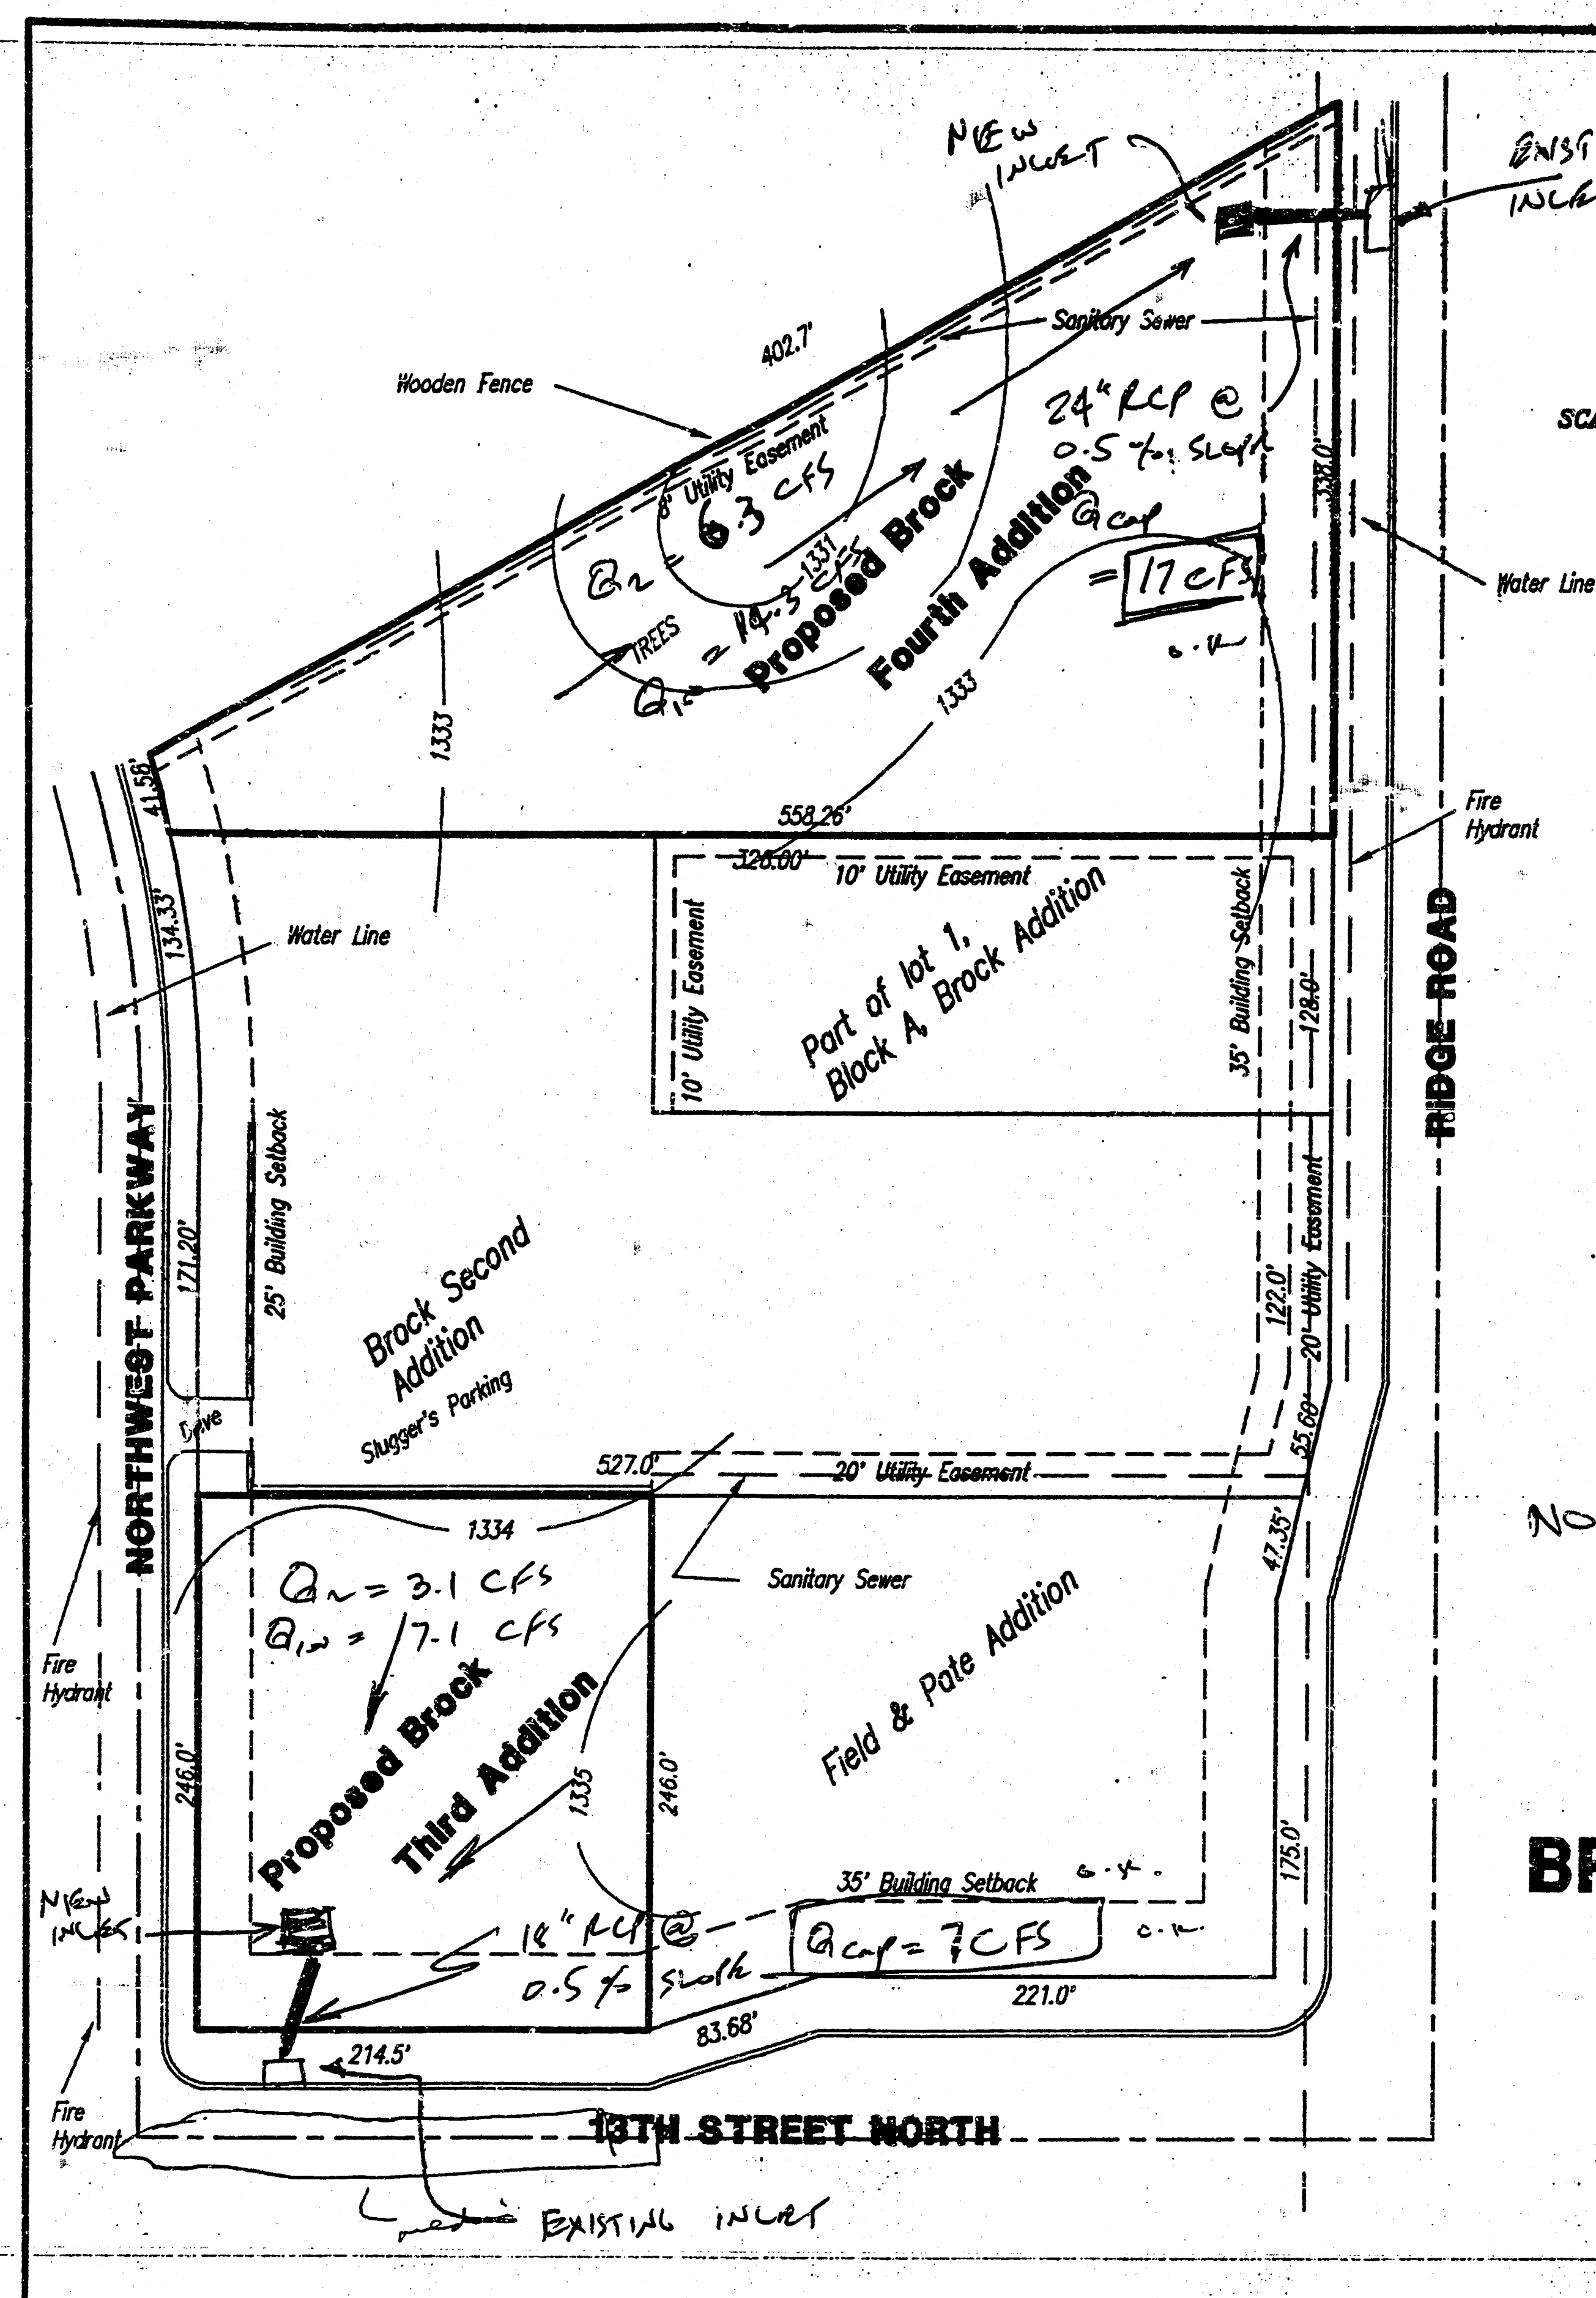

LAND USE = BUSINESS (MERCANTILE ROAD)

$$C_2 = 0.68$$

$$C_{100} = 0.80$$

$$USE T_c = 15 \text{ MIN.}$$

$$L_2 = 3.83$$

$$L_{100} = 7.37$$

BROCK THIRD ADDITION:

Area = 1.21 Acres
Zoning = LC

BROCK FOURTH ADDITION:

Area = 2.43 Acres
Zoning = LC

OWNER:

Police Properties, LLC
243 Portlock Road
Honolulu, HI 96825

SURVEYOR/ENGINEER:


Babar M. Khan
Municipal Engineers, P.A.
254-Laura, Suite 201
Wichita, Kansas 67211

NOTE: STORM RETAINAGE MAY BE PROVIDED IN PARKING LOTS UPON DETAILED DRAINAGE ANALYSIS.

DRAINAGE CALCULATIONS

VICINITY MAP

**BROCK THIRD & FOURTH ADDITION
TO
WICHITA
SEDGWICK COUNTY, KANSAS**

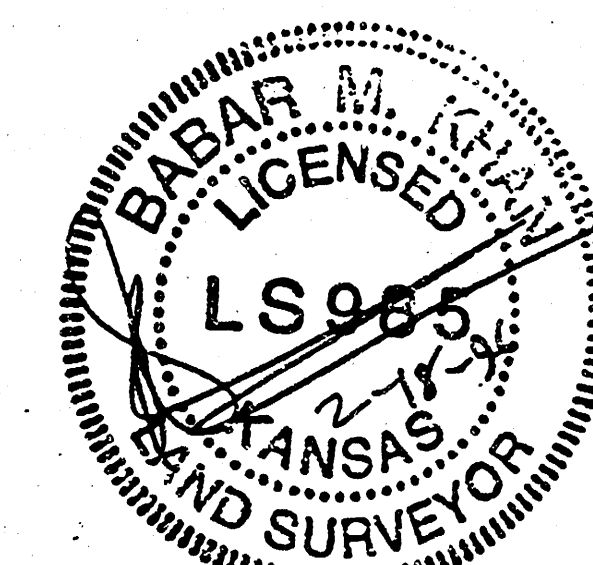

MUNICIPAL ENGINEERS, P.A.
254-Laura, Suite 201
Wichita, Kansas 67211
316-262-3642