
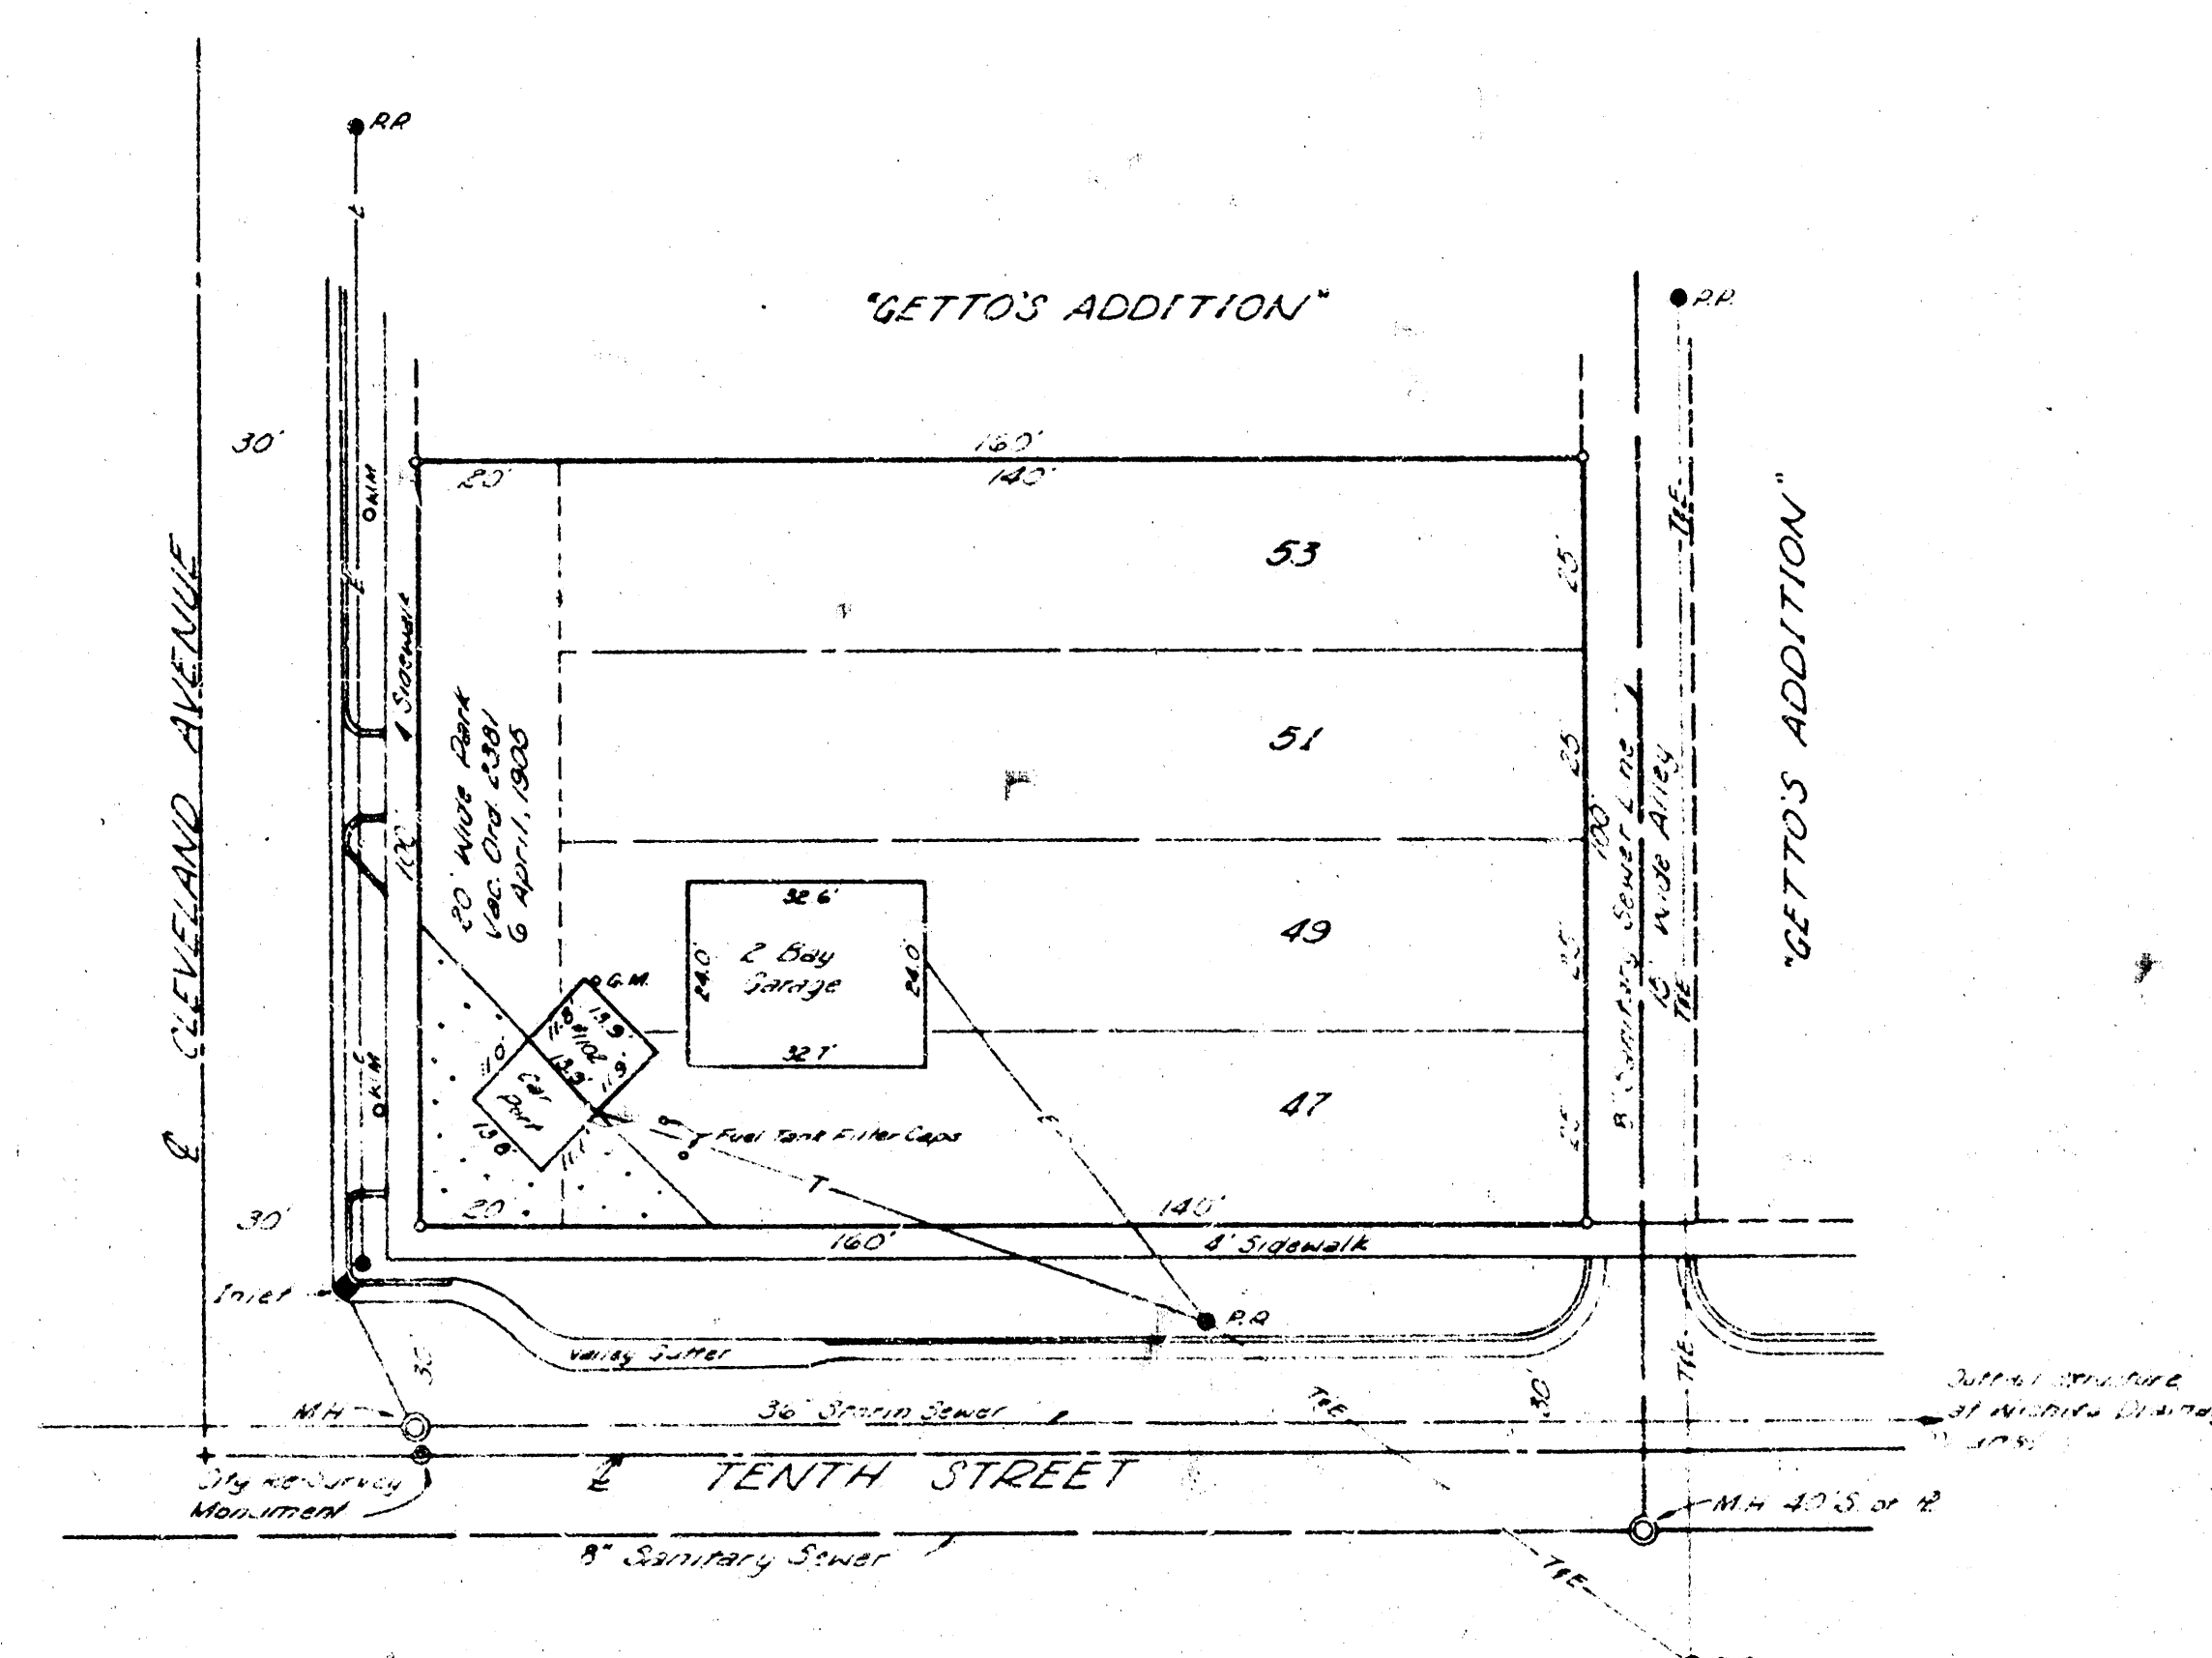


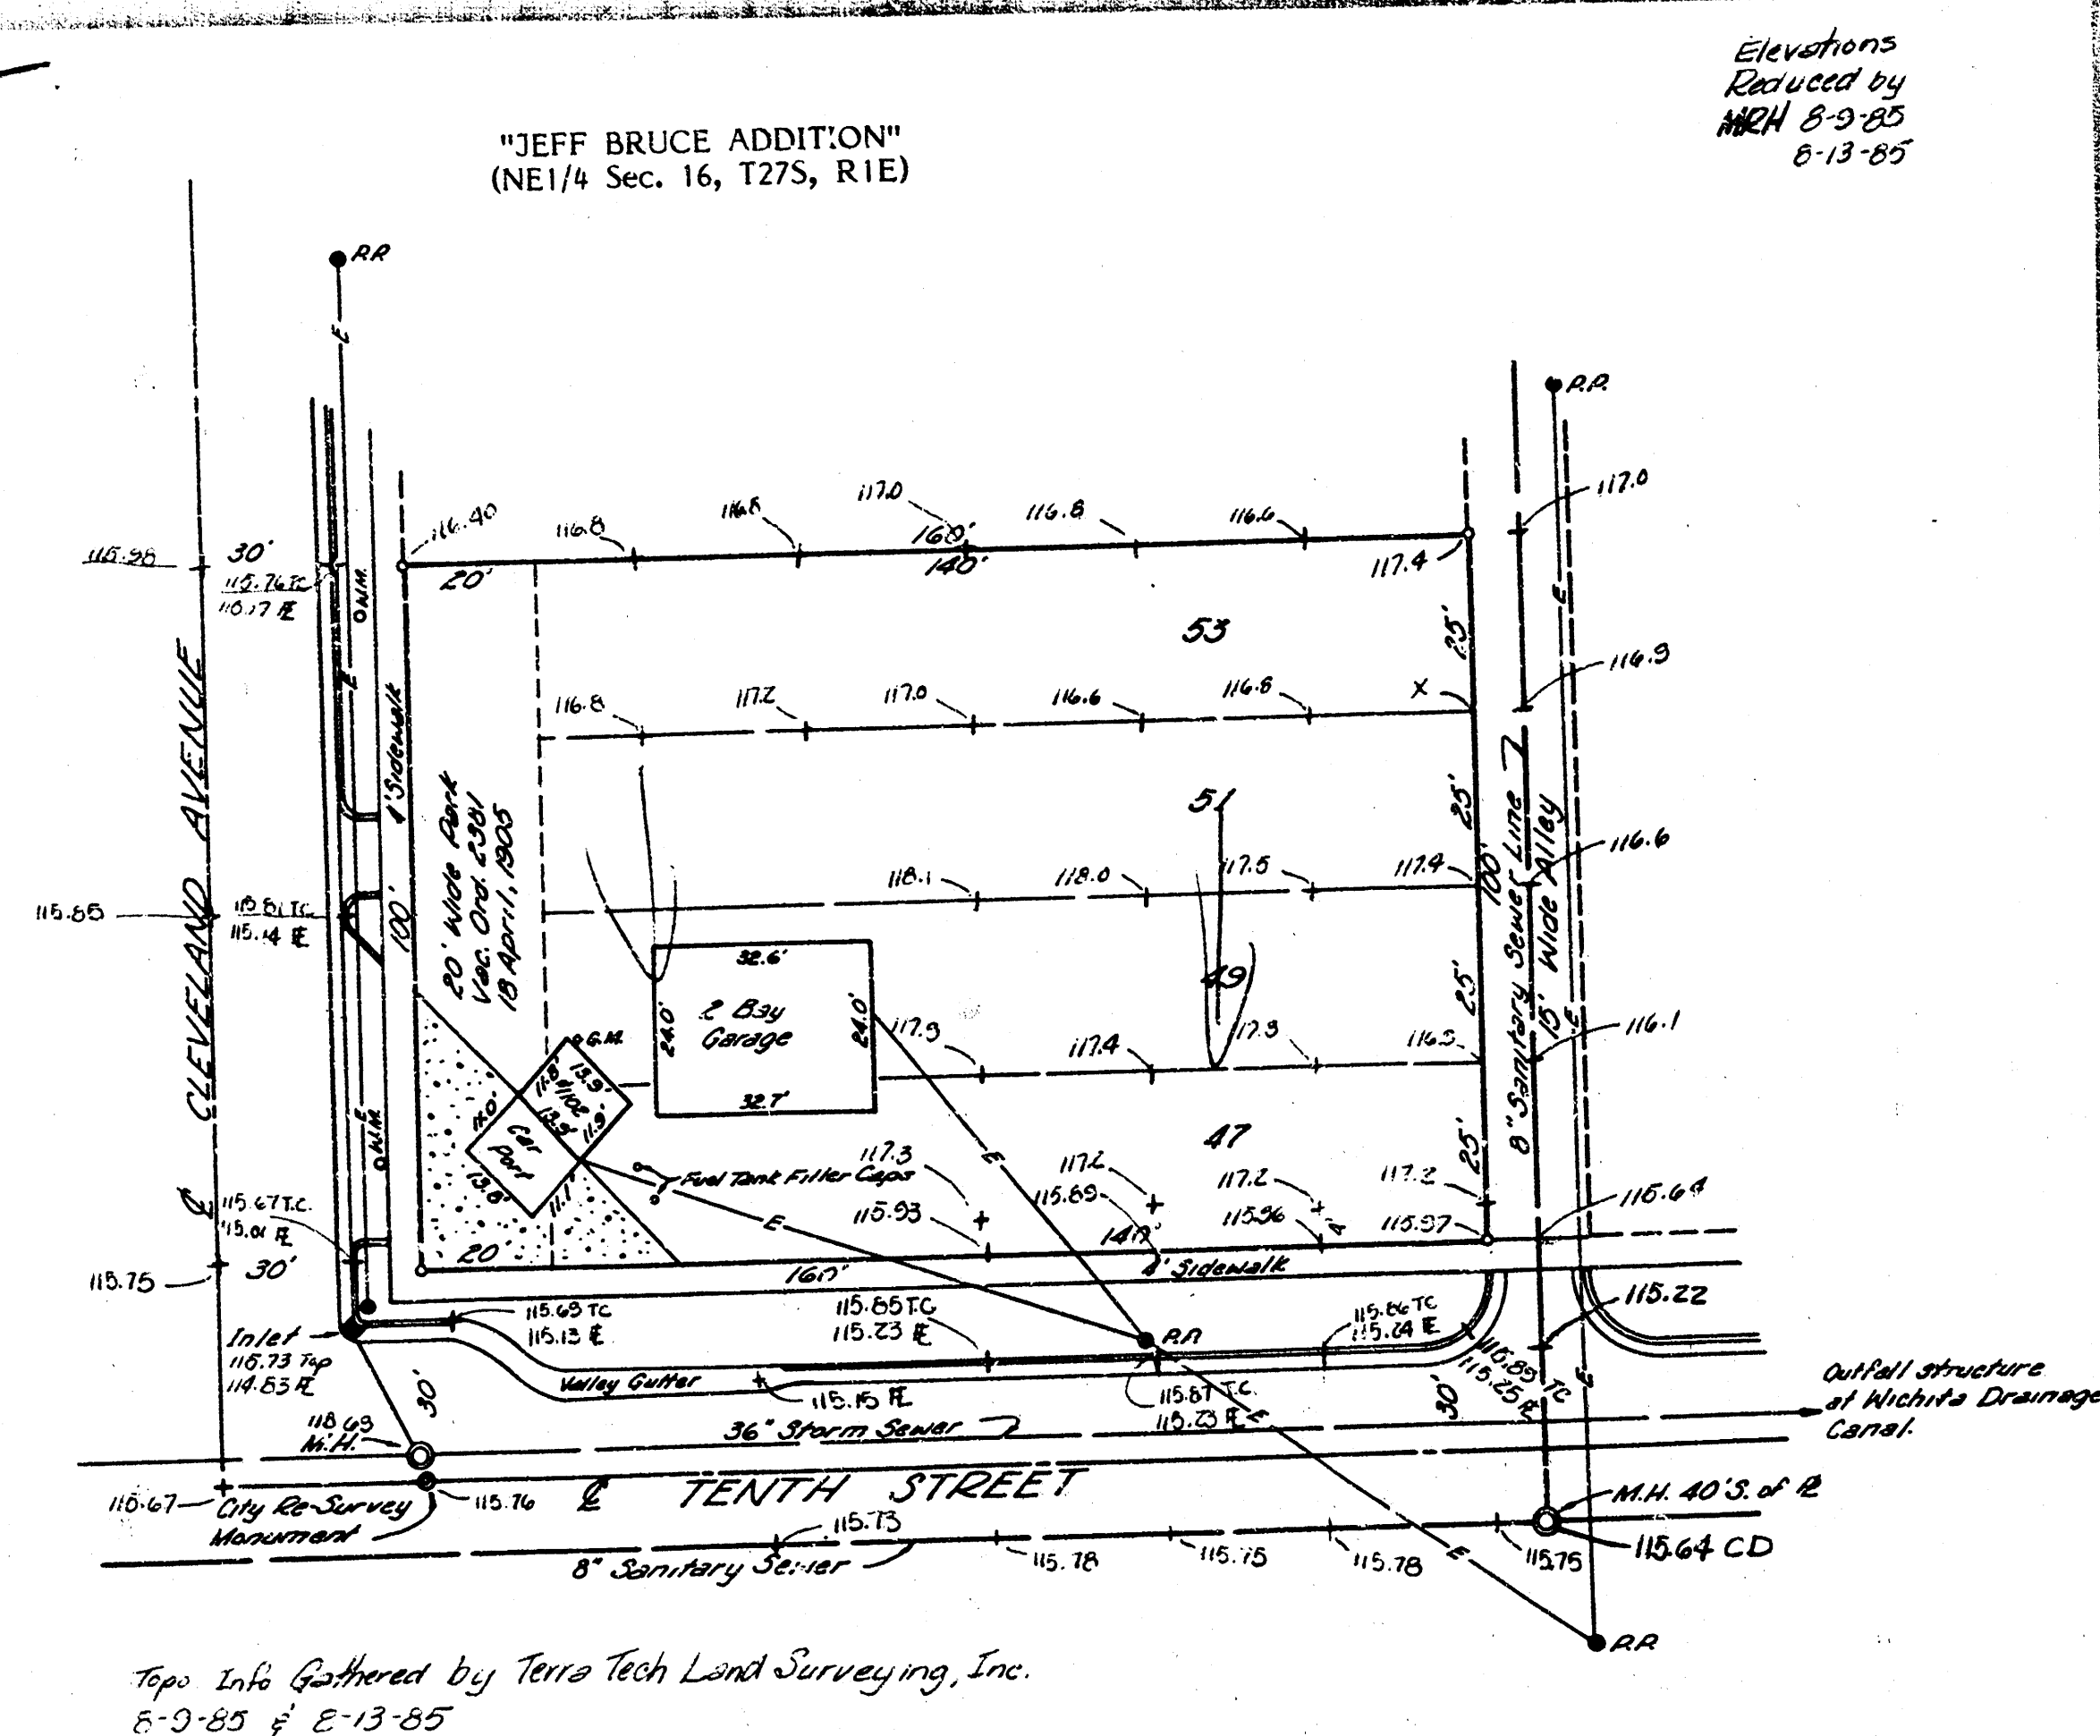

TERRA TECH
LAND SURVEYING INC.

245 West Dewey
Wichita, Kansas 67202-3607
(316) 267-0744 / 267-2348

FILMED FROM THE BEST
AVAILABLE COPY.....