FILMED FROM THE BEST AVAILABLE COPY

BULGER ADDITION (Drainage)

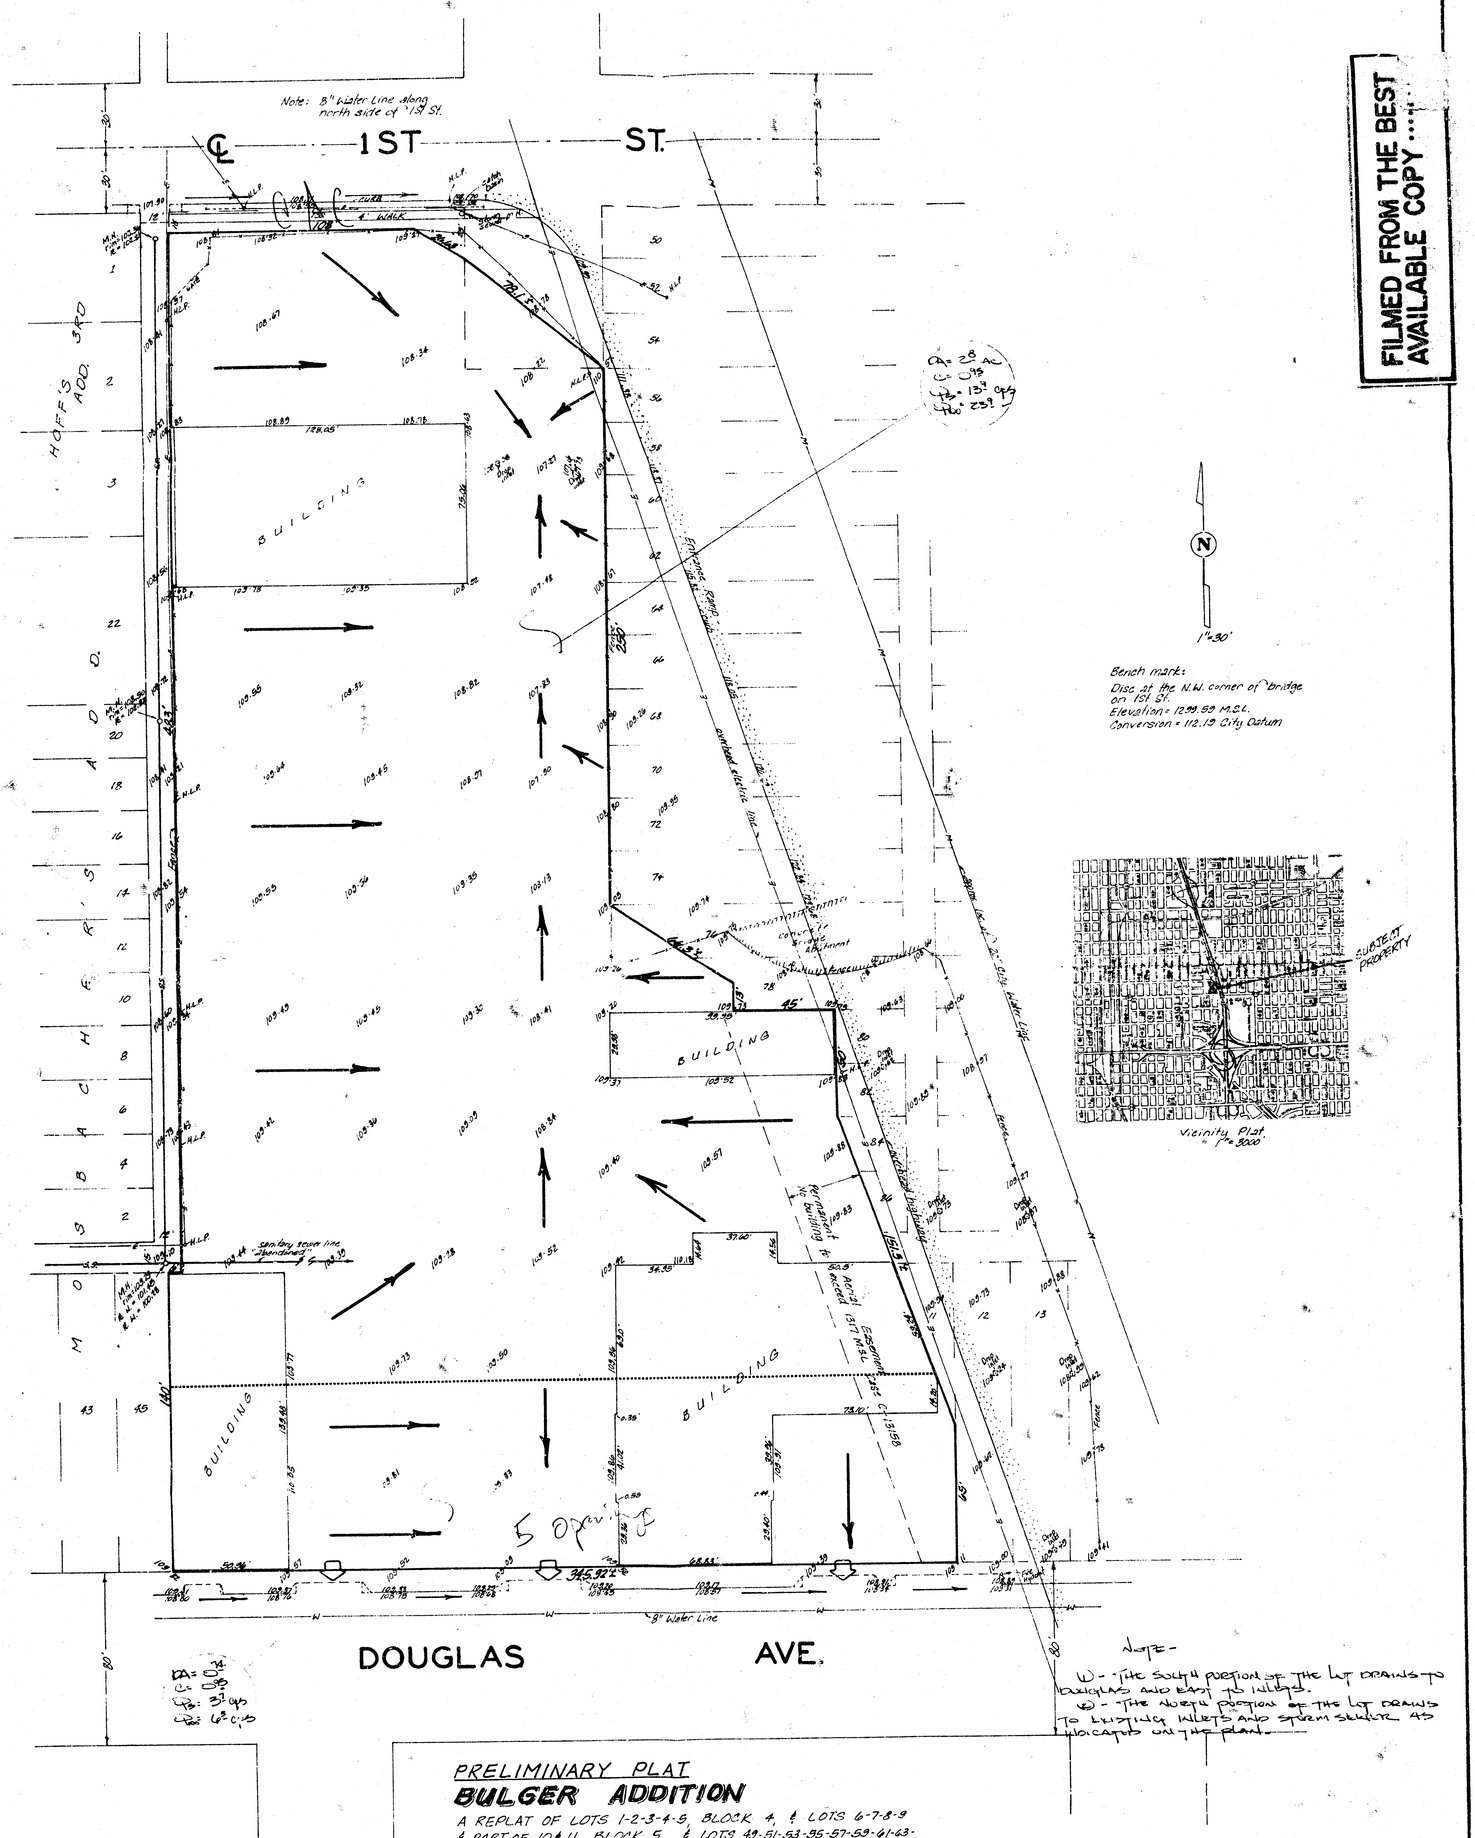

NOTE -

(1) - THE SOUTH PORTION OF THE LOT DRAINS TO DOUGLAS AND EAST TO INLETS.

(2) - THE NORTH PORTION OF THE LOT DRAINS TO EXISTING INLETS AND STORM SEWER AS INDICATED ON THE PLAN.

PRELIMINARY PLAT

BULGER ADDITION

A REPLAT OF LOTS 1-2-3-4-5, BLOCK 4, & LOTS 6-7-8-9 & PART OF 10 & 11, BLOCK 5, & LOTS 49-51-53-55-57-59-61-63-65-67-69-71-73-75-77-79-81-83-85, BLOCK 4, & PART OF LOTS 76-78-80-82-84-86, BLOCK 5, & VACATED MINNEAPOLIS AVE & ALLEYS ALL IN MINNEAPOLIS ADDITION TO WICHITA, SEDGWICK COUNTY, KANSAS.

OWNER: JOSEPH A. BULGER

FINAL DRAINAGE PLAN

4/6/84

BAUGHMAN COMPANY, P.A.
SURVEYING & ENGINEERING
316/262-7271 • 330 LAURA • WICHITA, KANSAS 67211