


drainage plan

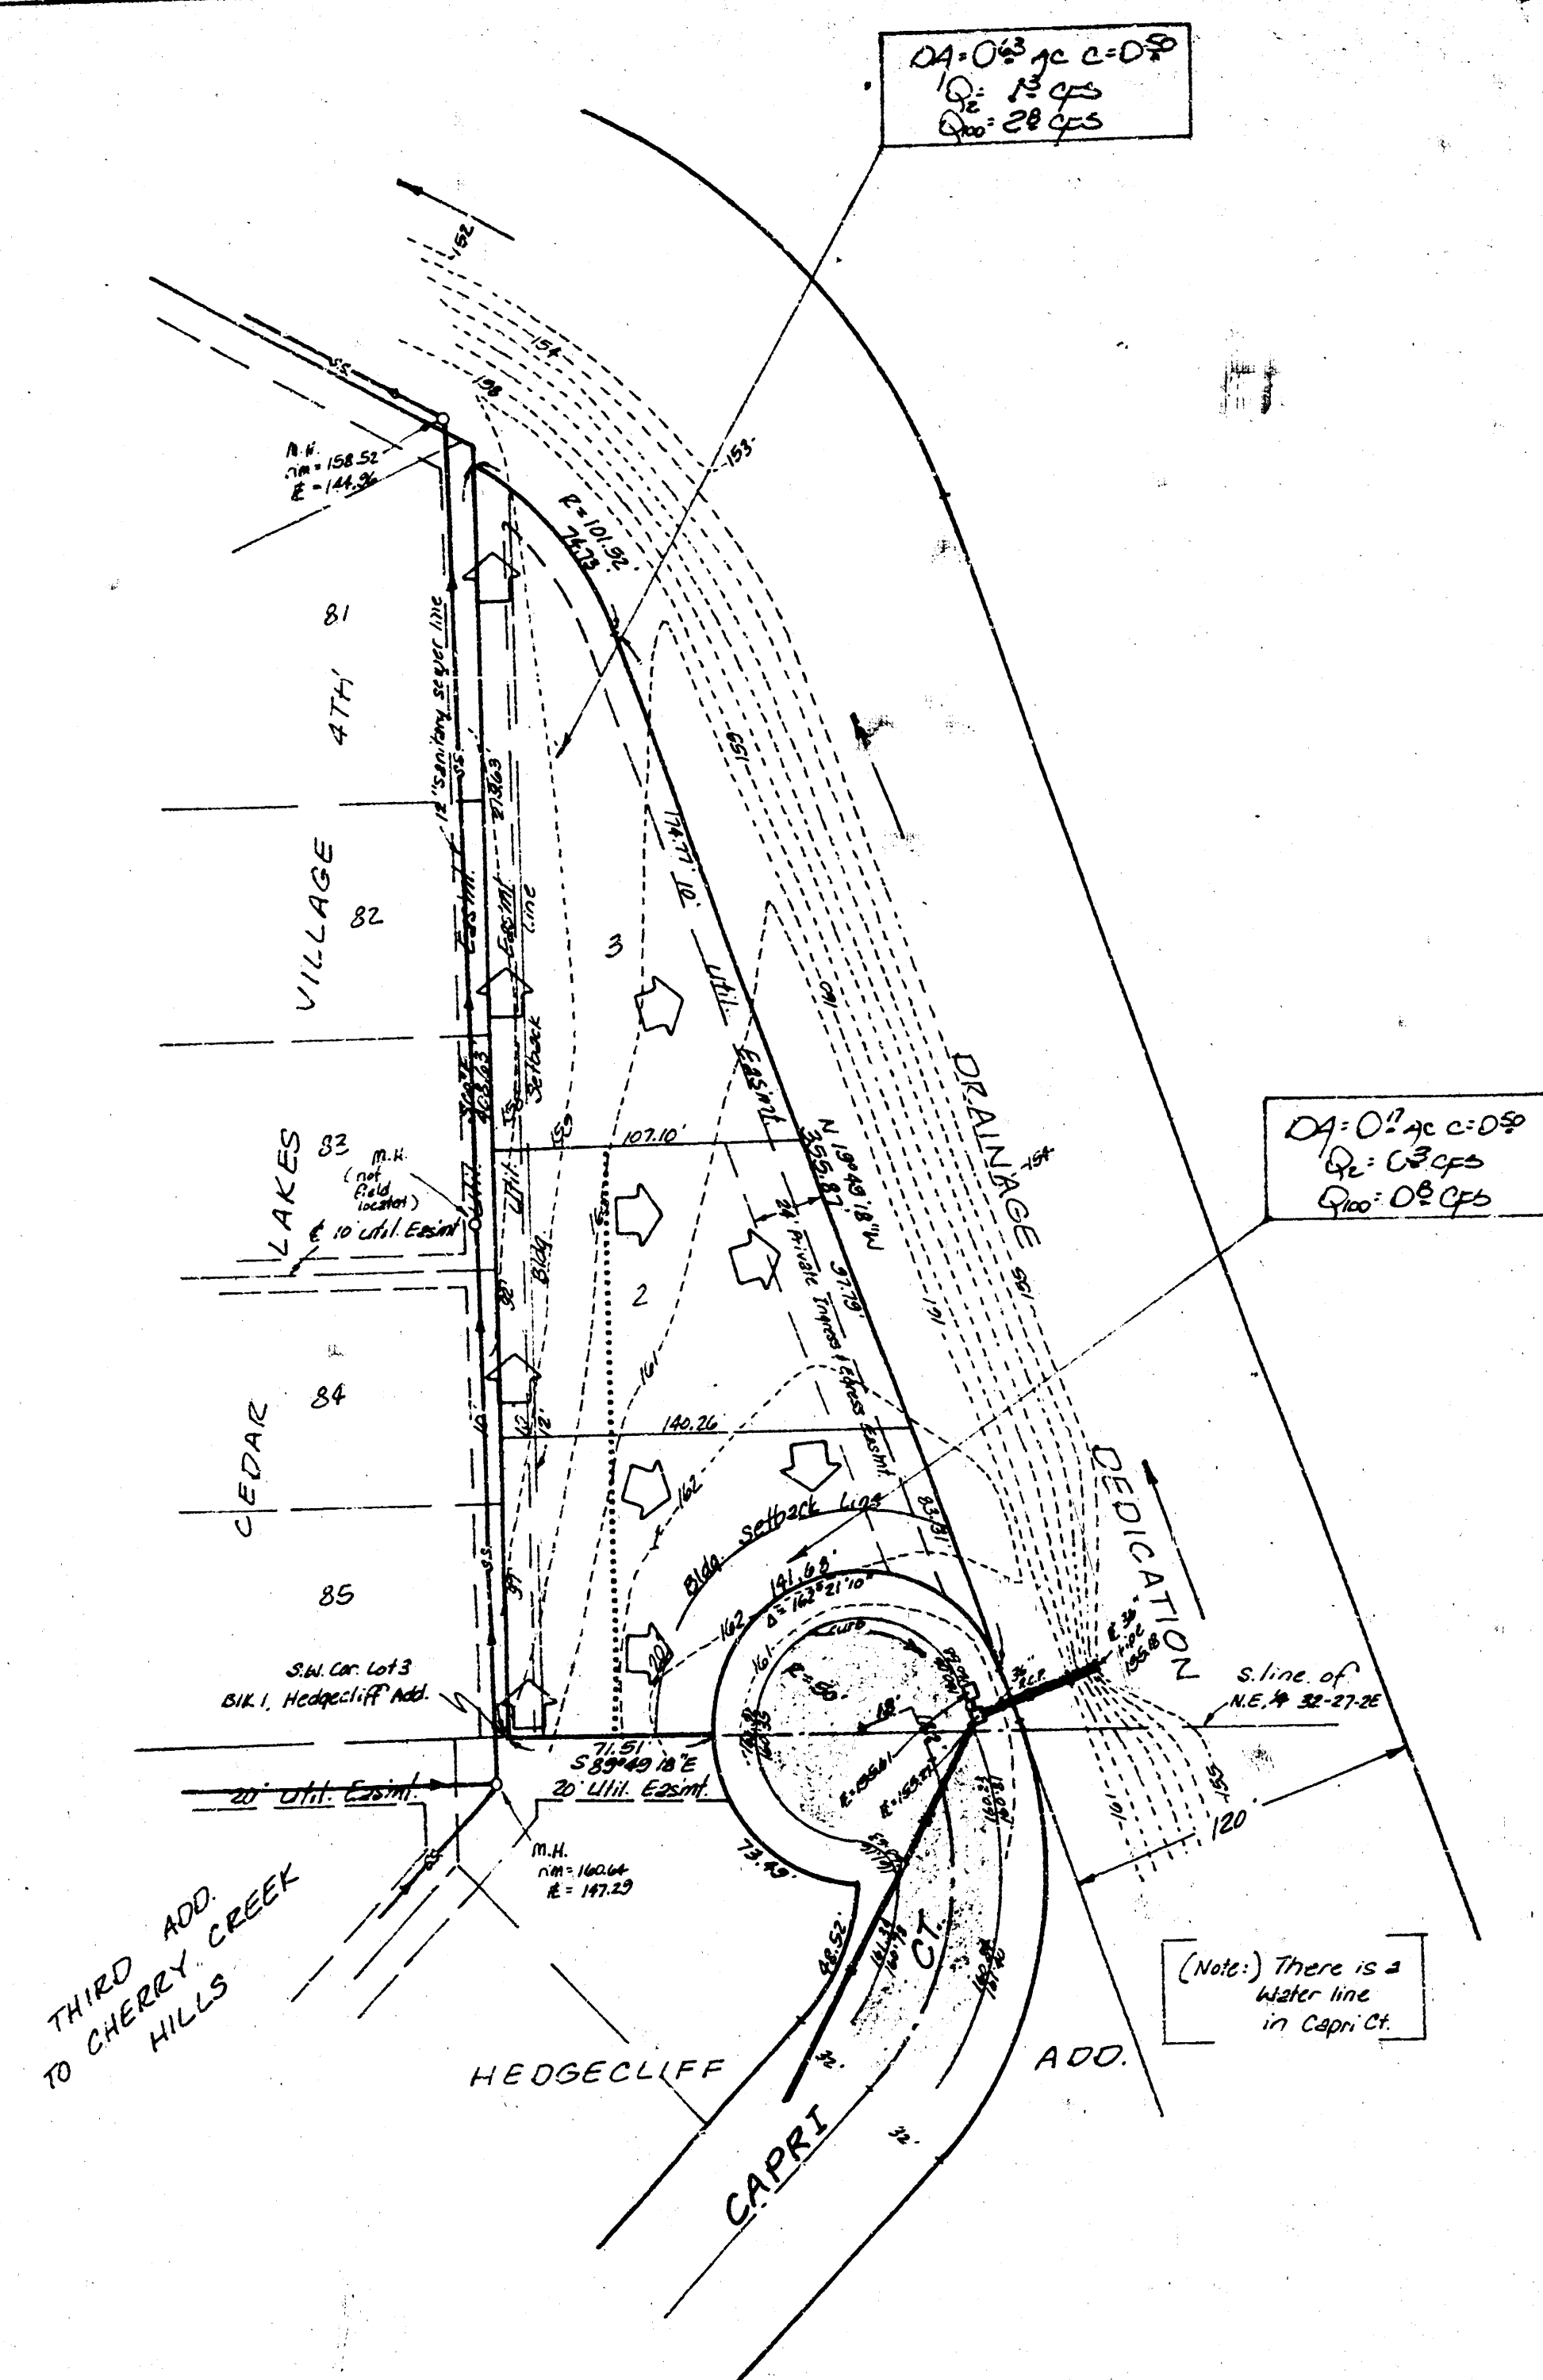

SKETCH PLAT CEDAR CLIFF ADDITION


BEING A REPLAT OF LOTS 3 AND 4,
BLOCK 1, HEDGECLIFF ADDITION,
WICHITA, KANSAS

OWNER: MICHAEL D. HUFF

BAUGHMAN COMPANY, P.A.
SURVEYING & ENGINEERING
316/262-7271 • 330 LAURA • WICHITA, KANSAS 67211

5-27-83

drainage plan

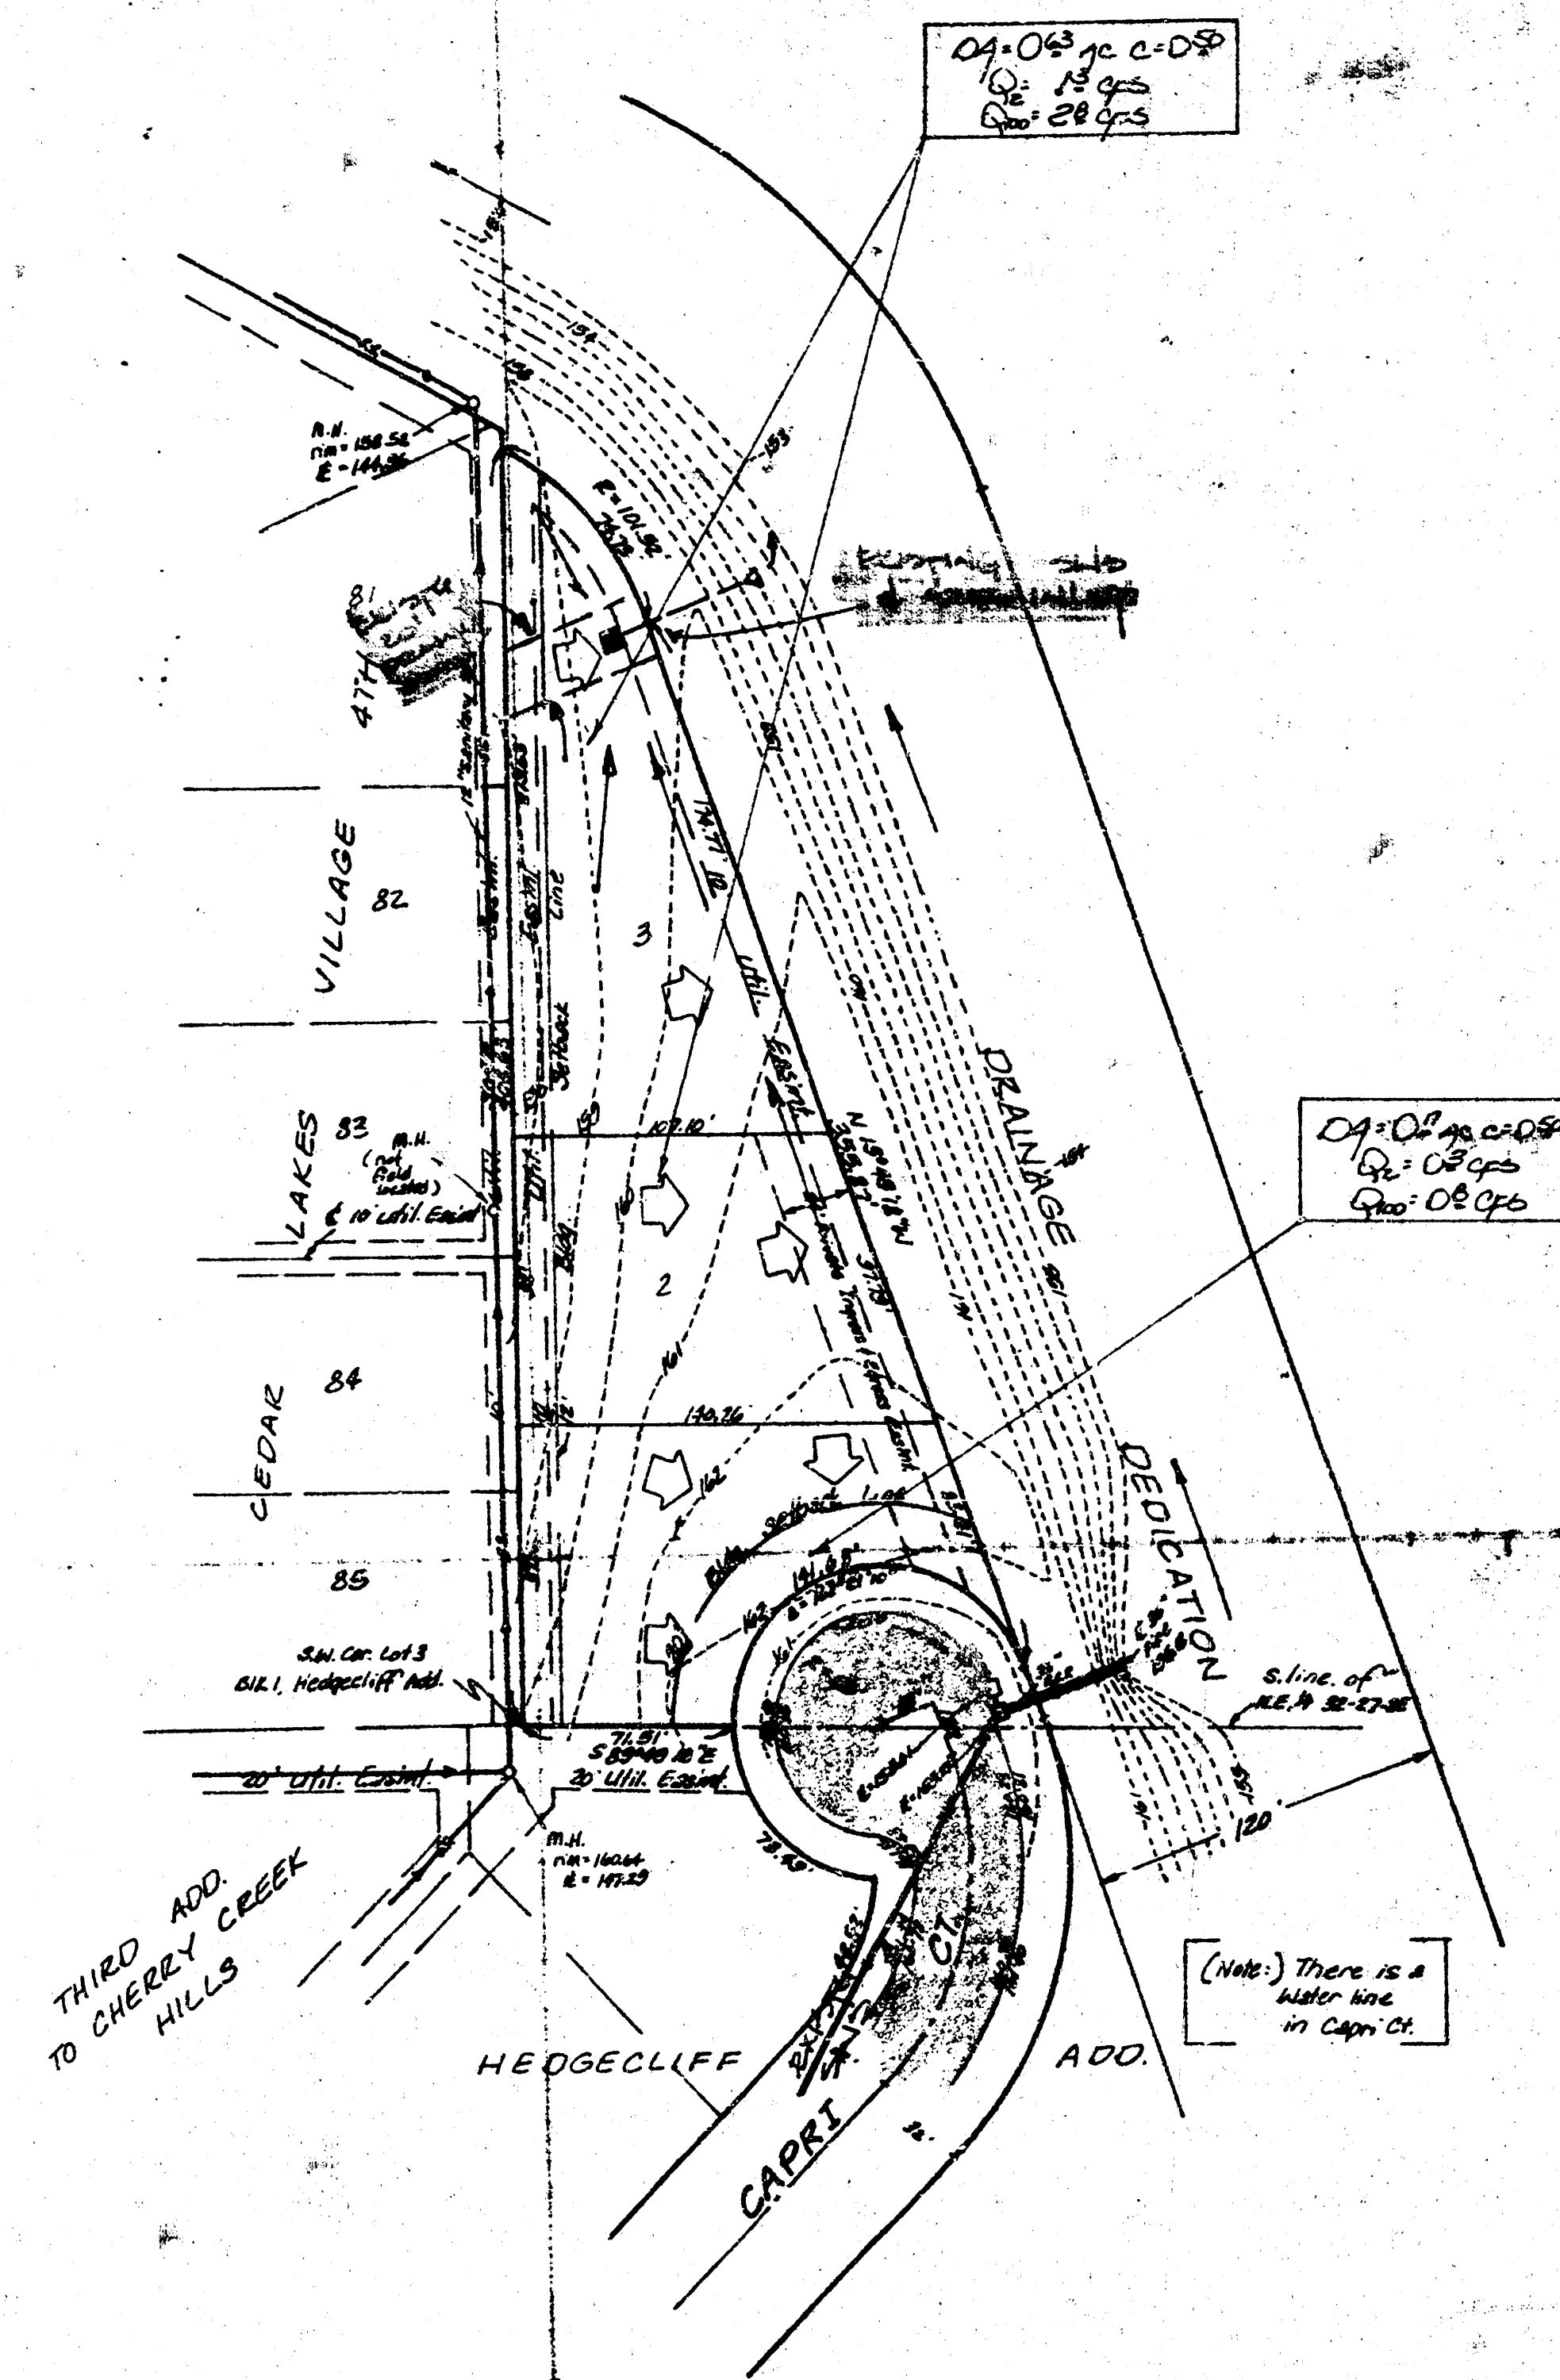

SKETCH PLAT CEDAR CLIFF ADDITION

BEING A REPLAT OF LOTS 3 AND 4,
BLOCK 1, HEDGECLIFF ADDITION,
WICHITA, KANSAS

OWNER: MICHAEL D. HUFF

BAUGHMAN COMPANY, P.A.
SURVEYING & ENGINEERING
316/262-7271 • 330 LAURA • WICHITA, KANSAS 67211

5-27-83

BAUGHMAN COMPANY, P.A.
SURVEYING & ENGINEERING
316/262-7271 • 330 LAURA • WICHITA, KANSAS 67211

**CERTIFICATION
MEMO**

PROJECT: Cedar Cliff Addition	DATE: May 27, 1983
JOB NO. _____	COPIES TO: _____
TO: Chris Breitenstein	
FROM: B. Wooten	
REFERENCE: Drainage Plan	

Final Plat is scheduled for Subdivision for June 9, 1983.
Lots will be duplex lots. C = 0.50. Lot 1 will drain mostly to
Capri Ct. which is discharged by an existing storm sewer as in-
dicated. Lots 2 and 3 will drain to the drainage ditch as indicated
to either the east or north.

PAGE 1 OF 1