


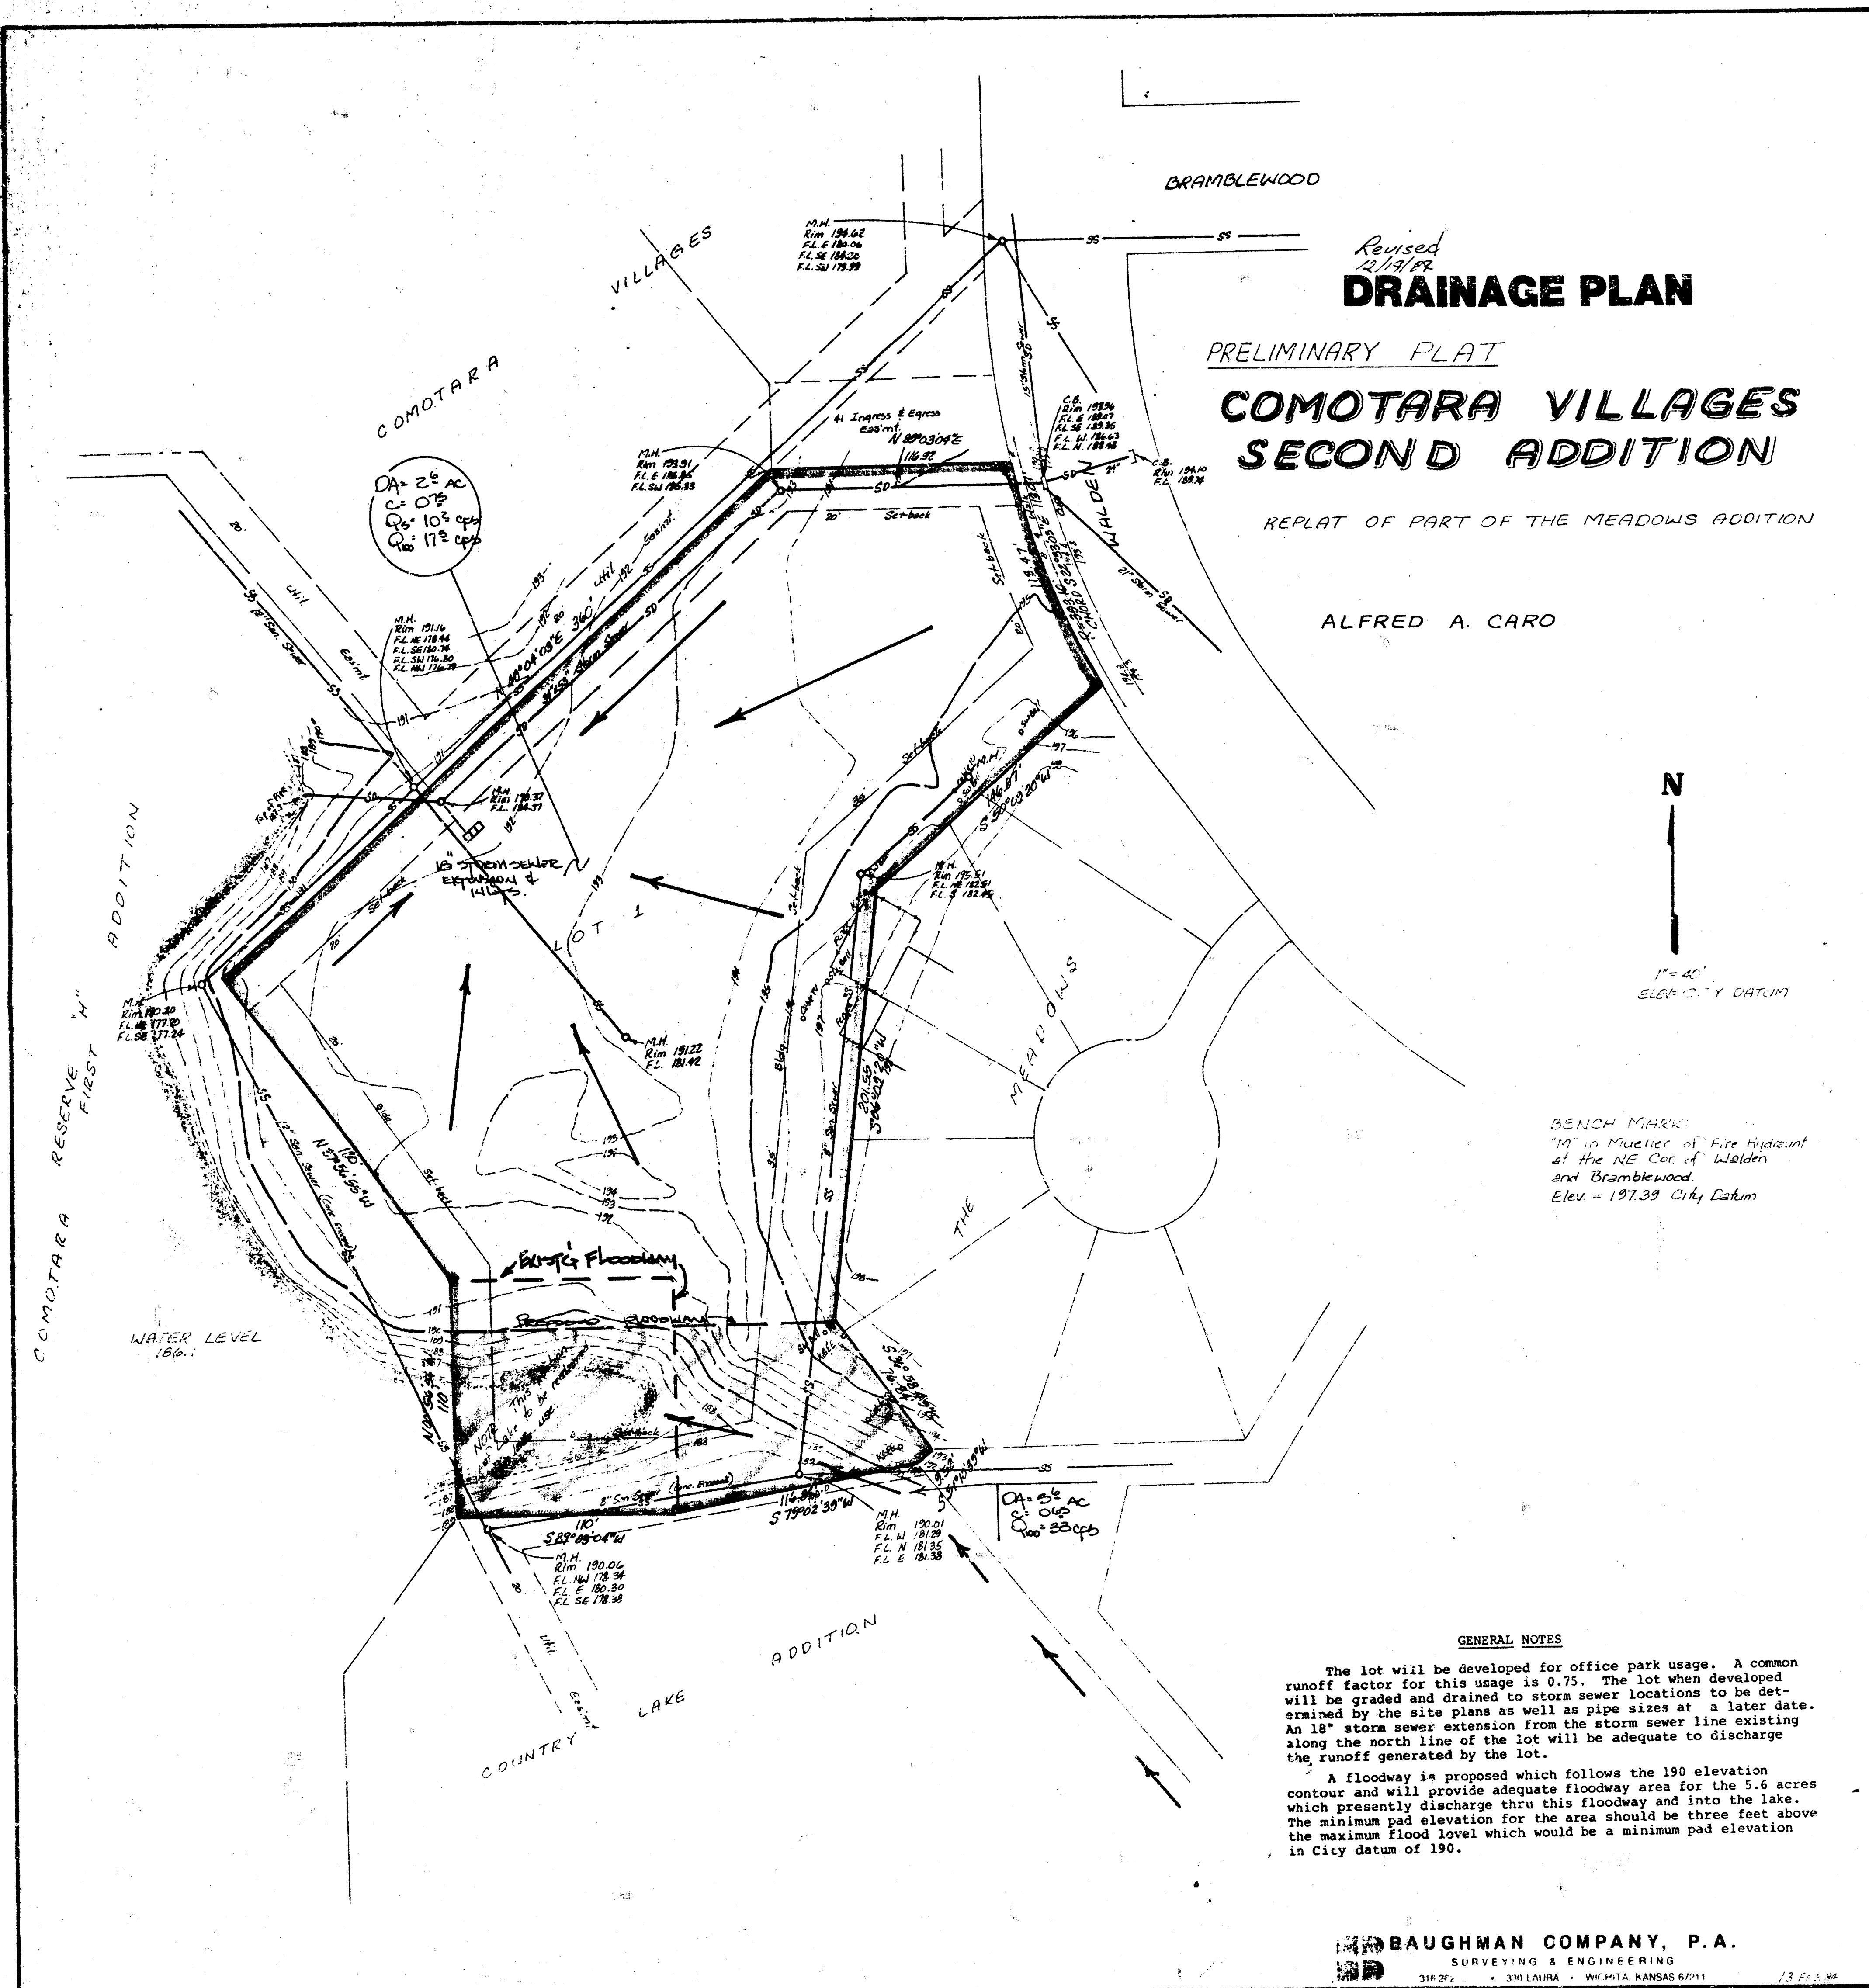

BAUGHMAN COMPANY, P.A.
SURVEYING & ENGINEERING

FILMED FROM THE BEST
AVAILABLE COPY