


11-14-83
KANSAS TURNPIKE AUTHORITY
CASE A-55770
drainage plan

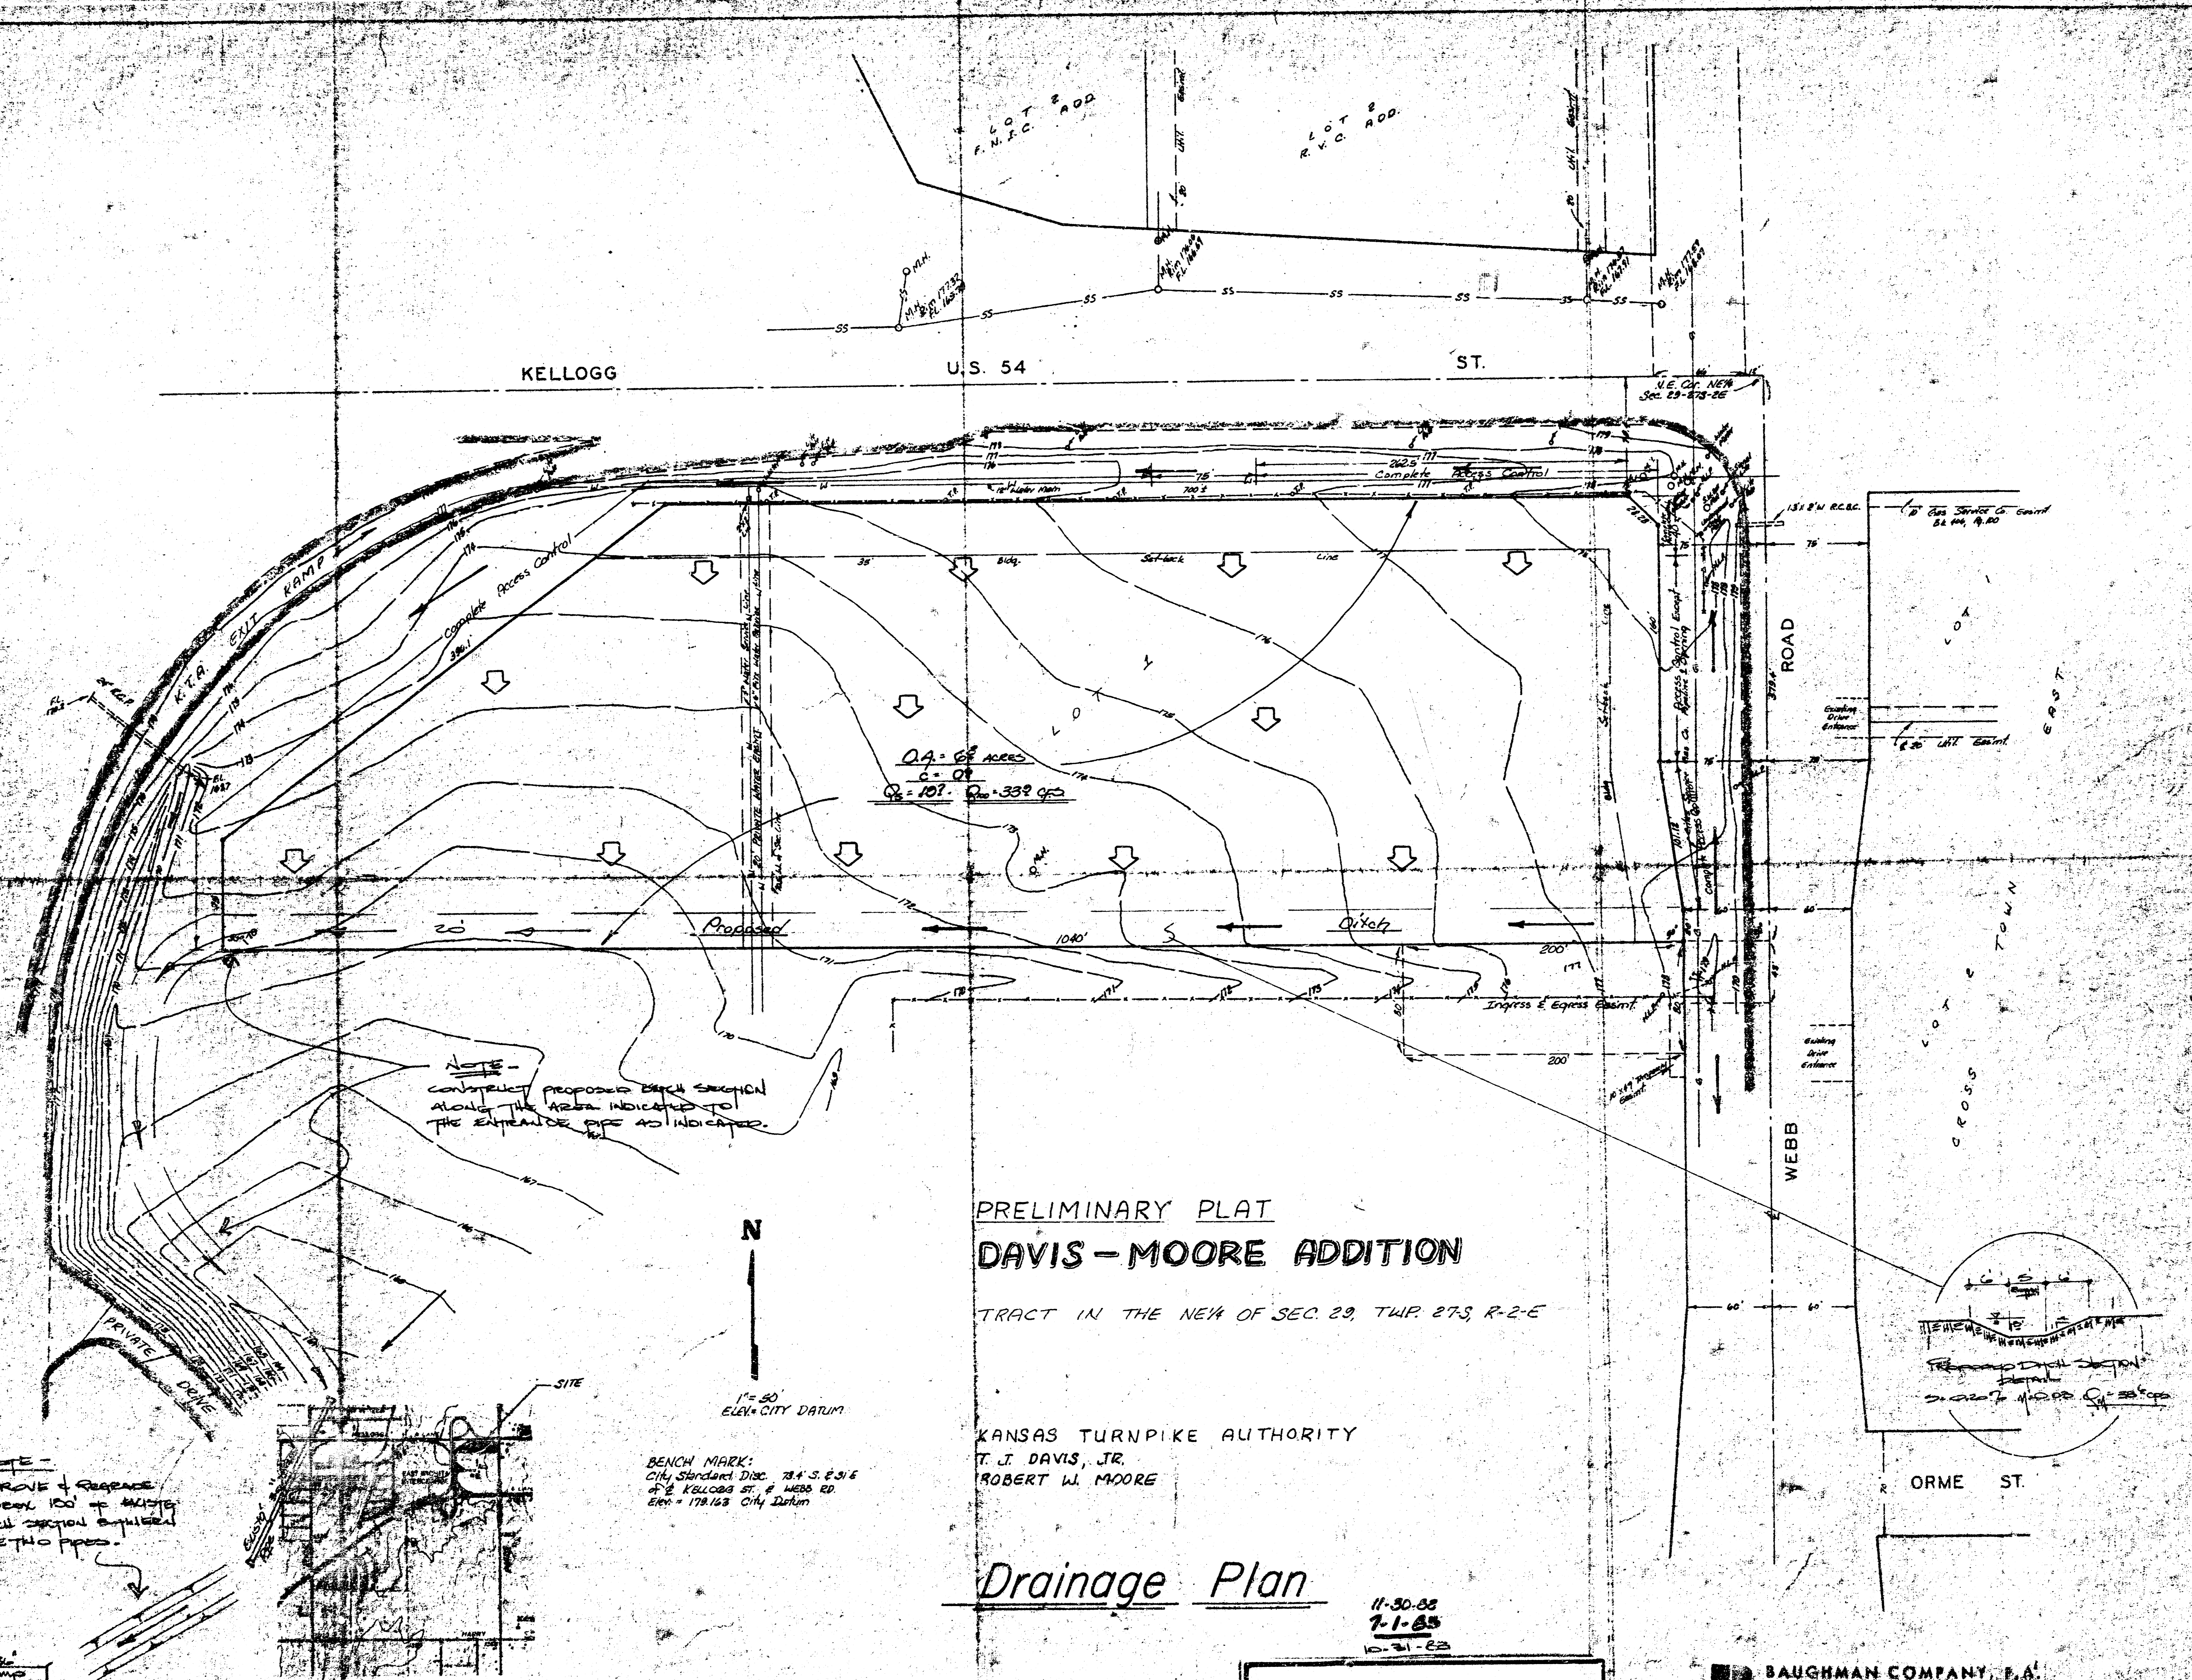

PRELIMINARY PLAT
DAVIS - MOORE ADDITION

TRACT IN THE NE 1/4 OF SEC. 29, TWP. 27S, R. 2-E

KANSAS TURNPIKE AUTHORITY
T. J. DAVIS, JR.
ROBERT W. MOORE

Drainage Plan

11-30-83
7-1-85
10-31-85

FILMED FROM THE BEST
AVAILABLE COPY

BAUGHMAN COMPANY, P.A.
SURVEYING & ENGINEERING

11 NOV 85