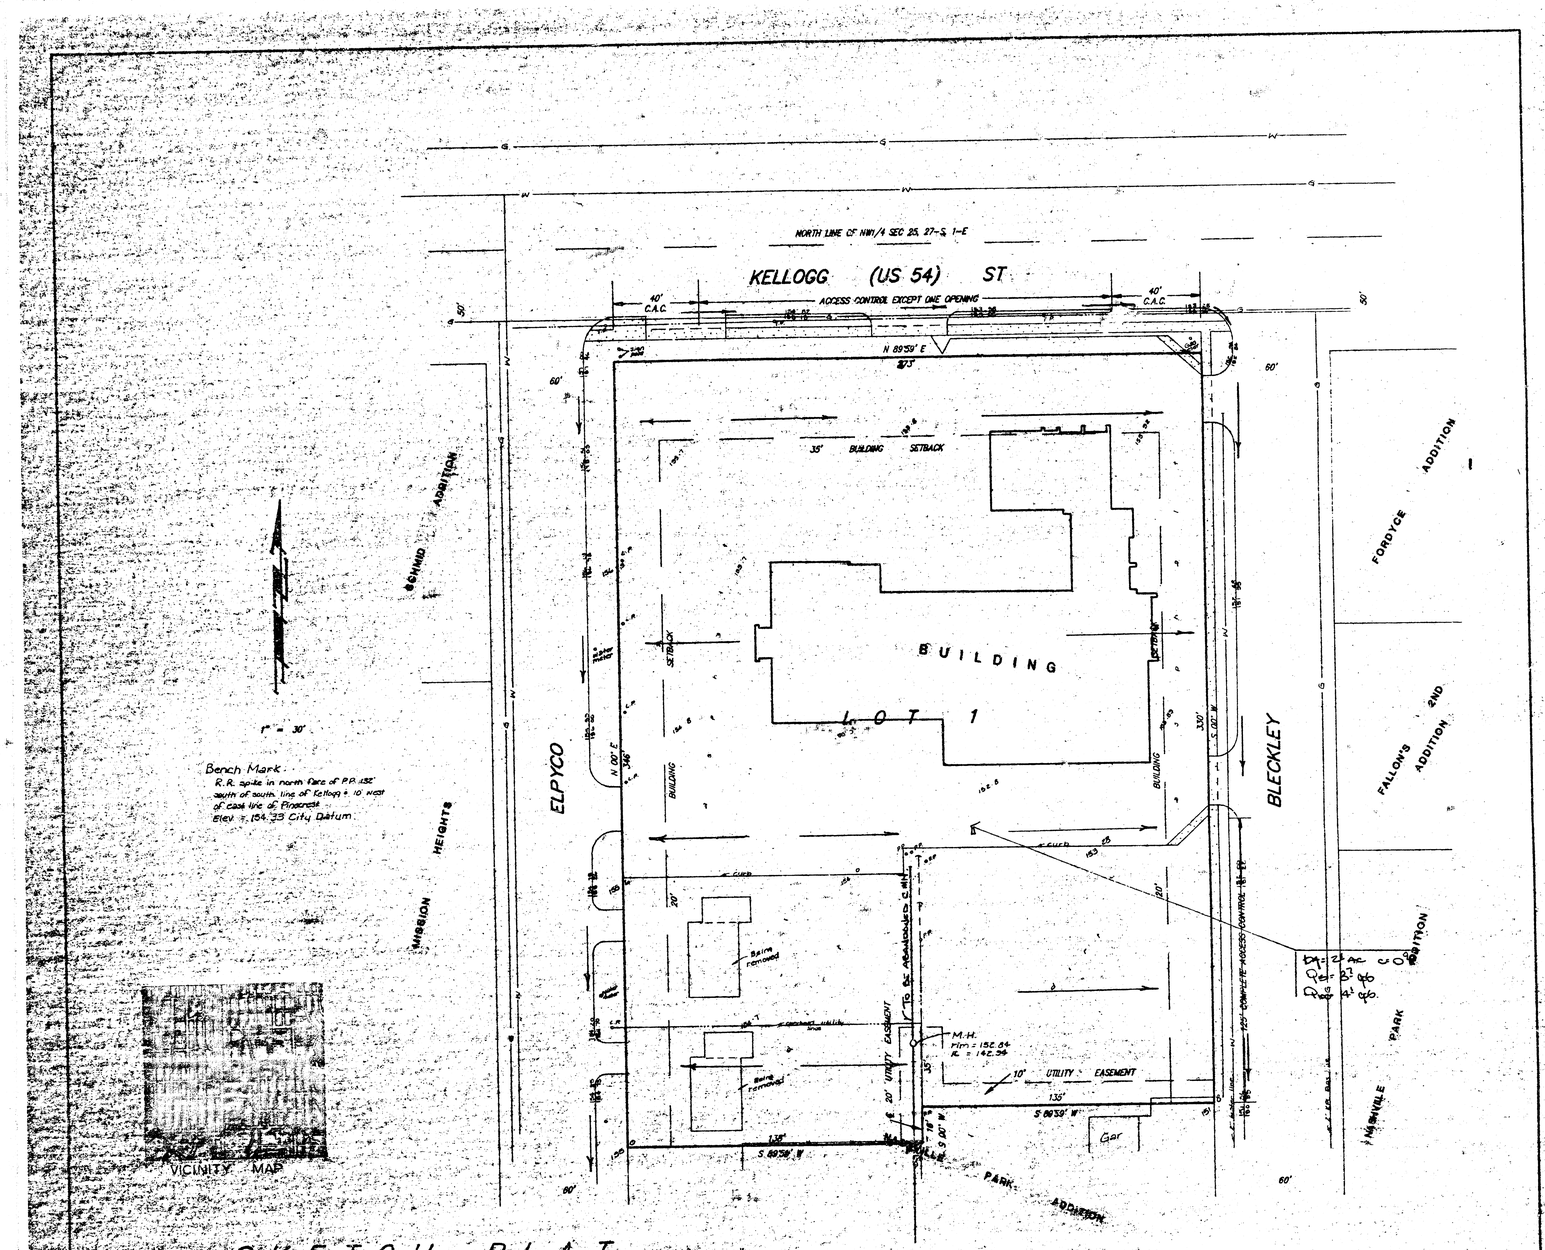

SKETCH PLAT

DAVIS-MOORE 7TH ADDITION

WICHITA, SEDGWICK COUNTY, KANSAS.

APPROVED
DRAINAGE PLAN

Lot 1, Davis-Moore 6th Addition, Wichita, Sedgwick County, Kansas and Lots 10 and 11, Block B, Nashville Park Addition to Wichita, Kansas.

T. G. DAVIS JR.

DRAINAGE PLAN

BAUGHMAN COMPANY P. A.
SURVEYING & ENGINEERING
316/262-7271 • 315 ELLIS • WICHITA, KANSAS 67211

21 JAN 91