


11/1/83
copy obelieup

N
1" = 20'
Elev = City Datum

BENCH MARK:
Top of curb N. side of
Indianapolis St. 50' W.
of the W. line of Hydraulic
Elev. = 108.17 City Datum

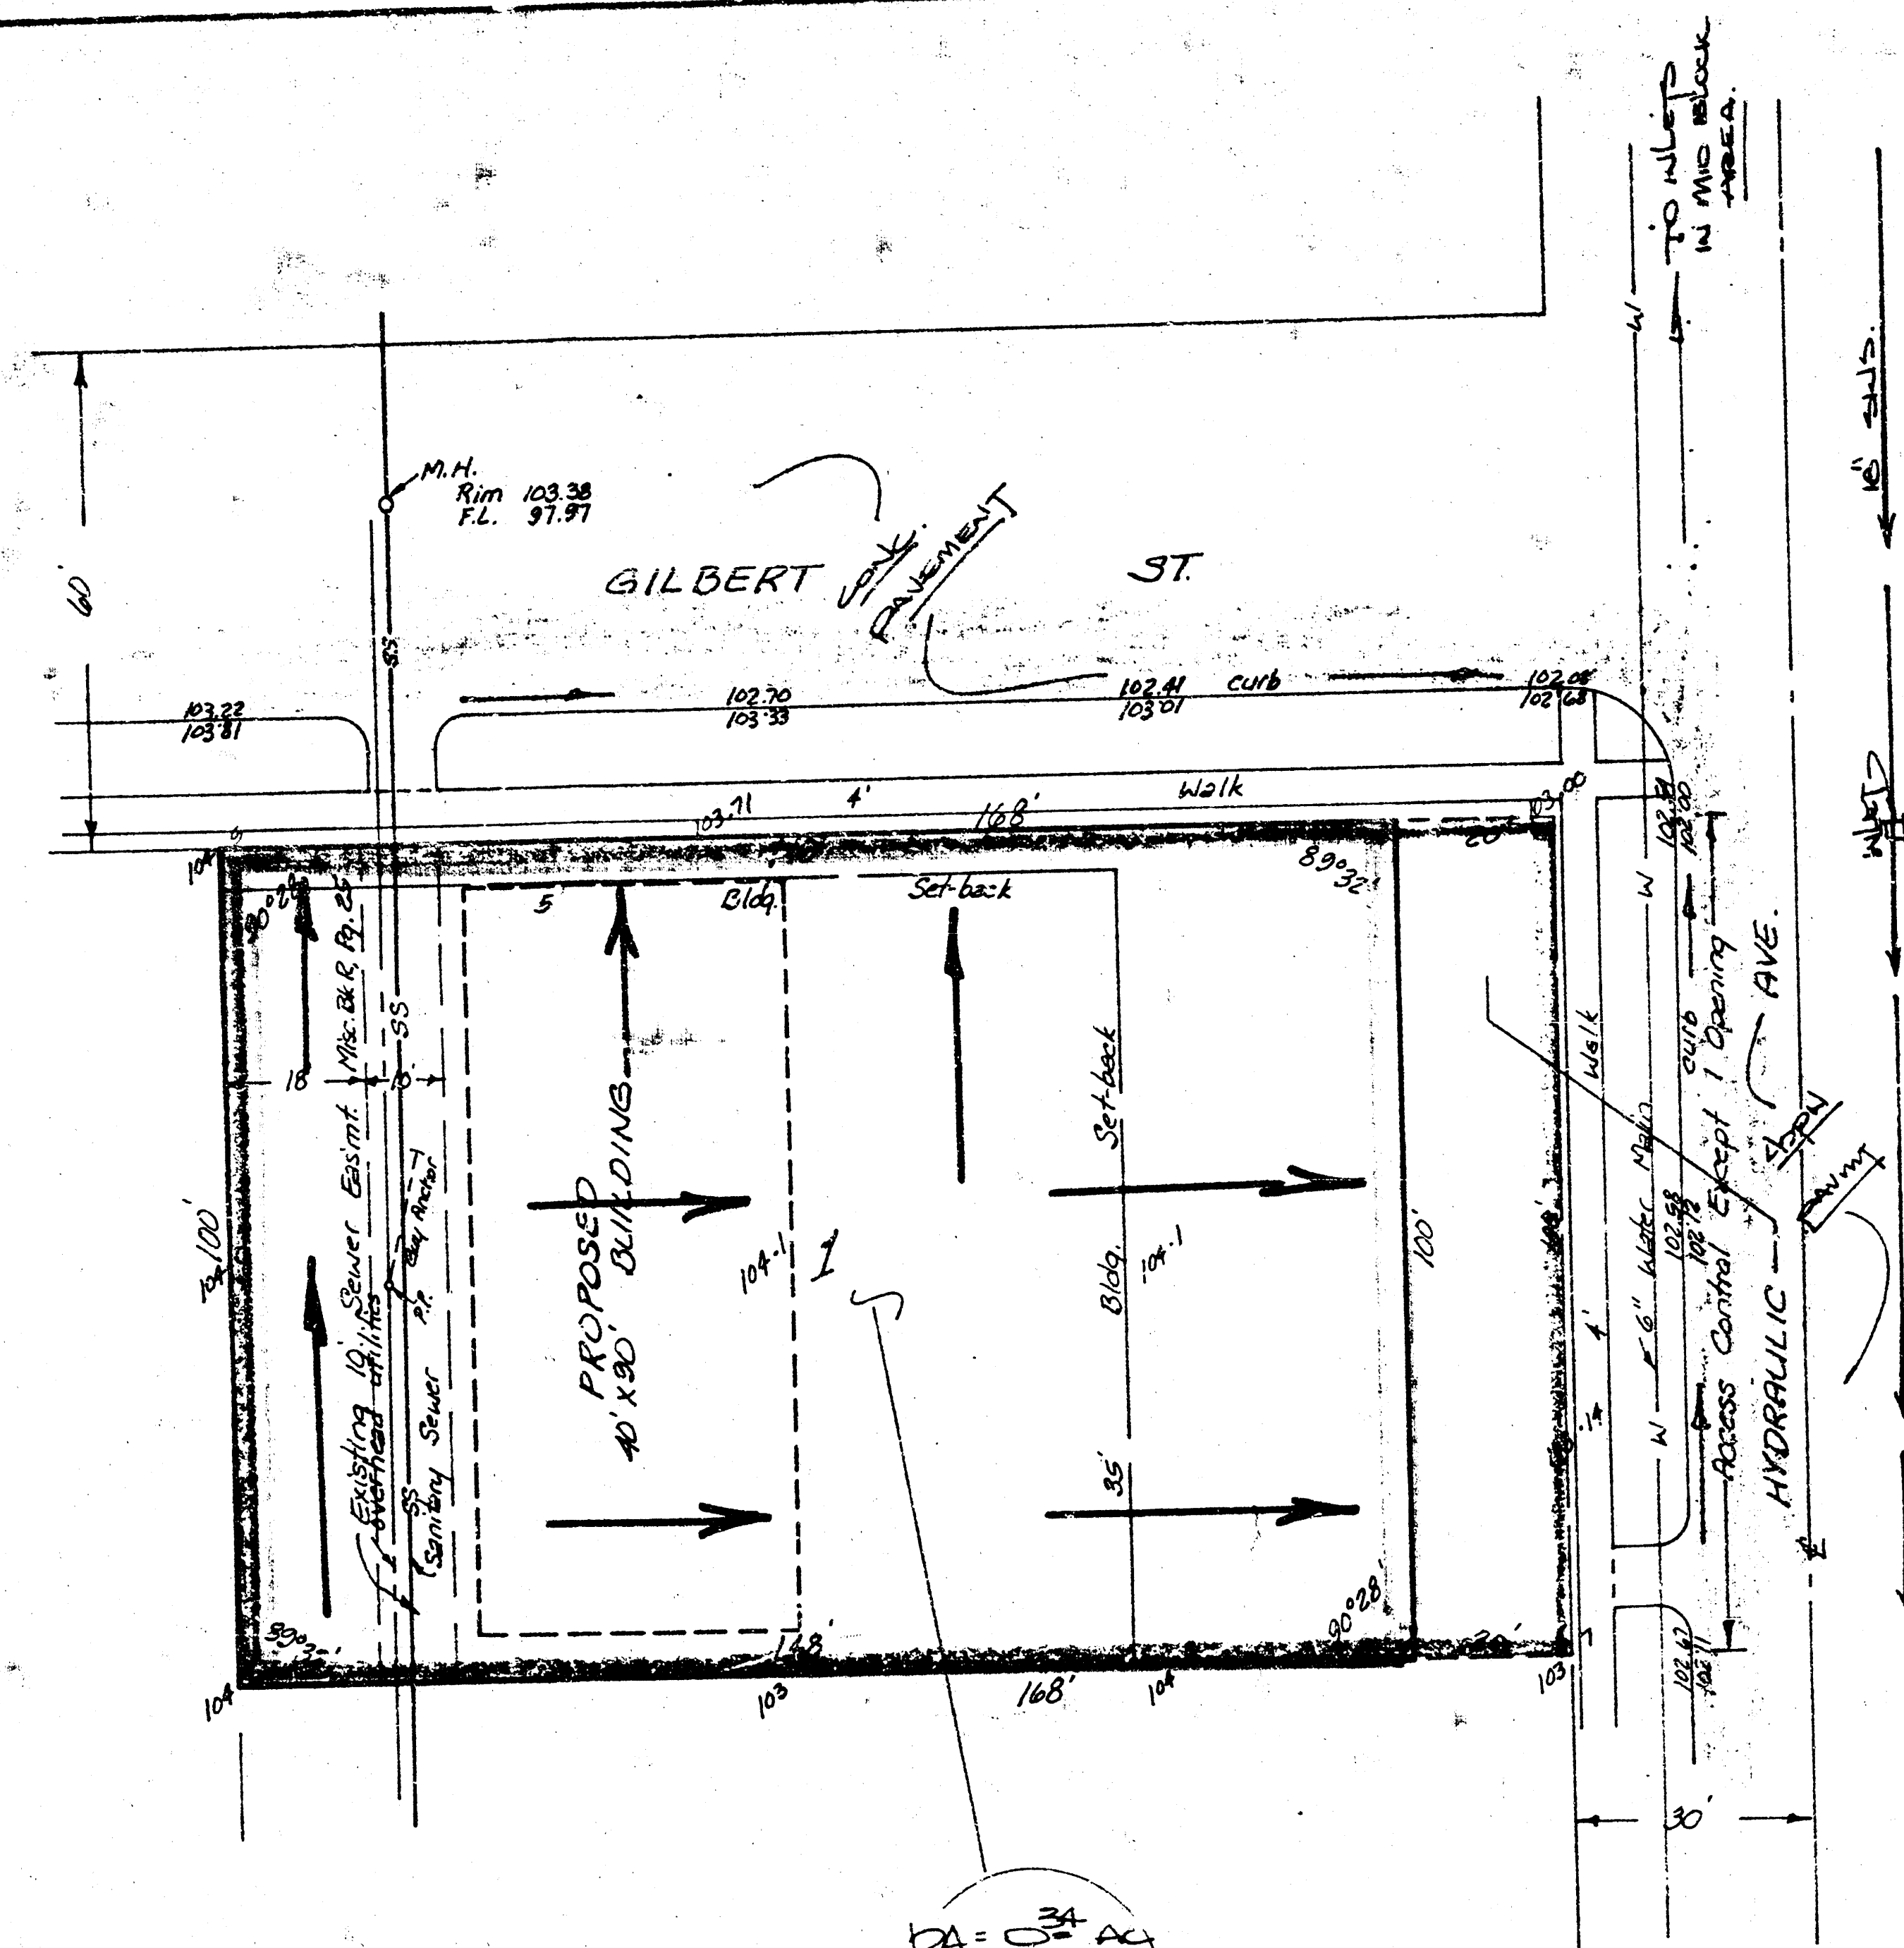

SKETCH PLAT
DAY ADDITION

LOTS 1, 2, 3 AND 4, SALISBURY
ADDITION TO WICHITA, KANSAS.

GARY DAY

BAUGHMAN COMPANY, P.A.
SURVEYING & ENGINEERING
316-262-7271 • 330 LAURA • WICHITA, KANSAS 67211

8 NOV 83

DAY ADDITION
(DRAINAGE)

BAUGHMAN COMPANY, P.A.
SURVEYING & ENGINEERING
316-262-7271 • 330 LAURA • WICHITA, KANSAS 67211

CONFIRMATION
MEMO

PROJECT DAY ADDITION

DATE 11-11-83

JOB NO.

COPIES TO:

TO Chris Breitenstein

FROM N. Brent Wooten

REFERENCE Final drainage plan

Final plat is scheduled for subdivision for Nov. 21, 1983.
The lot is to be developed as L.C. with a runoff factor of 0.85.
The lot will drain to Gilbert St. and Hydraulic thru either drives
or flumes at the time of development. Gilbert drains east to Hydraulic
which drains north half a block to an inlet and SWS in the east
side of Hydraulic. Runoff files are indicated on the plan.

PAGE 1 OF 1