K-96

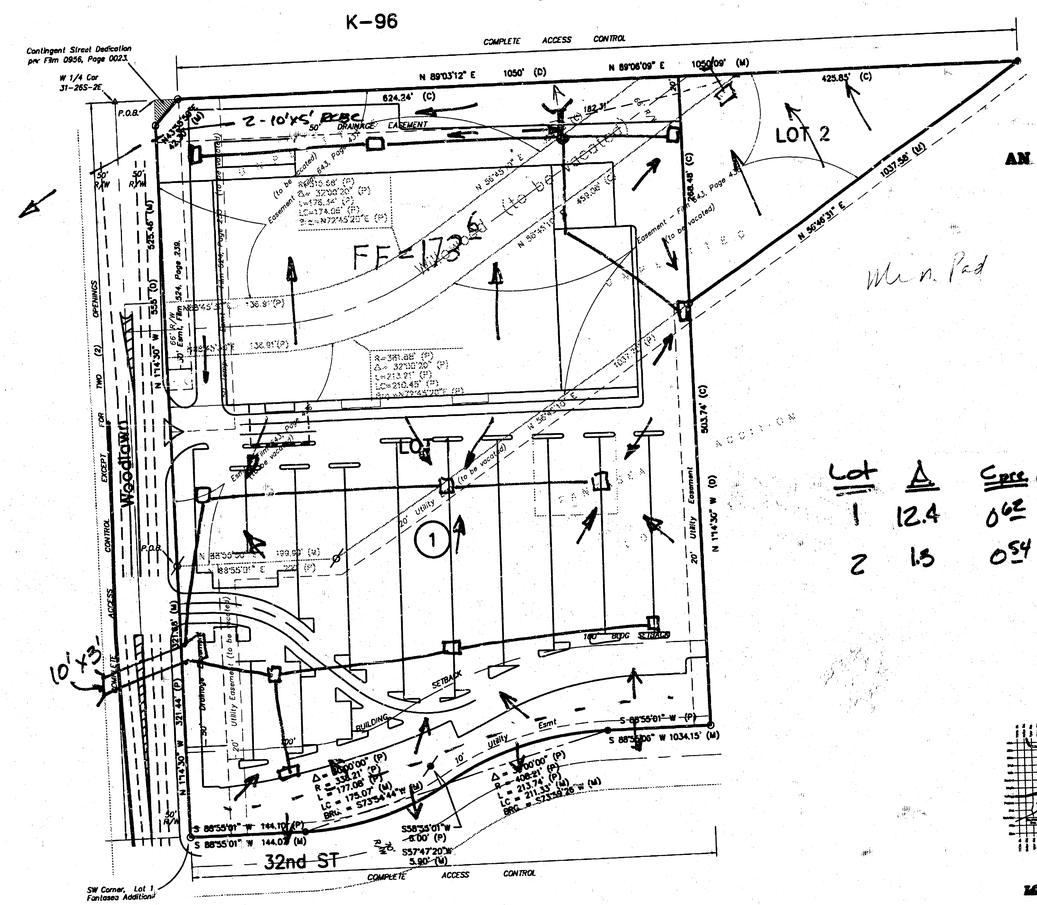
COMPLETE ACCESS CONTROL
Contingent Street Dedication per Flm 0956, Page 0023
W 1/4 Cor 31-26S-2E
P.O.B.
N 89°03'12" E 1050' (D)
N 89°06'09" E 1050.09' (M)
624.24' (C)
425.85' (C)
2-10'x5' RCBC
50' DRAINAGE EASEMENT
LOT 2
FF=1736
Mtn. Pad
Easement - Flm 0943, Page 430 (to be vacated)
Easement - Flm 0943, Page 430 (to be vacated)
N 56°43'37" E
N 56°36'31" E
1037.56' (M)
Woodtown
ACCESS CONTROL EXCEPT FOR TWO (2) OPENINGS
