



FRIENDS MANOR ADDITION
(Drainage)

SKETCH PLAT
FRIENDS MANOR ADDITION

ODD LOTS 63 THROUGH 111 ON HIRAM
UNIVERSITY PLACE ADDITION, TOGETHER
WITH PART OF HIRAM AVE. & UNIVERSITY AVE.

OWNERS: FRIENDS UNIVERSITY
PHILIP S. WHITEMAN
ORVIL J. PIERCE

Bench mark:
Brass rod in concrete post
28 feet west of centerline
of Glenn & 12 feet north of
south line of Maple
Elevation = 109.14 City Datum

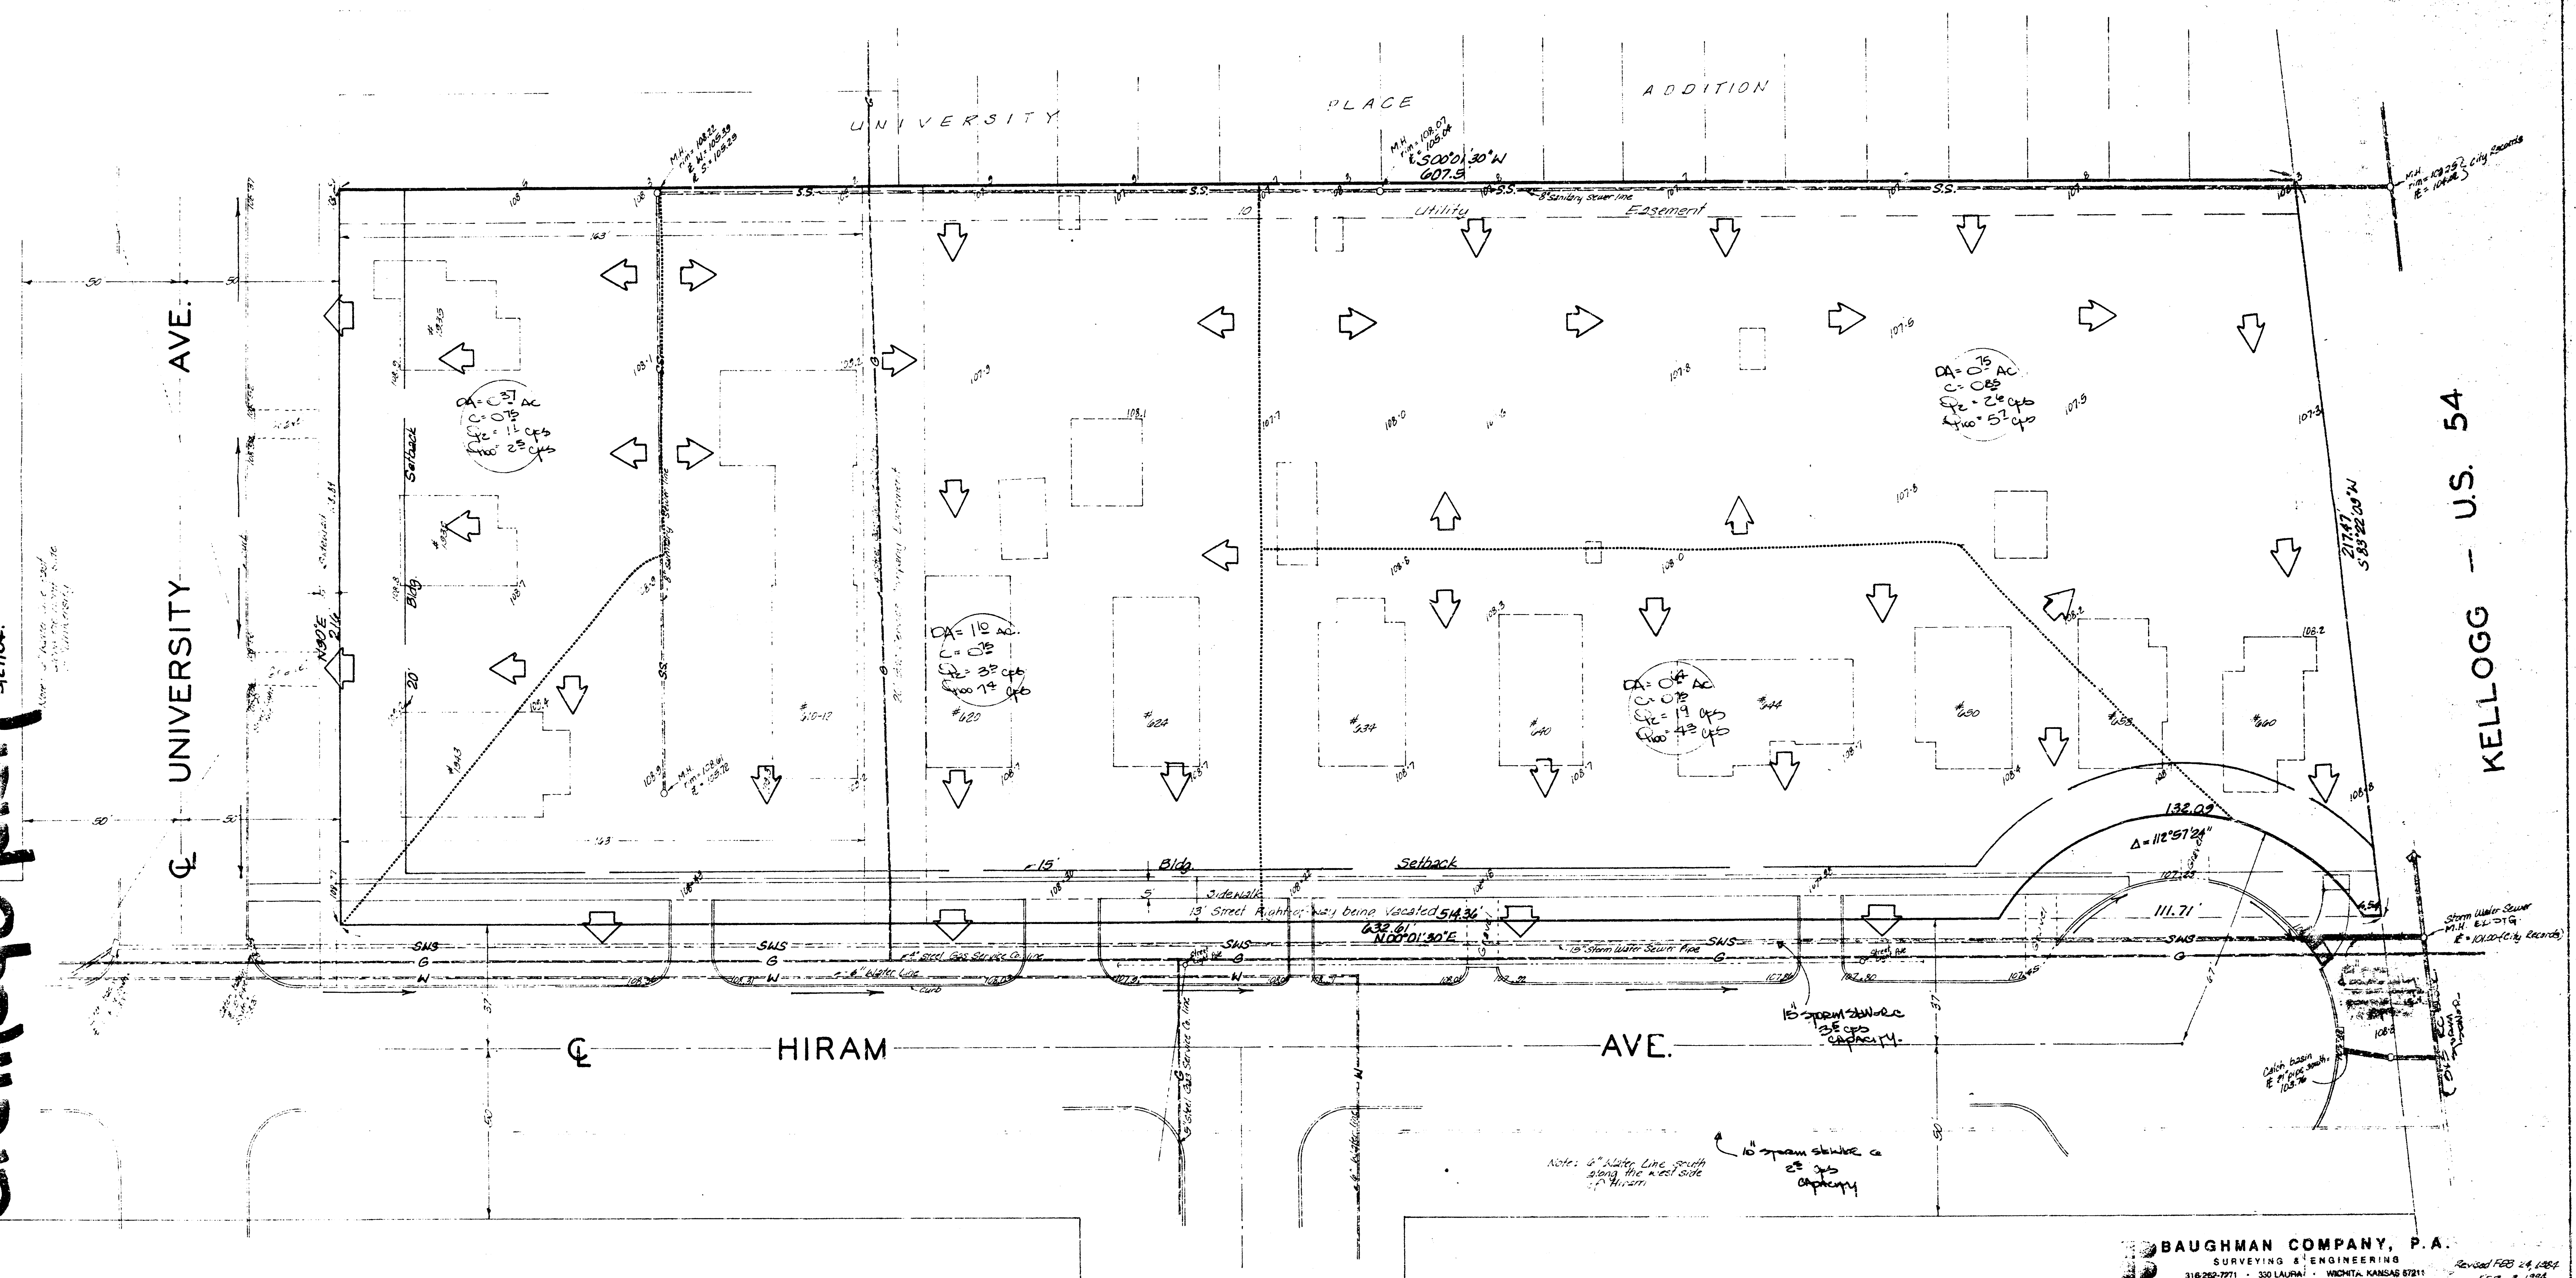

BAUGHMAN COMPANY, P.A.
SURVEYING & ENGINEERING
316-262-7971 • 330 LAURA • WICHITA, KANSAS 67211
Revised FEB 24, 1984
FEB. 3, 1984