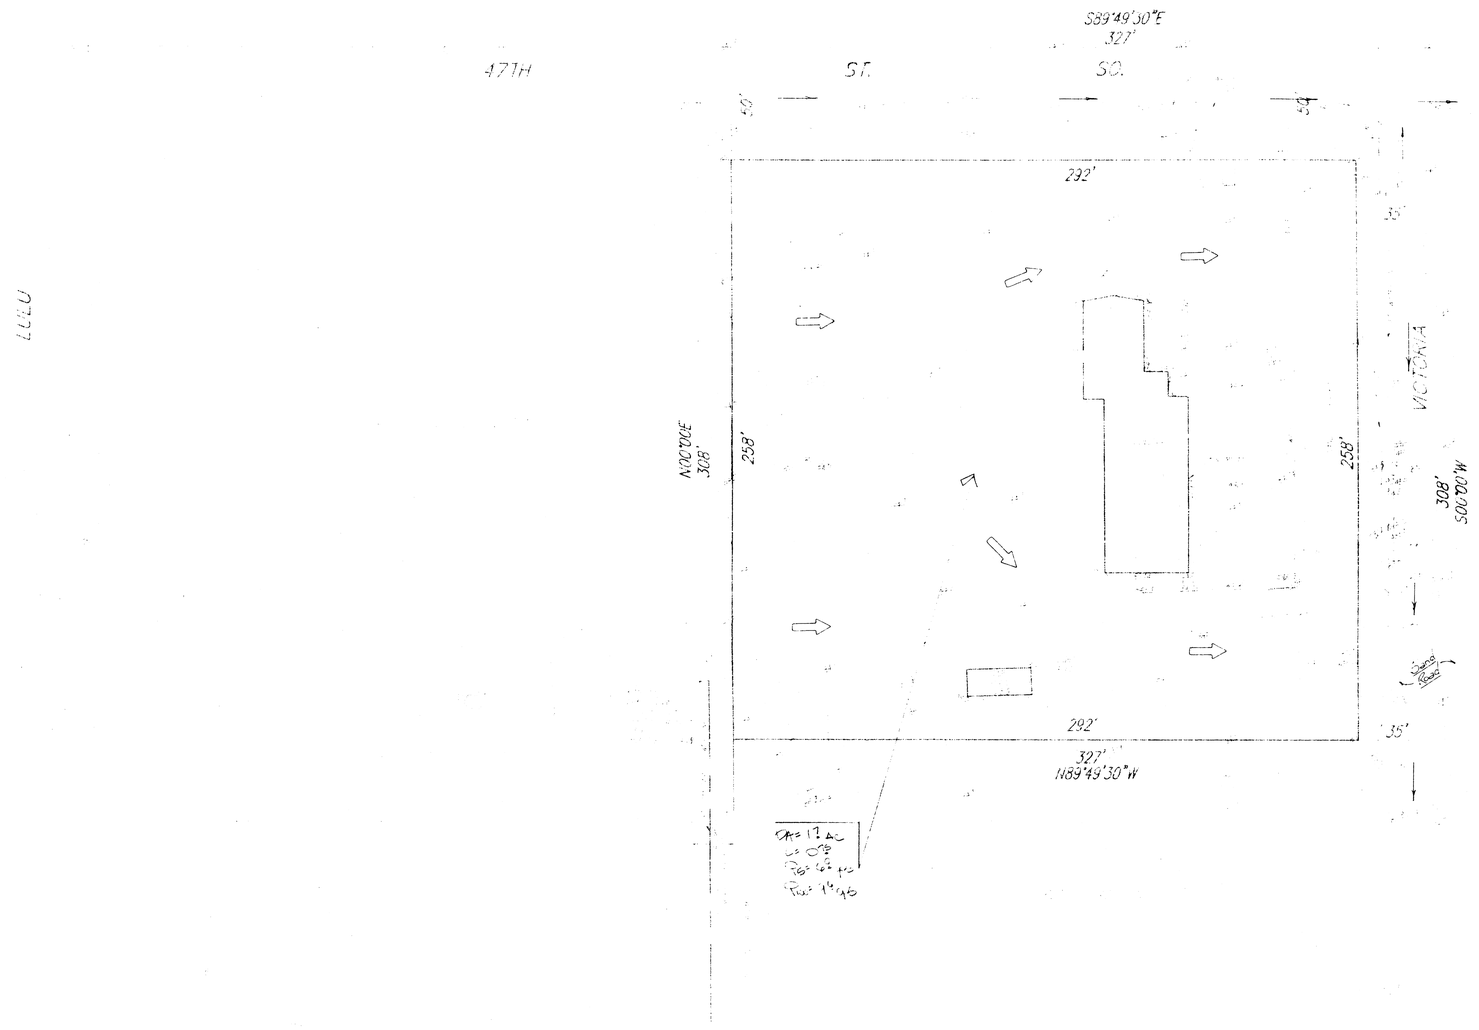

SKETCH PLAT

GOOD SHEPHERD LUTHERAN CHURCH ADDITION

DRAINAGE PLAN