


Harlin's

7

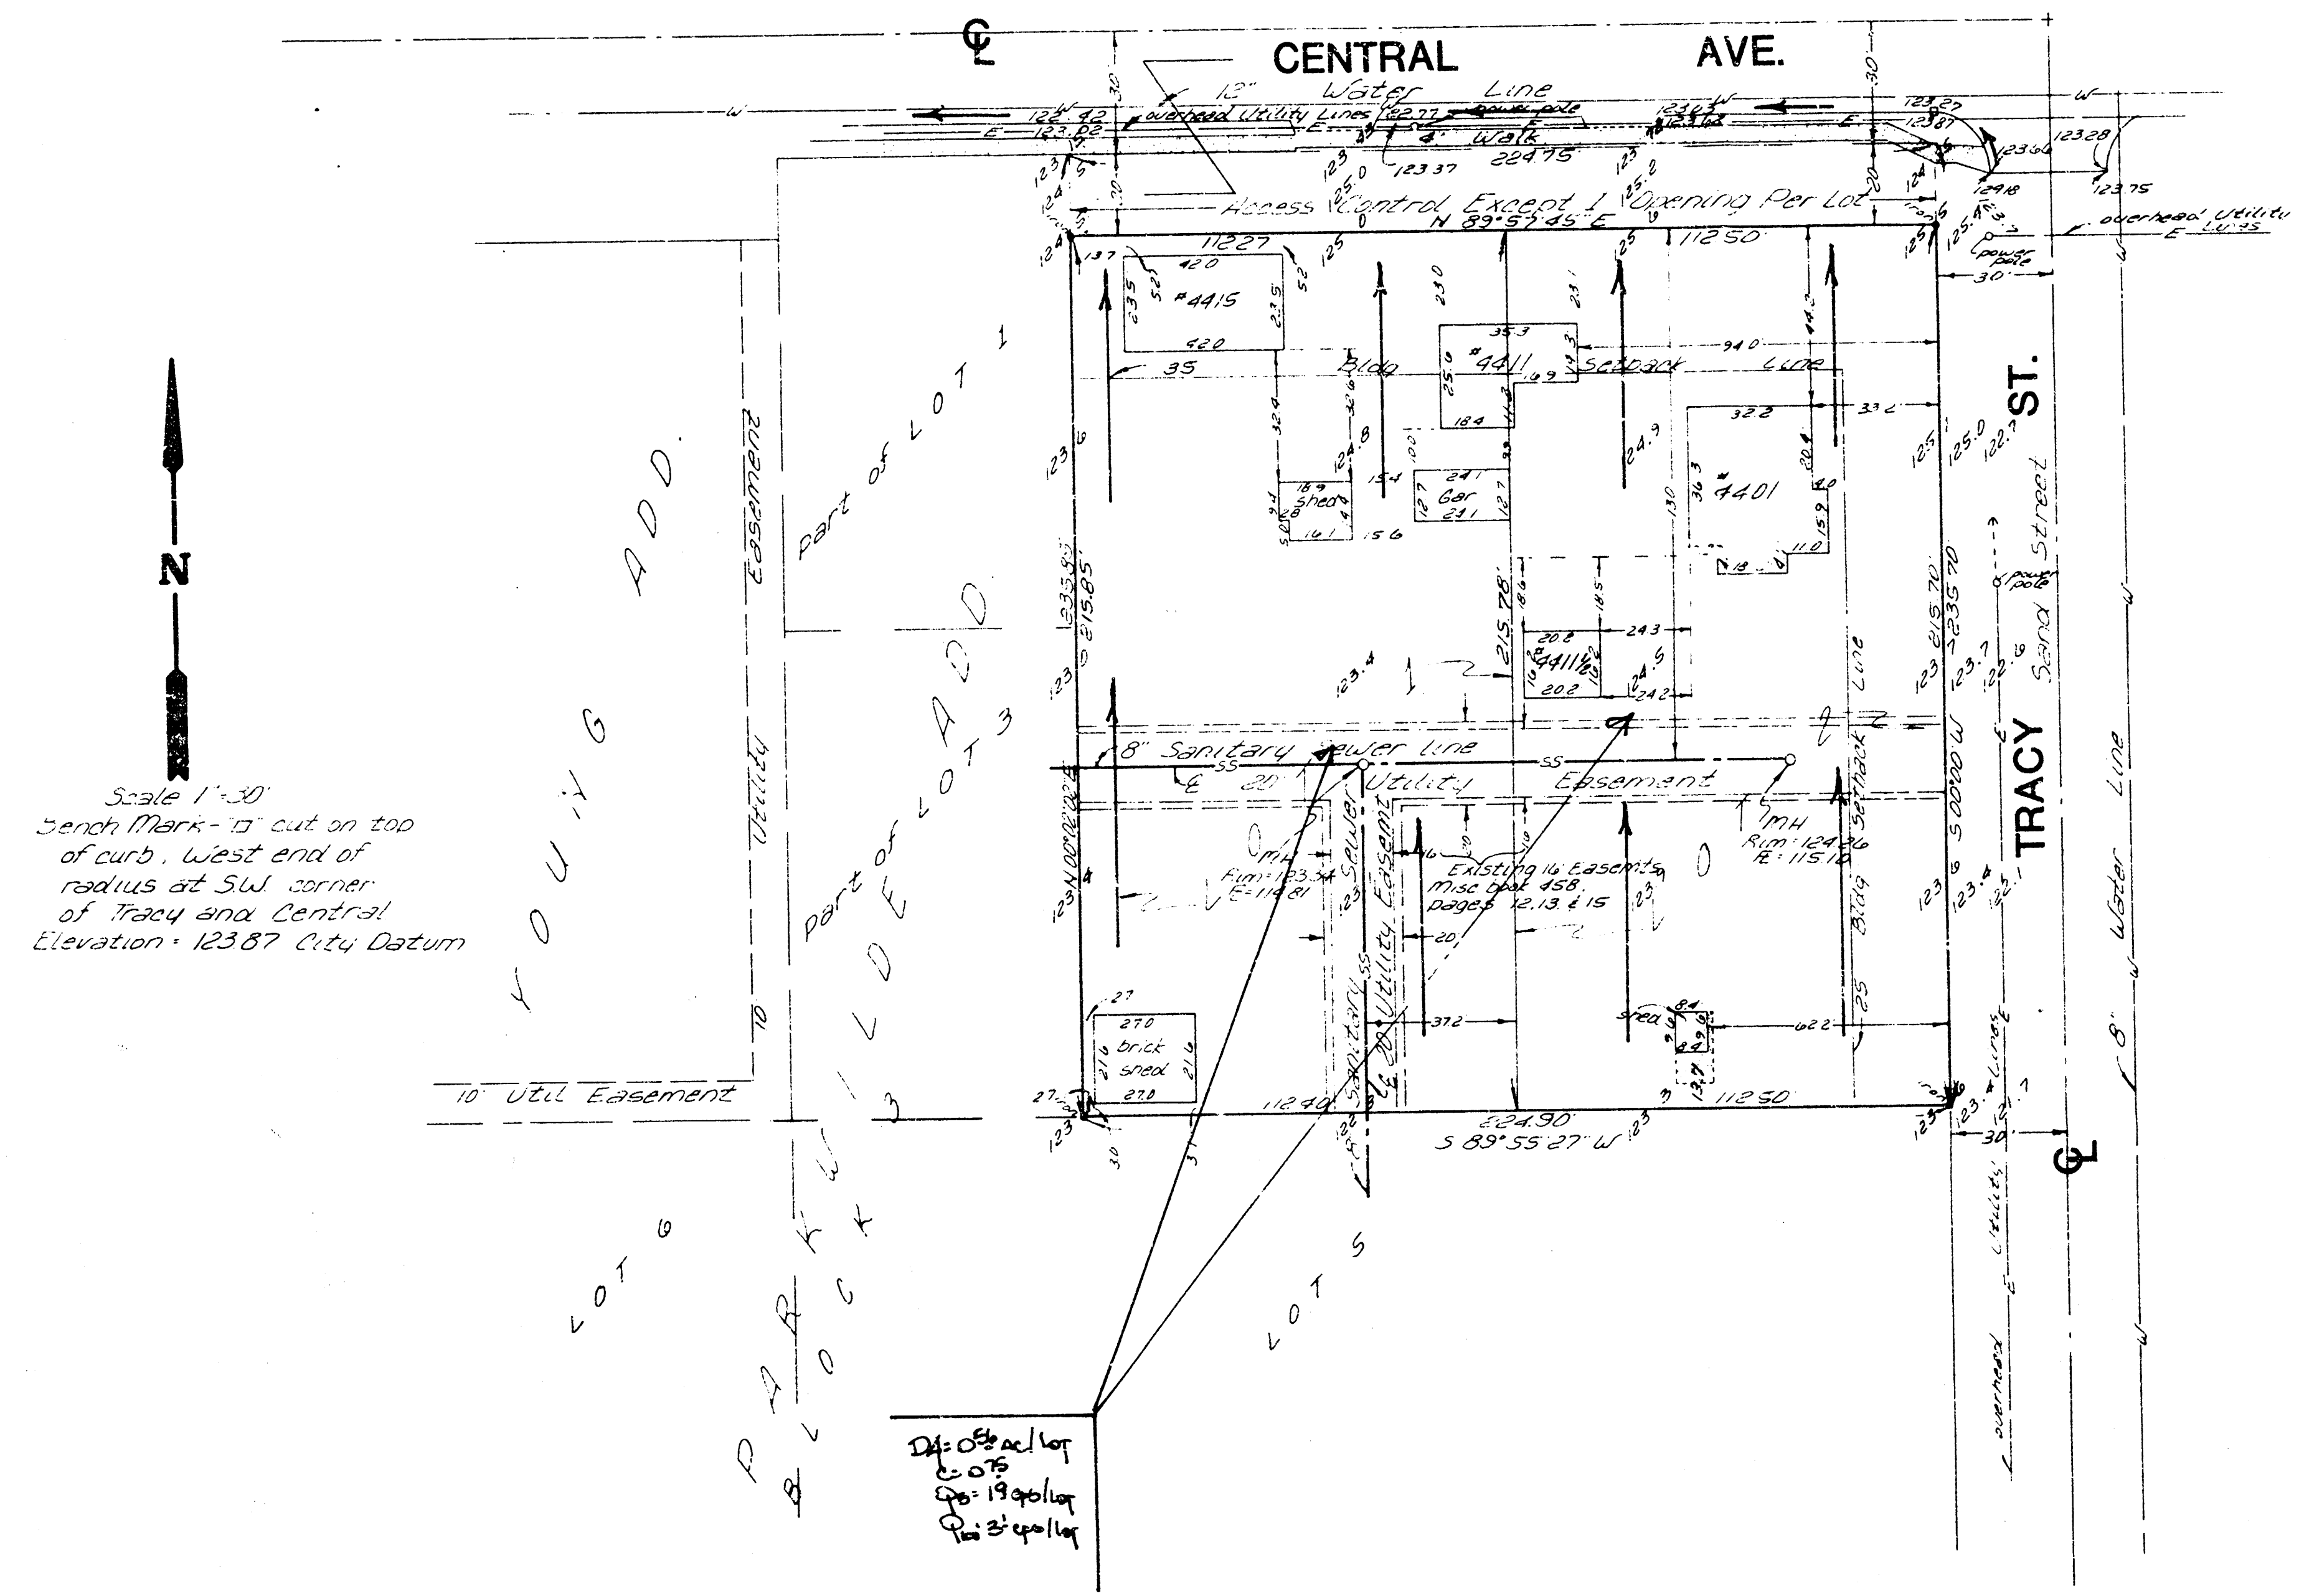

SKETCH PLAT

HARLIN'S ADDITION

THE EAST 3/4 OF LOTS 1 & 3, BLOCK 3,
PARKWILDE ADDITION

OWNER:
HARLIN & JANET GRAY

DRAINAGE PLAN

BAUGHMAN COMPANY, P.A.
SURVEYING & ENGINEERING
315 2ND ST. • WICHITA, KANSAS 67211

29 Aug. 1988