



*Railroad Spike in Light Pole, Southwest
corner of 45th and Victoria.
Elev. = 84.74*

A

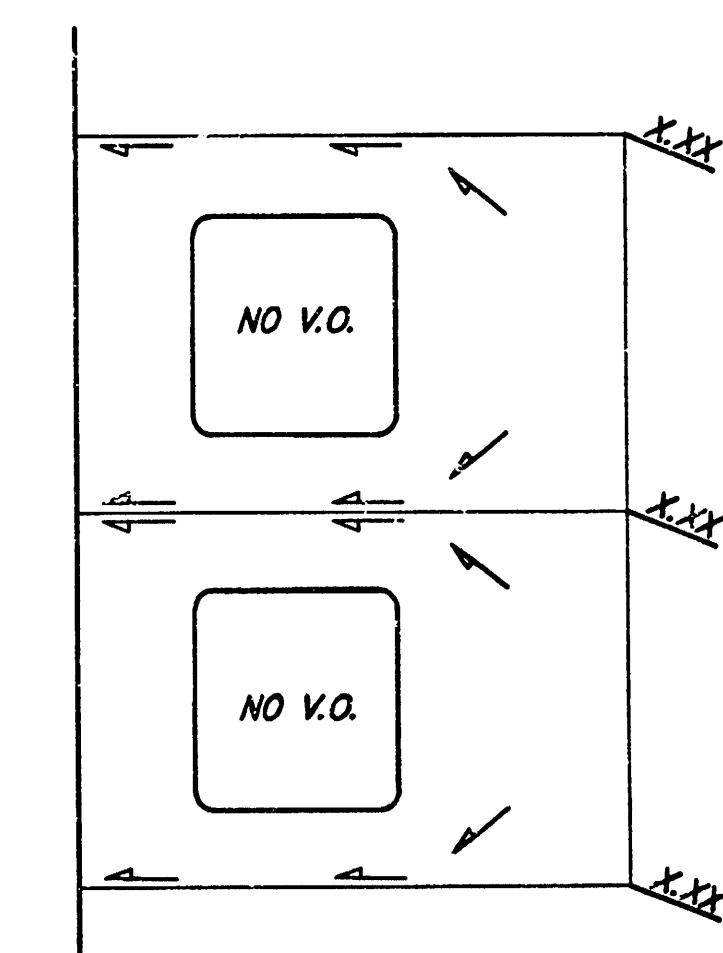

**TYPICAL LOT DRAINAGE FOR LOTS
REQUIRING FLOW TO FRONT OF LOT**

NO SCALE

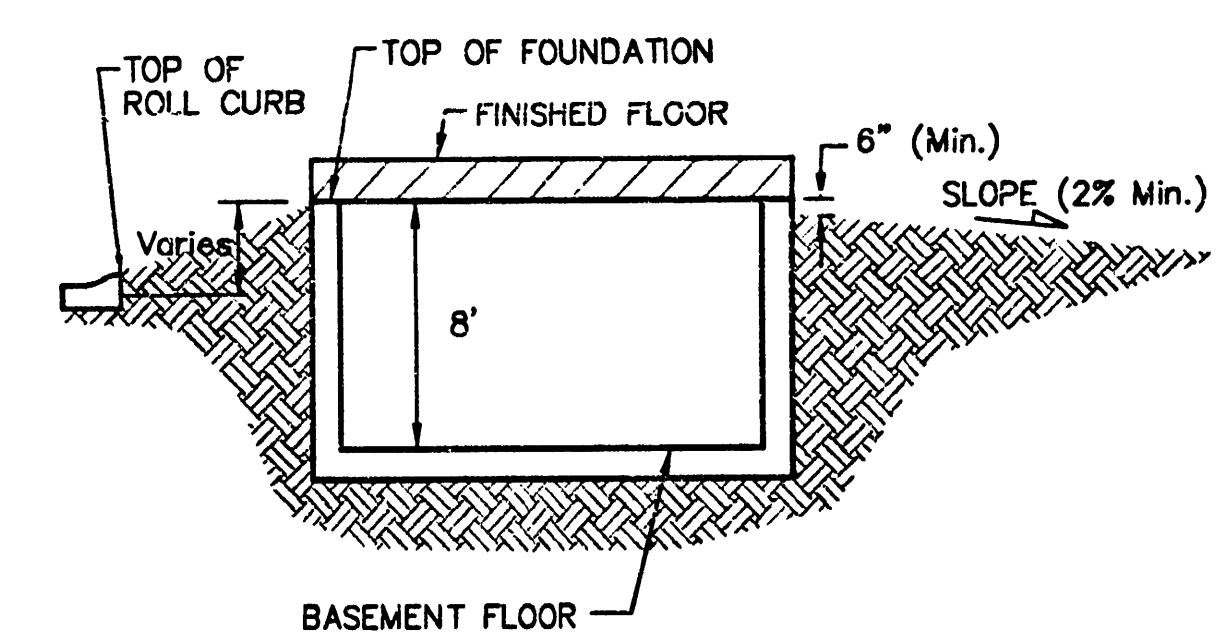

TYPICAL NON-VIEW OUT
NO SCALE

NOTES:

Lot dimensions have been omitted on this plan, refer to the recorded plat for this information.



Grading Plan

Basehman Company, P.A. 315 Ellis St. Wichita, KS 67211 P 316-262-7271 F 316-262-0149

ENGINEERING | SURVEYING | PLANNING | LANDSCAPE ARCHITECTURE

PROJECT NUMBER	DESIGN MWS	DRAWN MWS
----------------	---------------	--------------

REVISIONS: 0303004 APPROVED DATE 09/29/04

9-30-2004		SCALE
11-23-2005	MWTS	

11-25-2005 MWS Noted
Adjusted loss 8-11, Block B SHEET

1 OF 1


H:\Grade\Hidgen Glen\Grade-new.dwg

APPROVED *Set*
12/8/05

DAMAGE PAGE

SUBMITTED 11/29/05

Update: 11-23-2005
Updated: 09-30-2004