


SKETCH PLAT
JACOB'S ADDITION
 WICHITA, SEDGWICK COUNTY, KANSAS

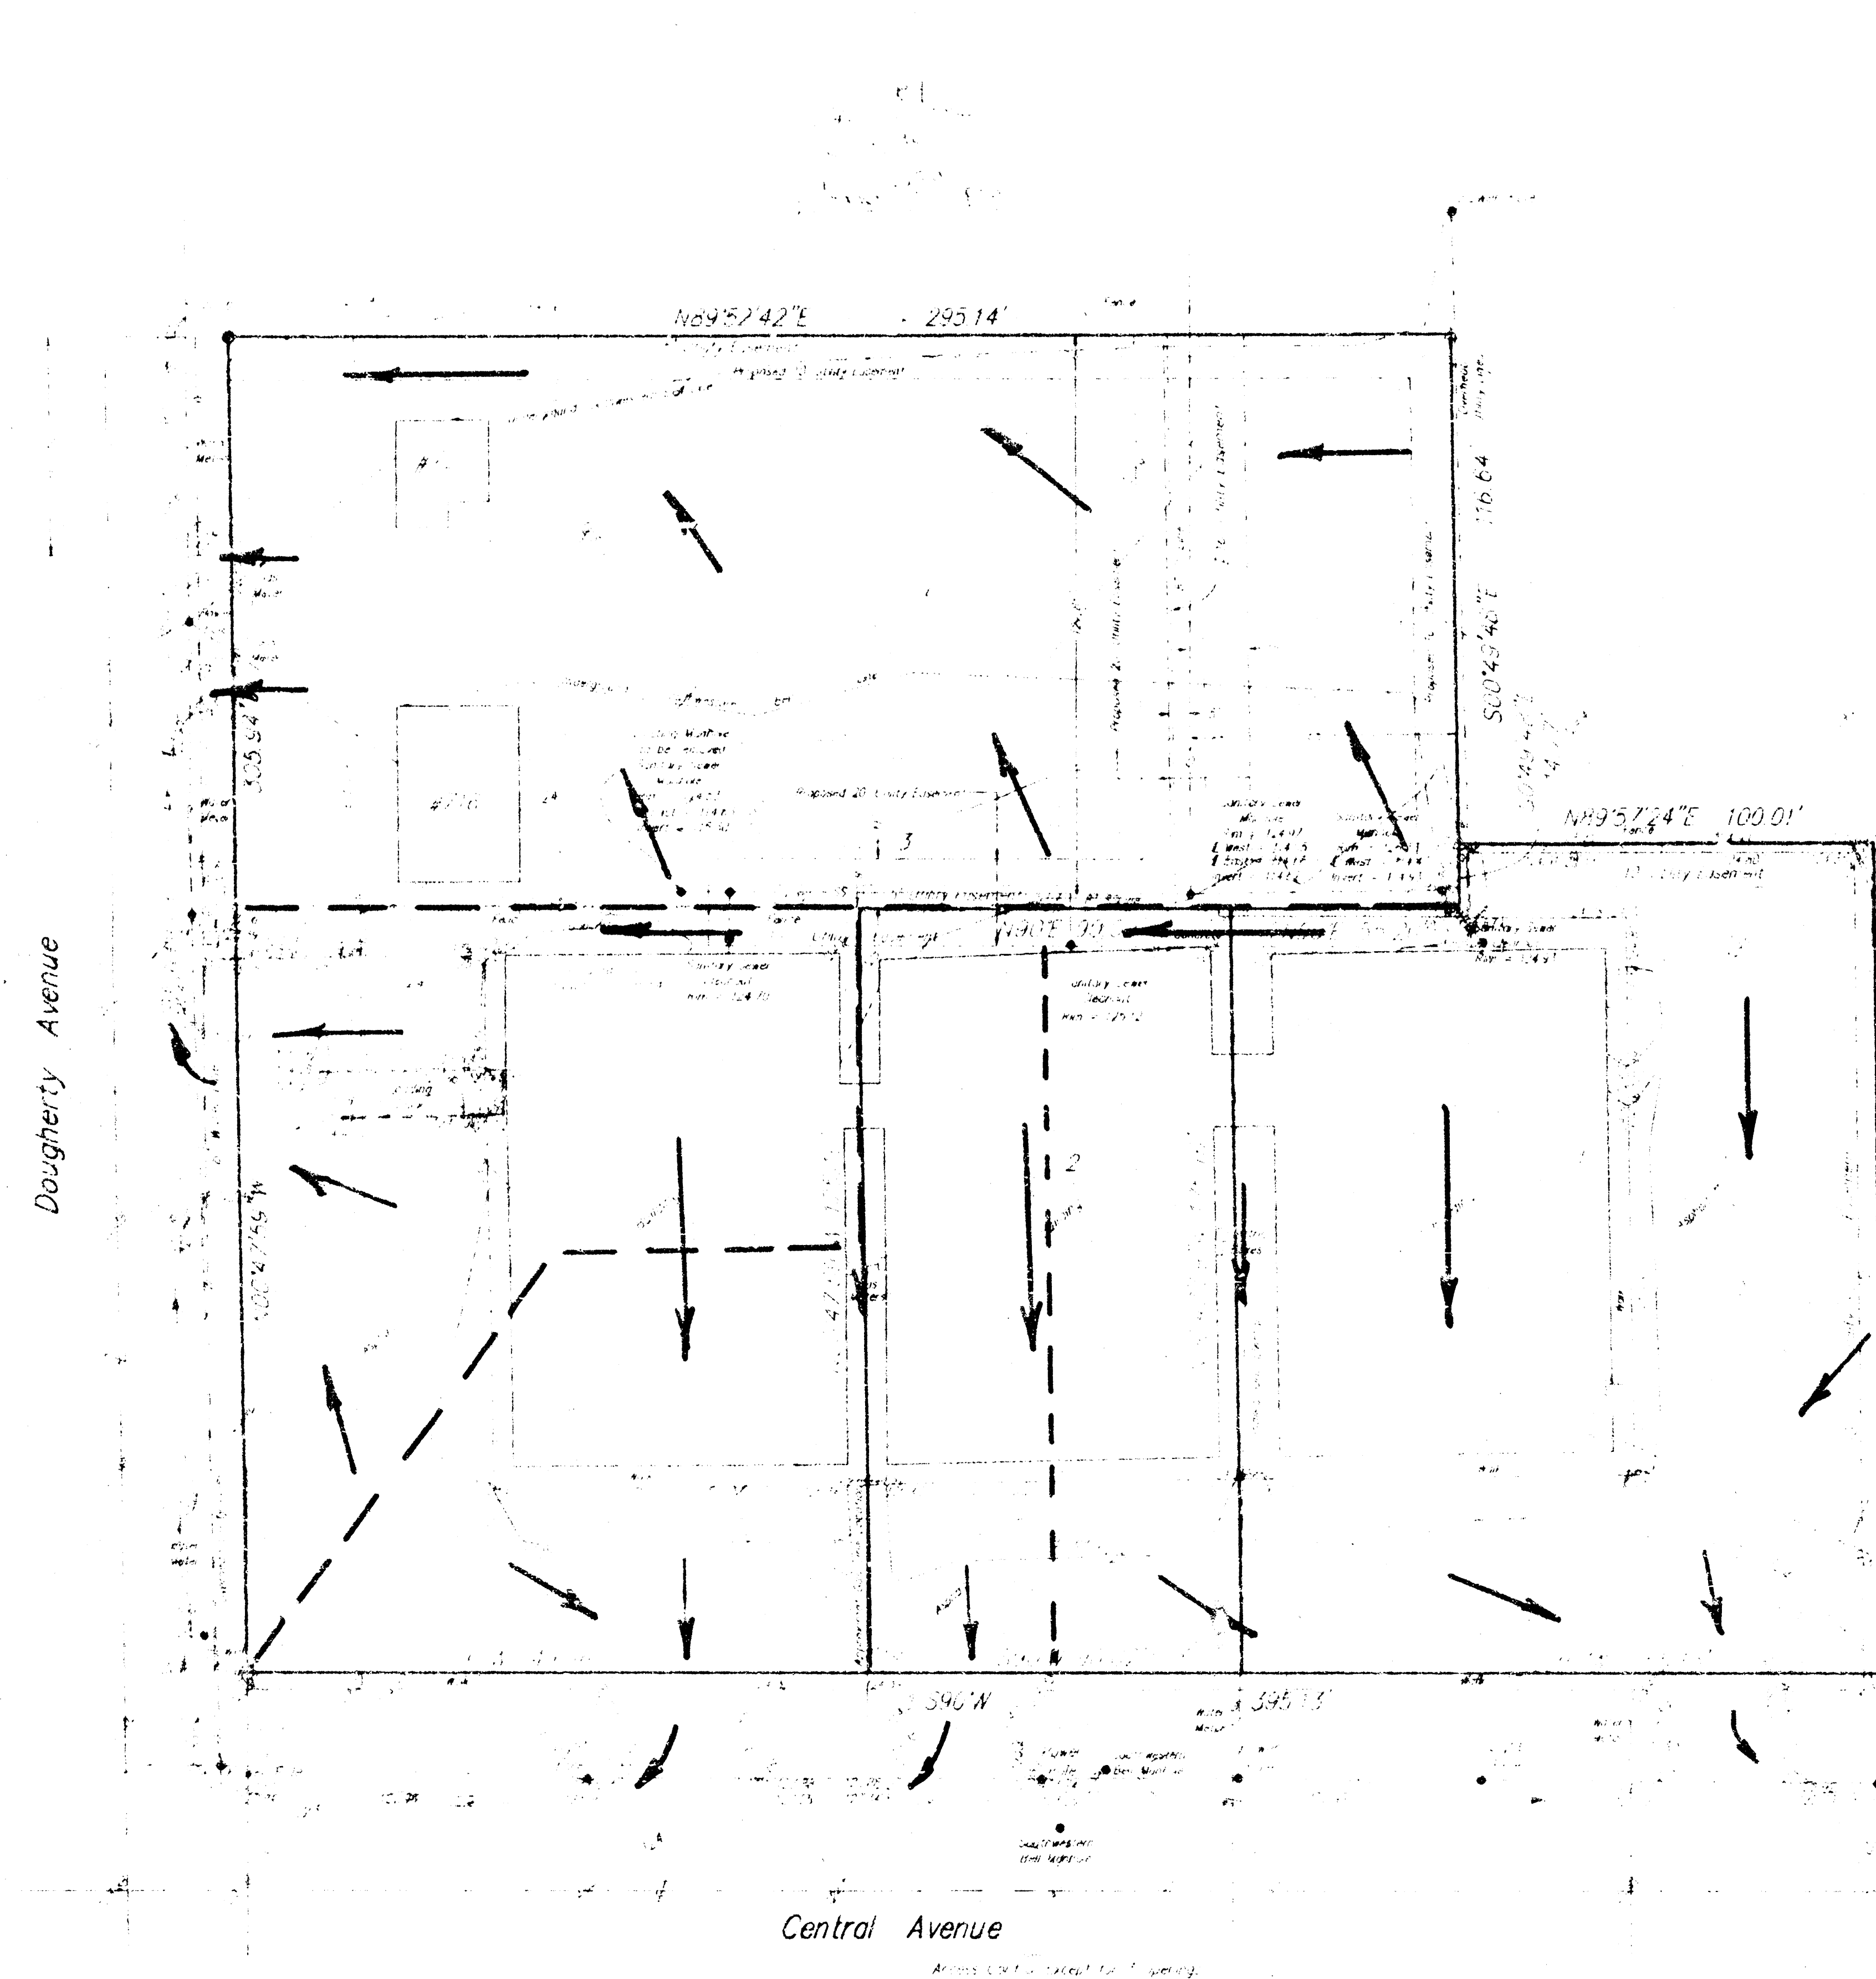

Notes:

