JESSE 2ND ADDITION

WICHITA, SEDGWICK COUNTY, KANSAS

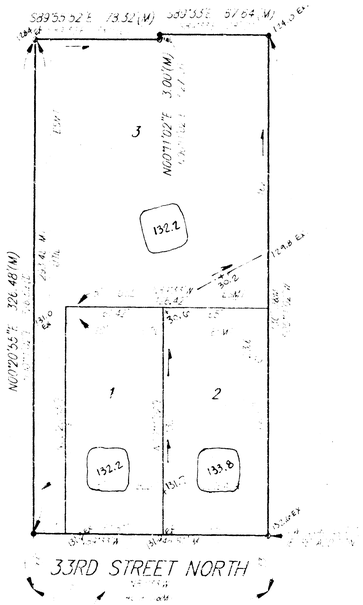

APPROVED
DRAINAGE PLAN

Subdivision Lot Grading Plan

June 7, 93

BAUGHMAN COMPANY P. A.
ENGINEERING & SURVEYING
316-264-7271 • 315 ELLIS • WICHITA, KANSAS 67211

SKETCH PLAT
JESSE 2ND ADDITION

WICHITA, SEDGWICK COUNTY, KANSAS

PART OF LOT 21, WALNUT GROVE ADDITION; &
PART OF LOTS 5, 6, 7, 8, & 9, WALNUT GROVE ADDITION

RICHARD P. JESSE
3201 WOODLAND
WICHITA, KS. 67204
PH: 838-4565

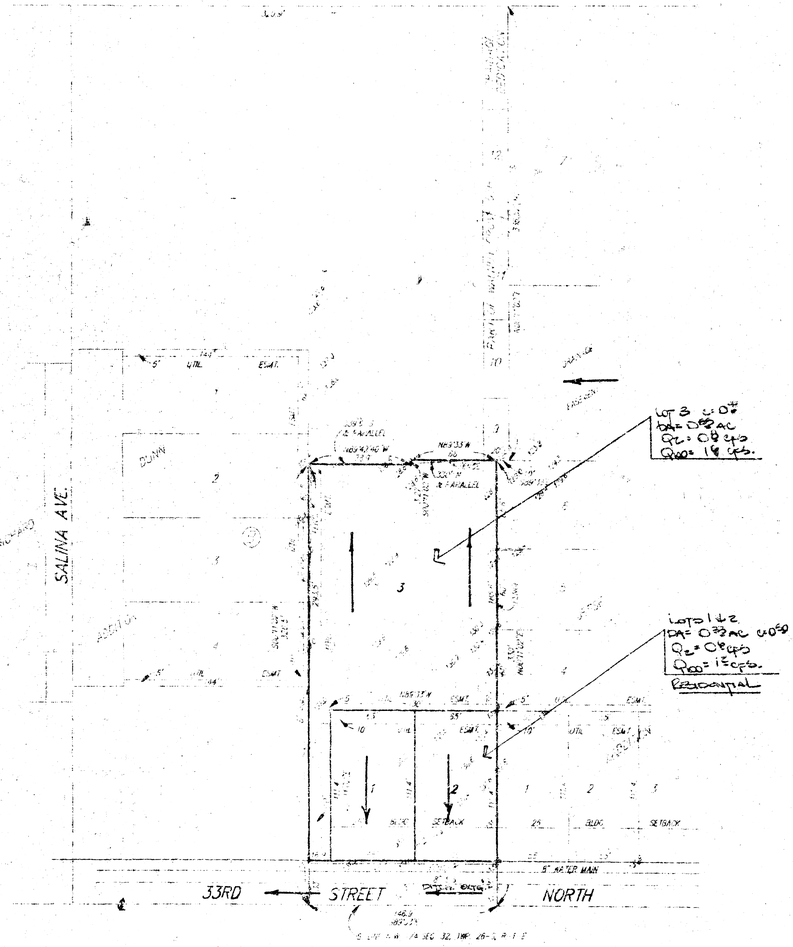

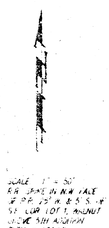

SCALE: 1" = 50'
R.P. JESSE IN N.W. 1/4 OF
SEC. 32-T26S-R1E
SE. COR. LOT 1, WALNUT
GROVE 5TH ADDITION
ELEV. = 1330.0

DRAINAGE PLAN

BAUGHMAN COMPANY P. A.
SURVEYING & ENGINEERING
316/262-7771 • 315 ELLIS • WICHITA, KANSAS 67211

29 SEP 1982