MARY KAY ADDITION
(Drainage)

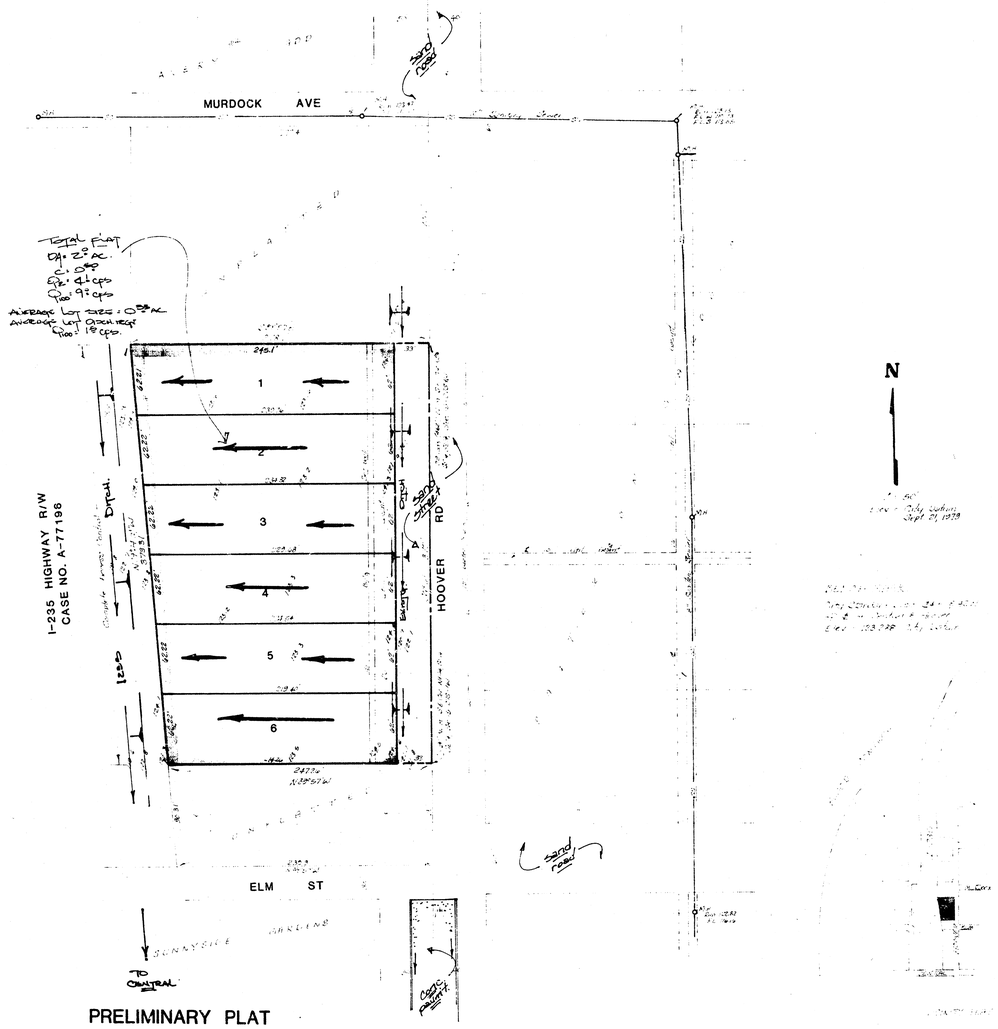

PRELIMINARY PLAT

MARY KAY ADDITION

TRACT IN THE SE1/4 OF SEC 15, TWP 27-S, R-1-W

JERRY D. LIVINGSTON
MARY KAY LIVINGSTON

DRAINAGE PLAN

BAUGHMAN COMPANY, P.A.
SURVEYING & ENGINEERING
316 262-7271 • 330 LAURA • WICHITA KANSAS 67211