
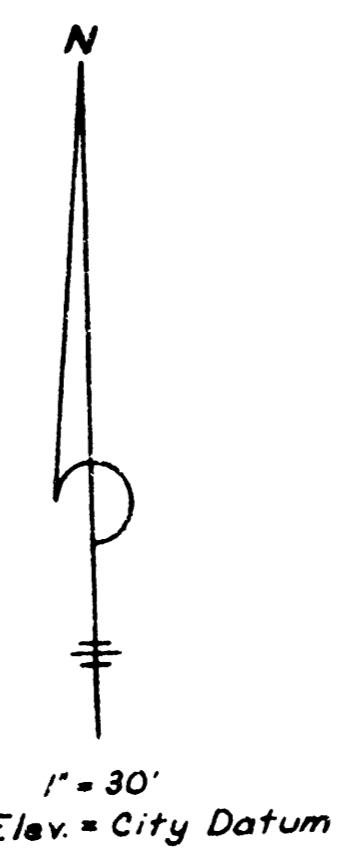


KEAGAN ADDITION  
(Drainage)

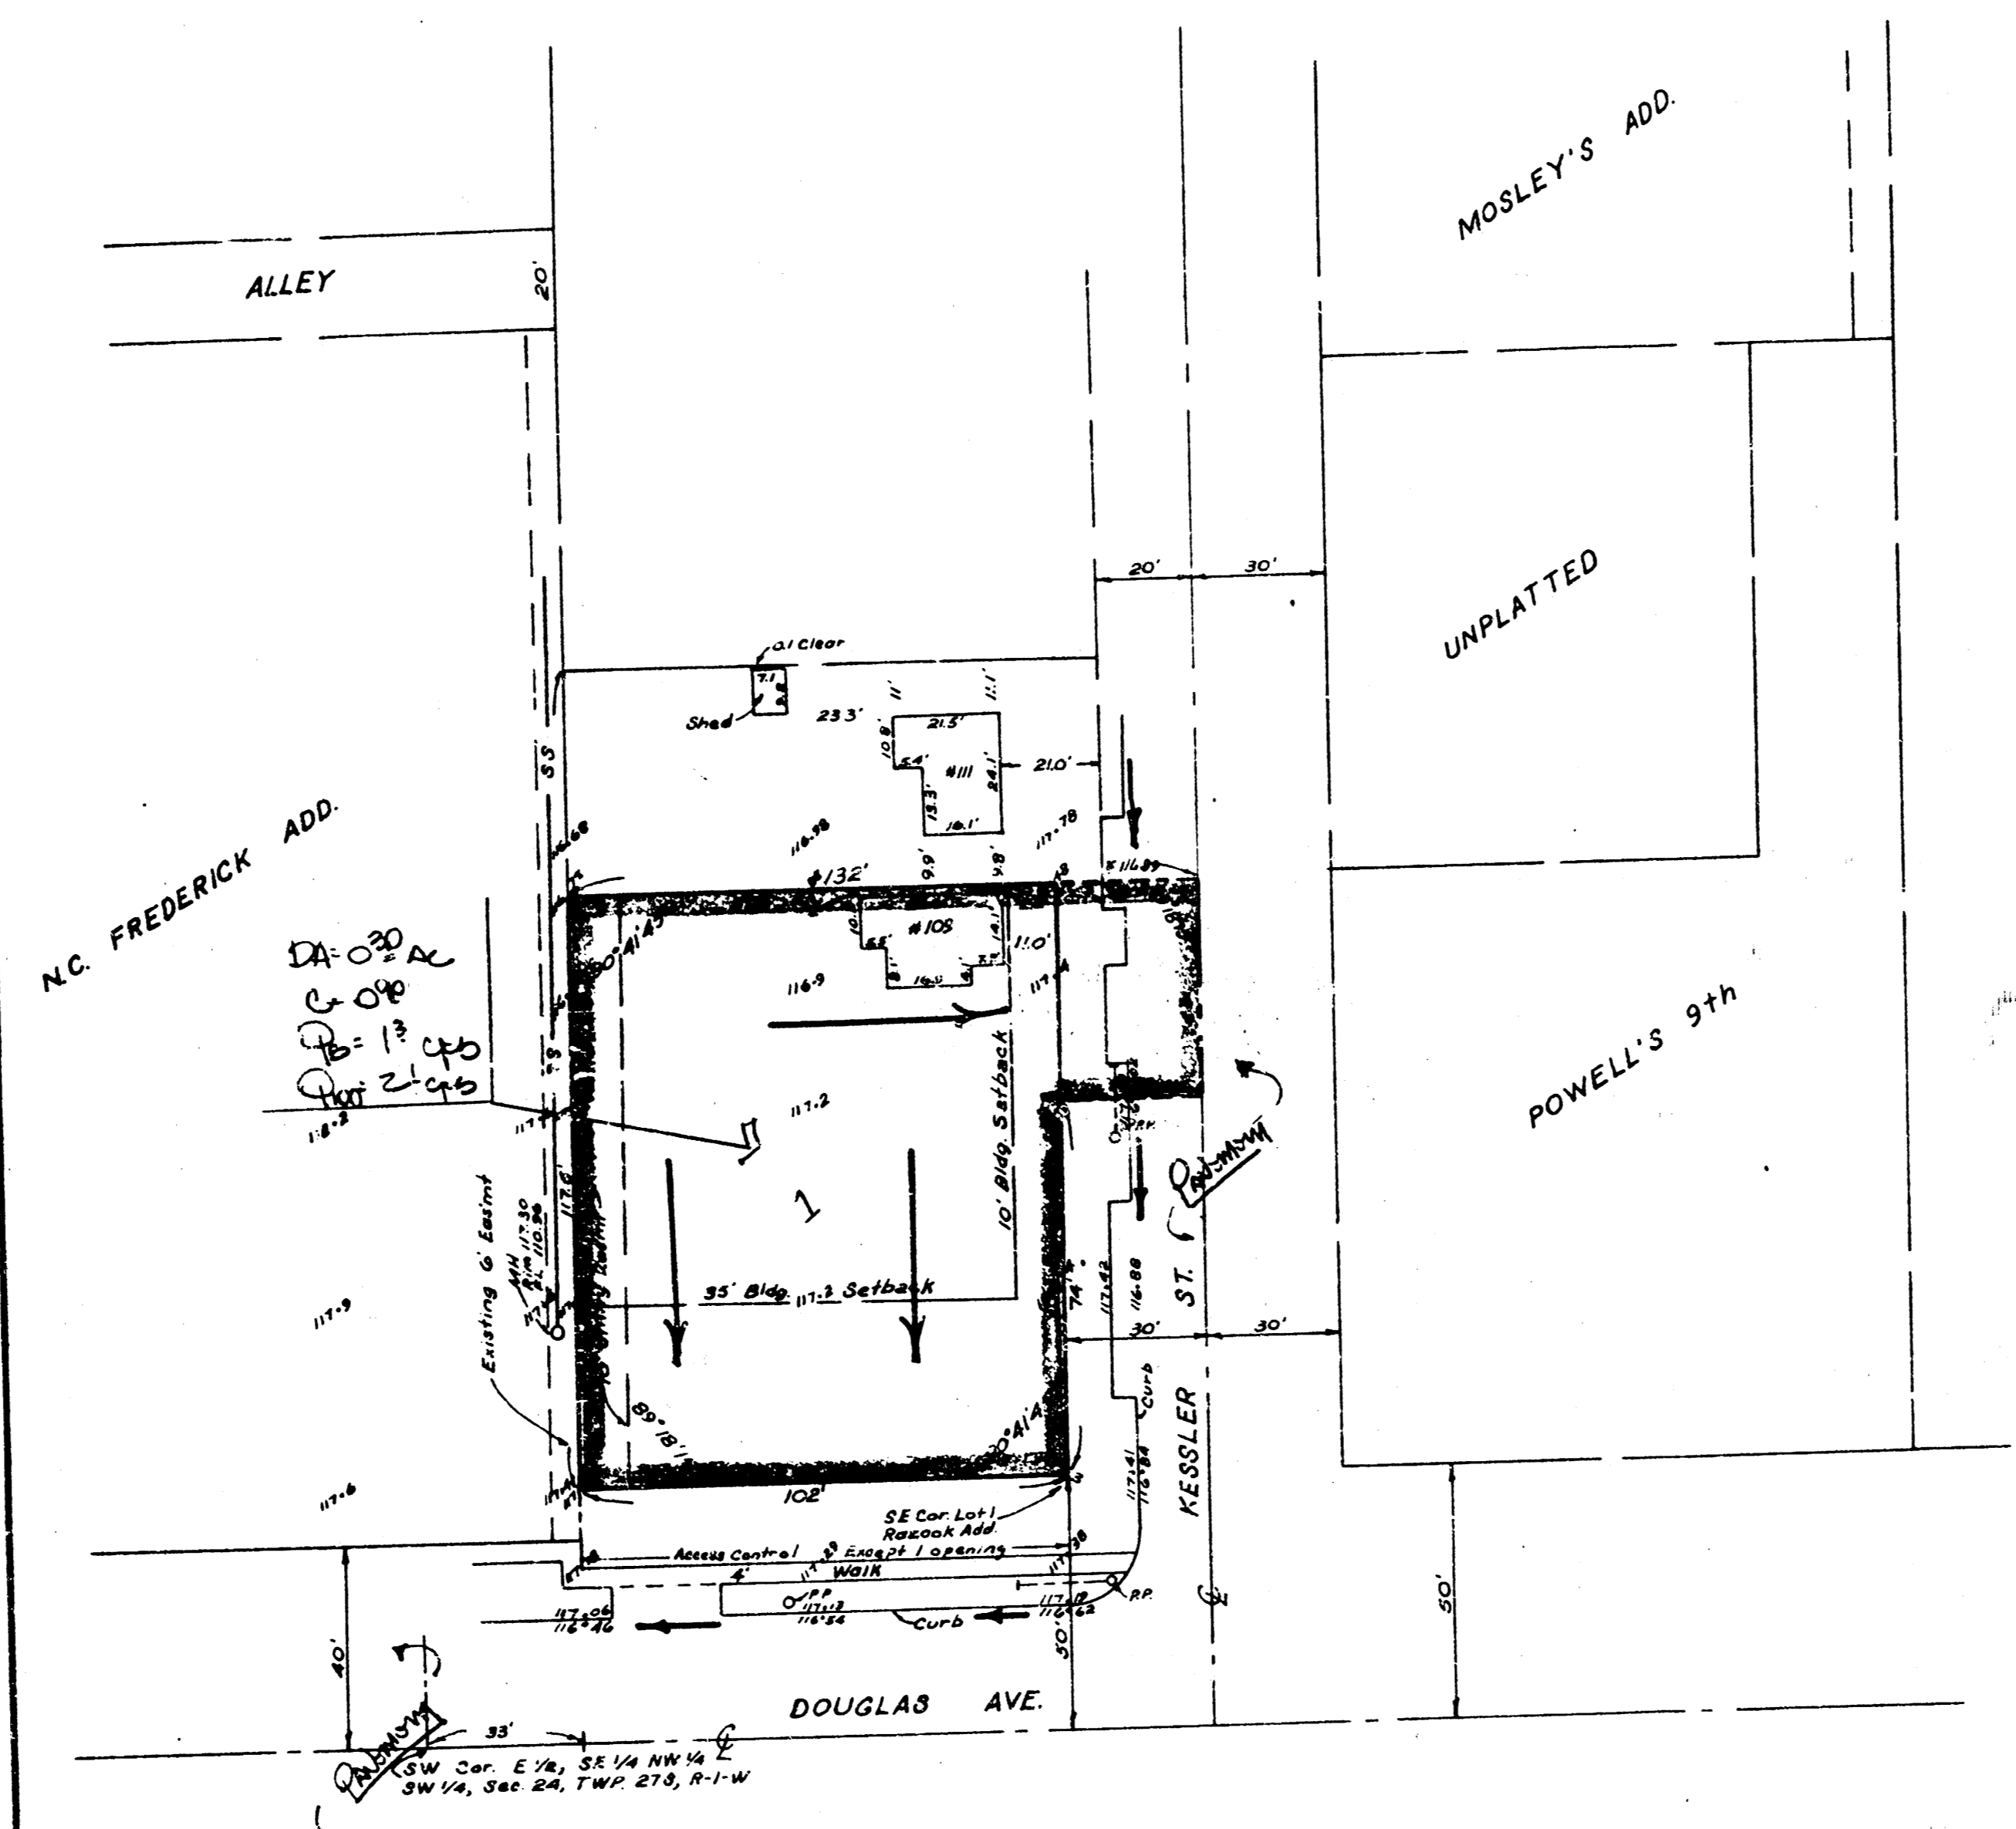

**BENCH MARK:**  
 a cut @ North end of Radius of curb  
 on east side of Kessler, north of  
 Douglas.  
 Elev. = 117.32 City Datum

**SKETCH PLAT**  
**KEAGAN ADDITION**  
 LOT 1 RAZOOK ADDITION &  
 PART OF THE SW 1/4, SEC. 24,  
 TWP. 27-S, R-1-W  
 OWNER: JERRY W. SELF  
 SHARON A. SELF

*General Note - This lot will be commercial with a runoff factor  
 of 0.90. Storm water runoff will discharge to the  
 street thru downspouts. Kessler drains south and  
 Douglas drains west.*

**DRAINAGE PLAN**

**BAUGHMAN COMPANY, P.A.**  
 SURVEYING & ENGINEERING  
 316 ELLIS • WICHITA, KANSAS 67211