
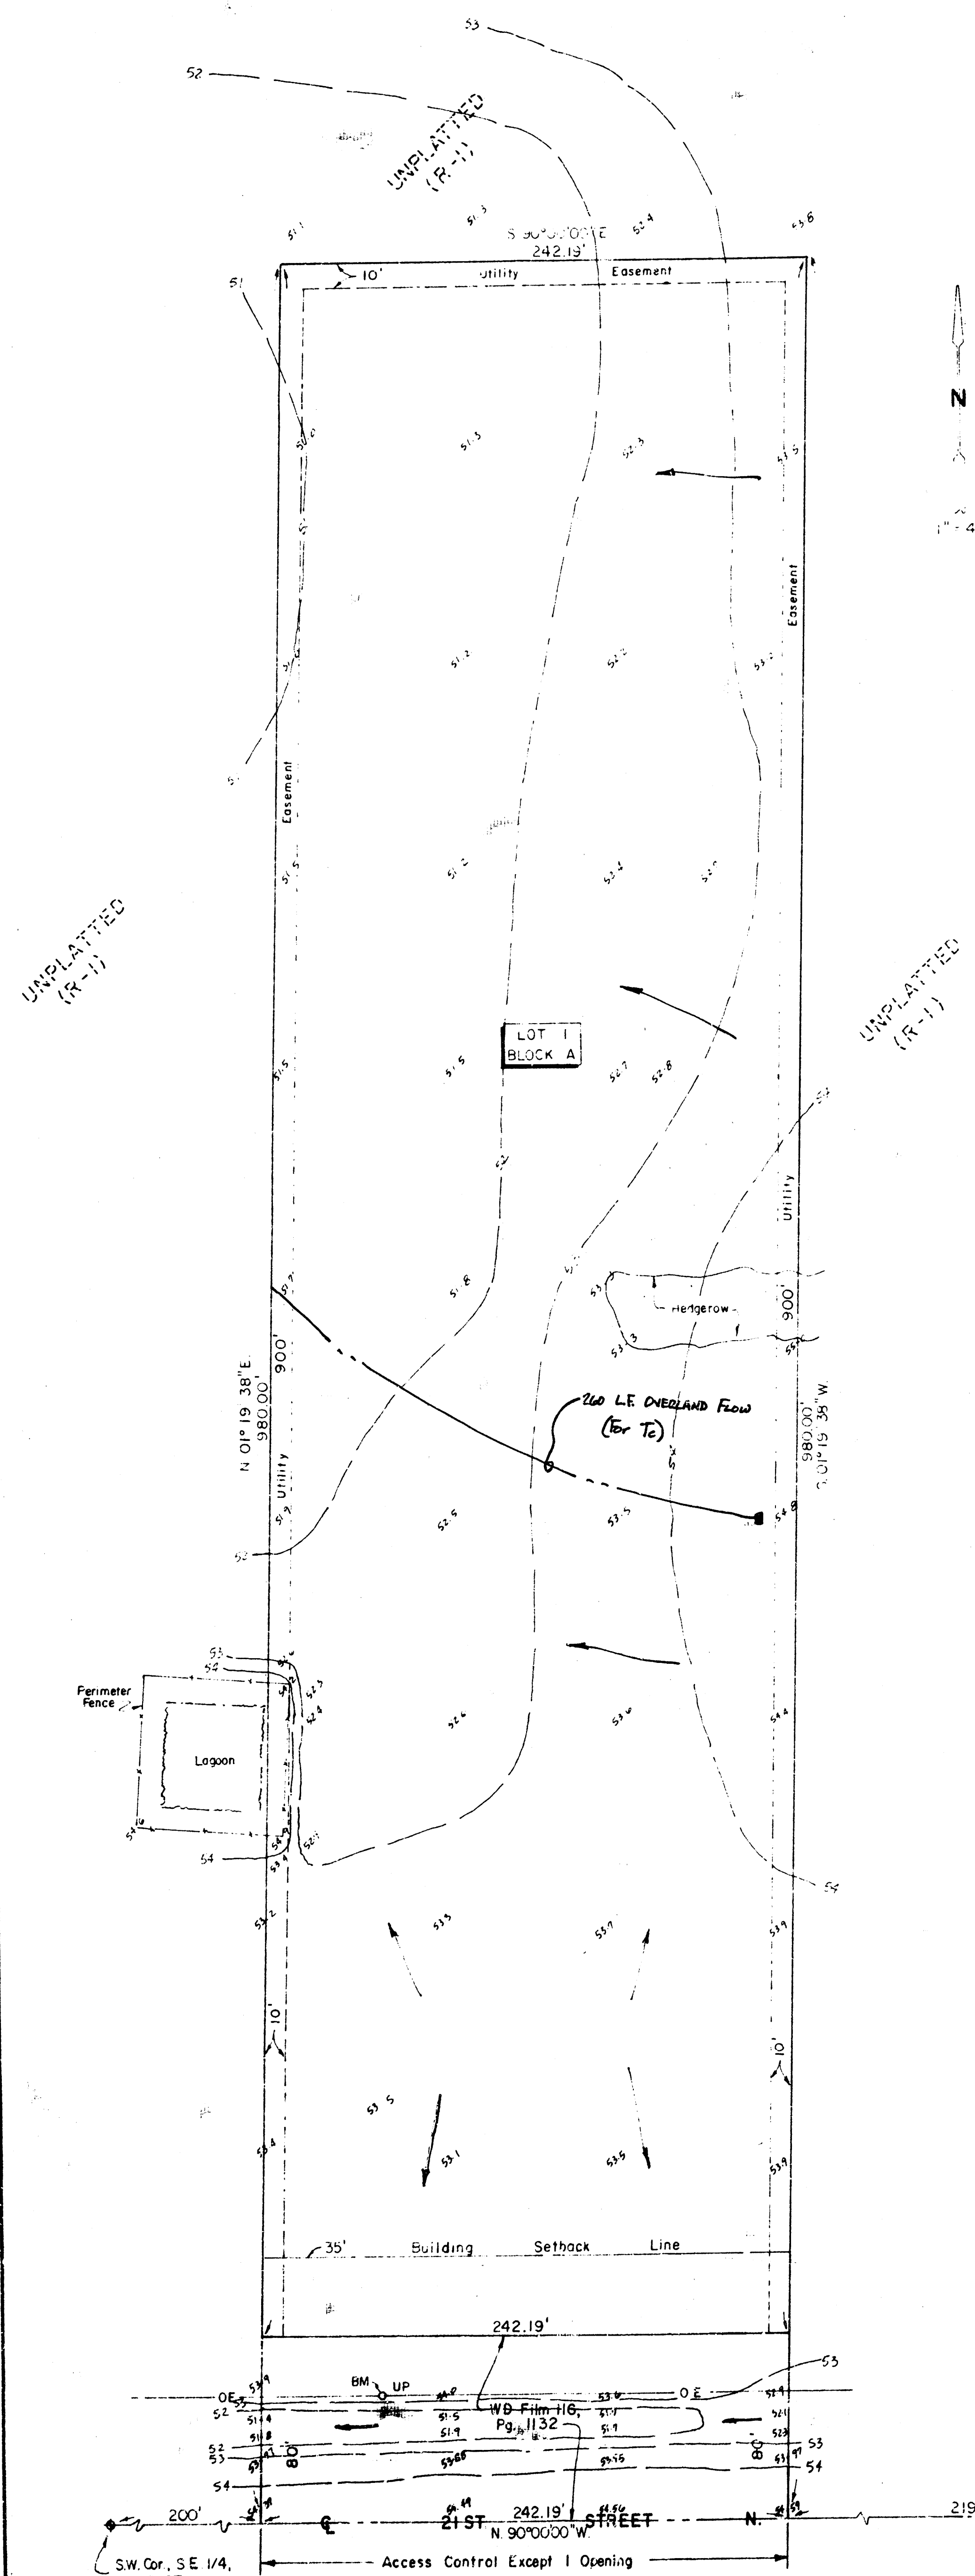
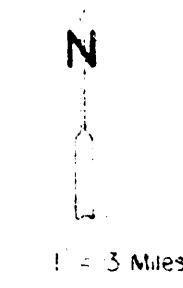


JACKIE KELLEY ADDITION WICHITA, SEDGWICK CO., KANSAS

- LEGAL DESCRIPTION -


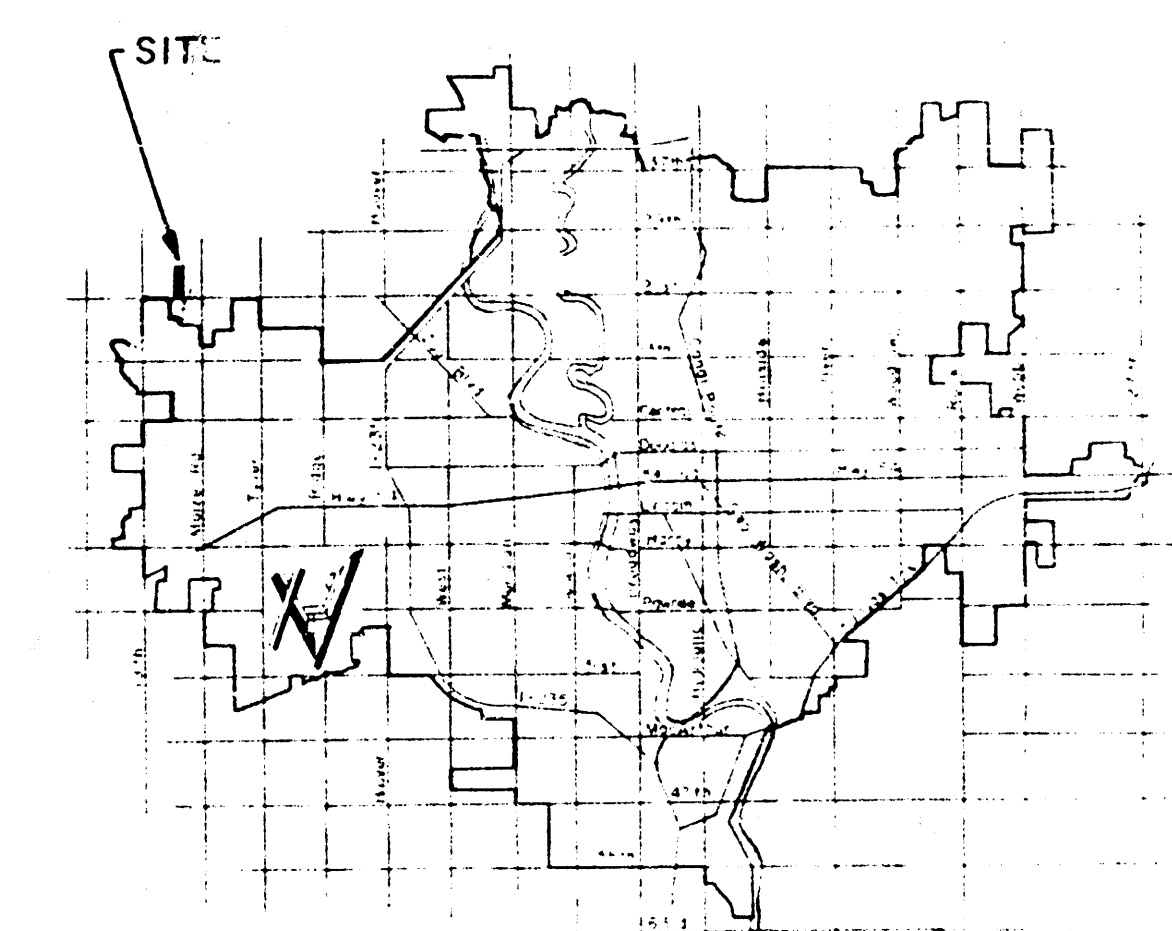

- BENCHMARK -
BM - 11 - Utility Pole, 65' E
of 11' N of S.W. Prop. Cor.
Elev. = 1354.34 M.S.L.
Note - Add 1300.00 to spot
elevations to convert to M.S.L.

**MOEHRING & ASSOCIATES
CONSULTING ENGINEERS
WICHITA
JUNE, 1991**