


Kratzke

7

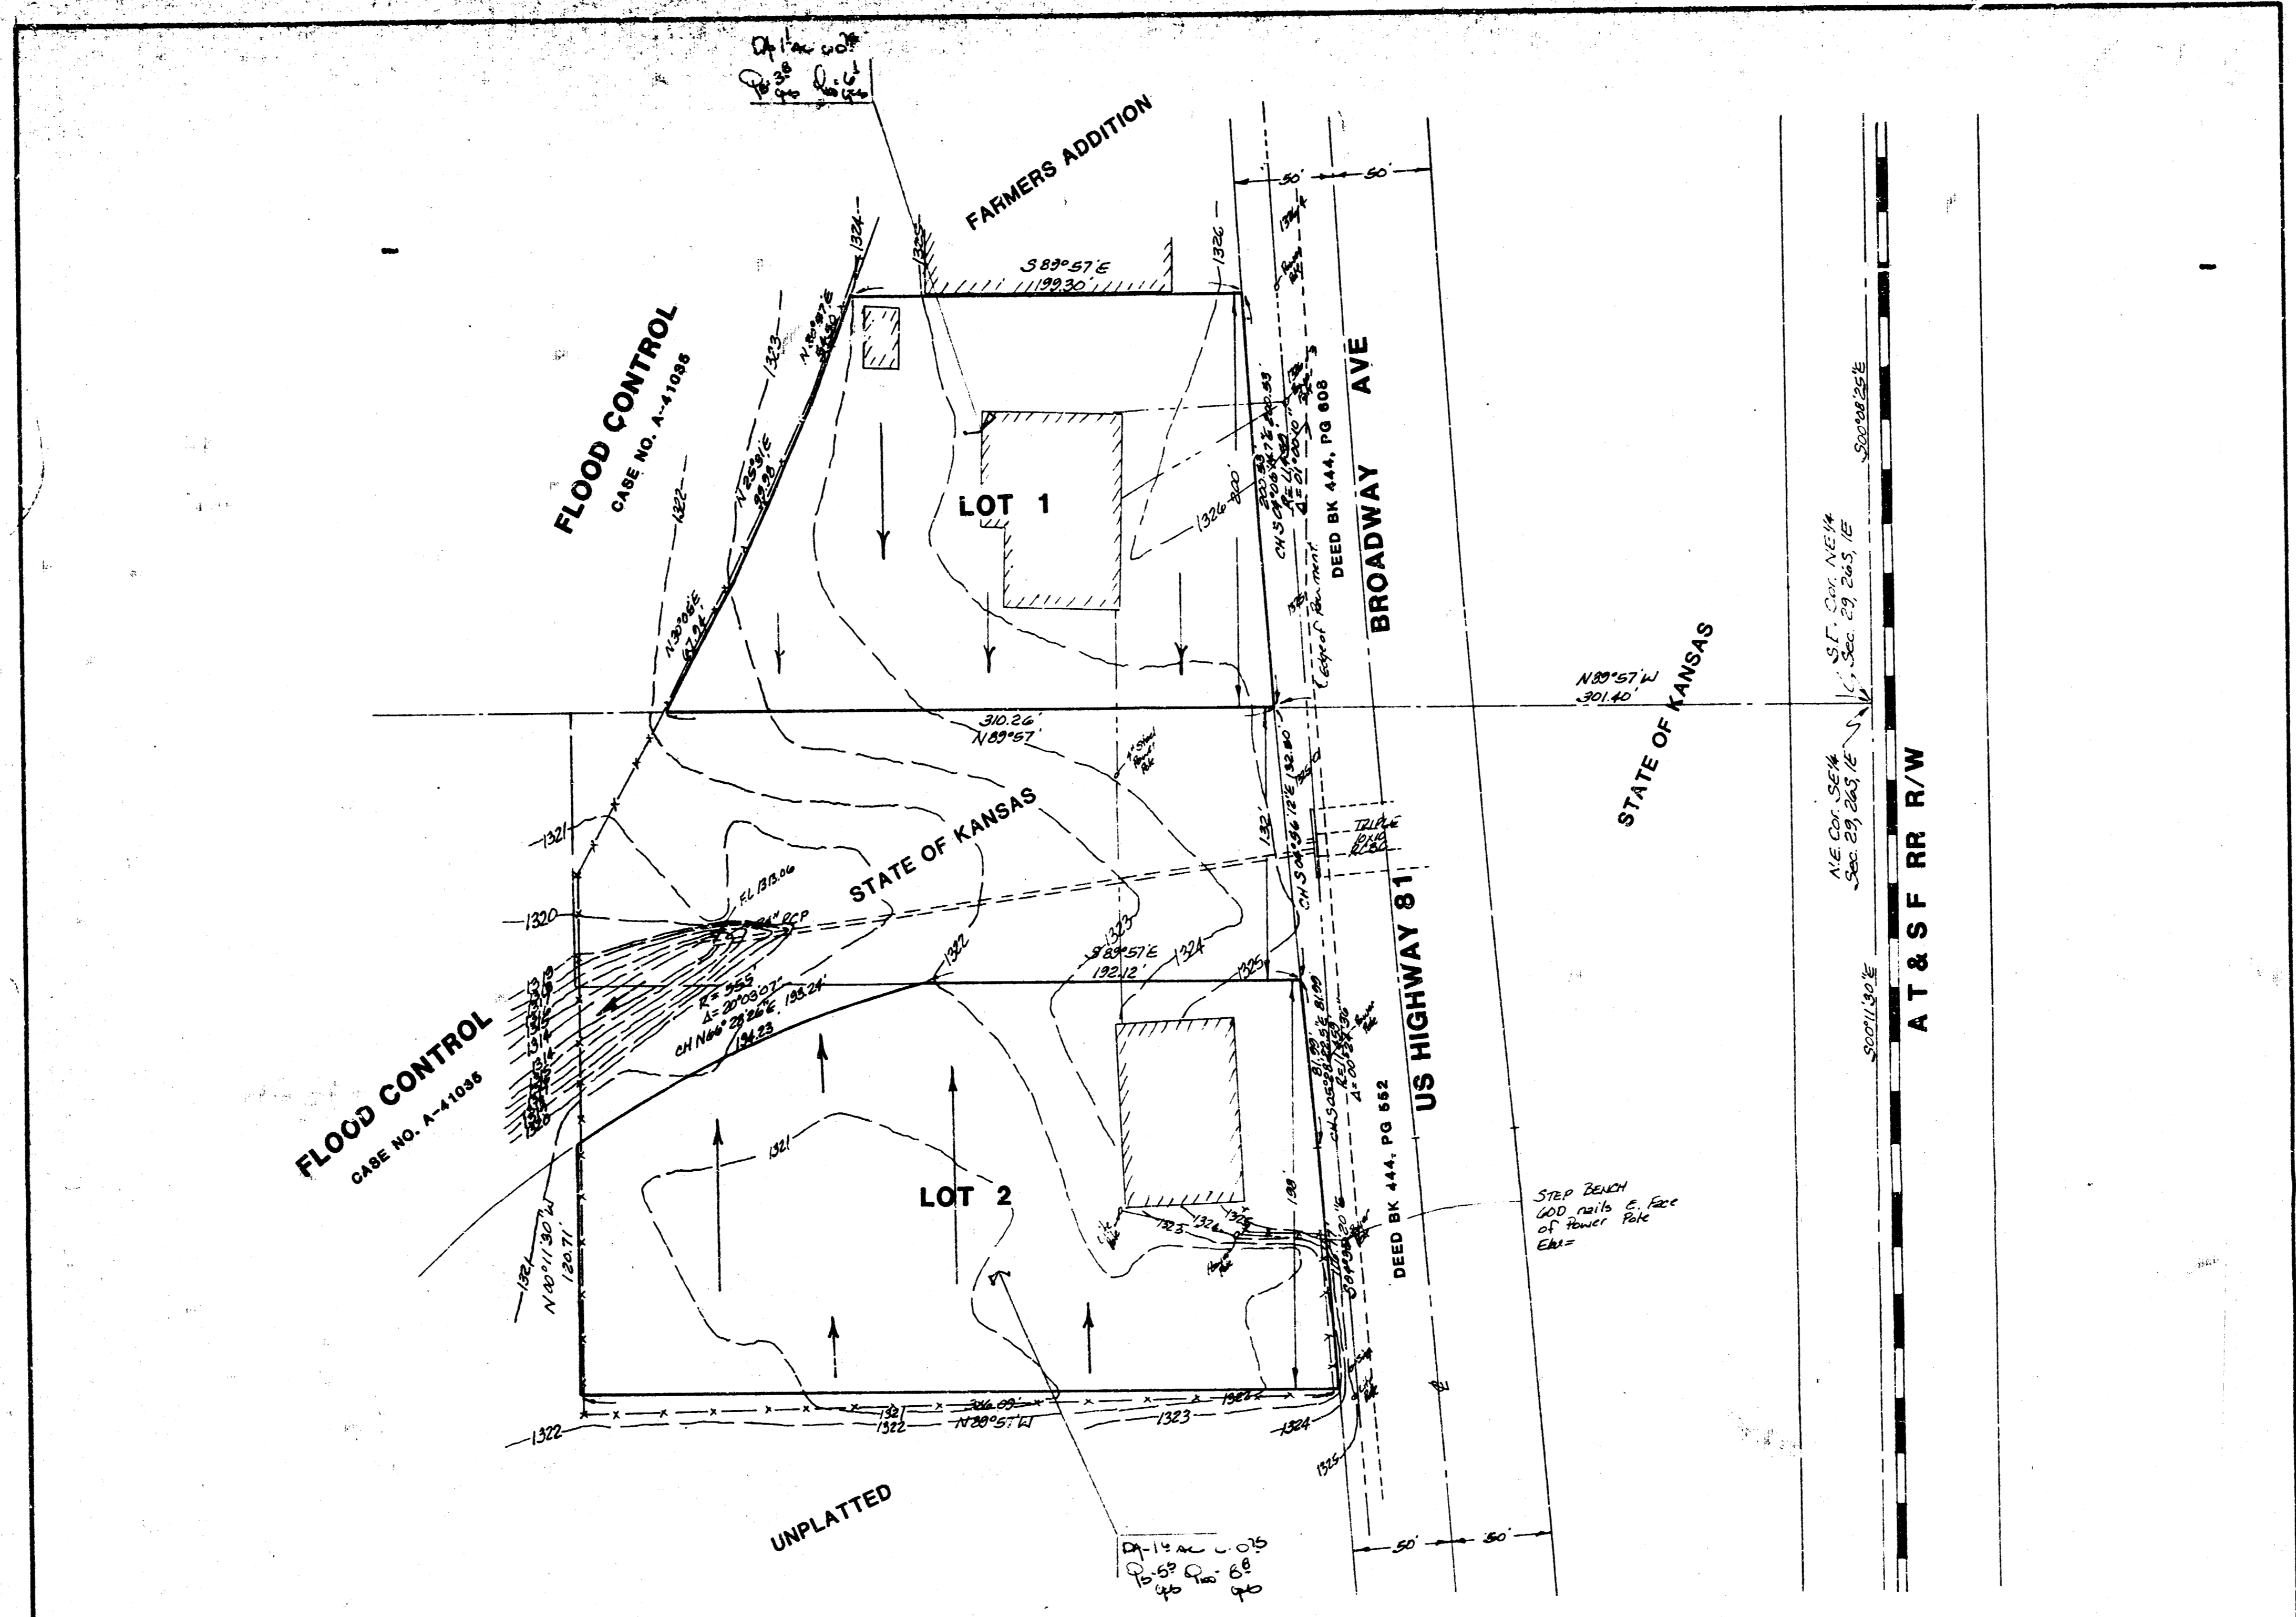

SKETCH PLAT
KRATZKE'S ADDITION
 WICHITA, KANSAS

N
 1" = 50'
 ELEV = M.S.L.



NOTE
 The 2 commercial lots will drain to the place shown according to the left hand plans or appropriate streets as necessary on the job if so required.

LAWRENCE O. KRATZKE

DRAINAGE PLAN

BAUGHMAN COMPANY, P.A.
 SURVEYING & ENGINEERING
 316282-7271 • 315 ELLIS • WICHITA, KANSAS 67211

10 FEB 80