



LANSLOWNE ADDITION  
(Drainage)

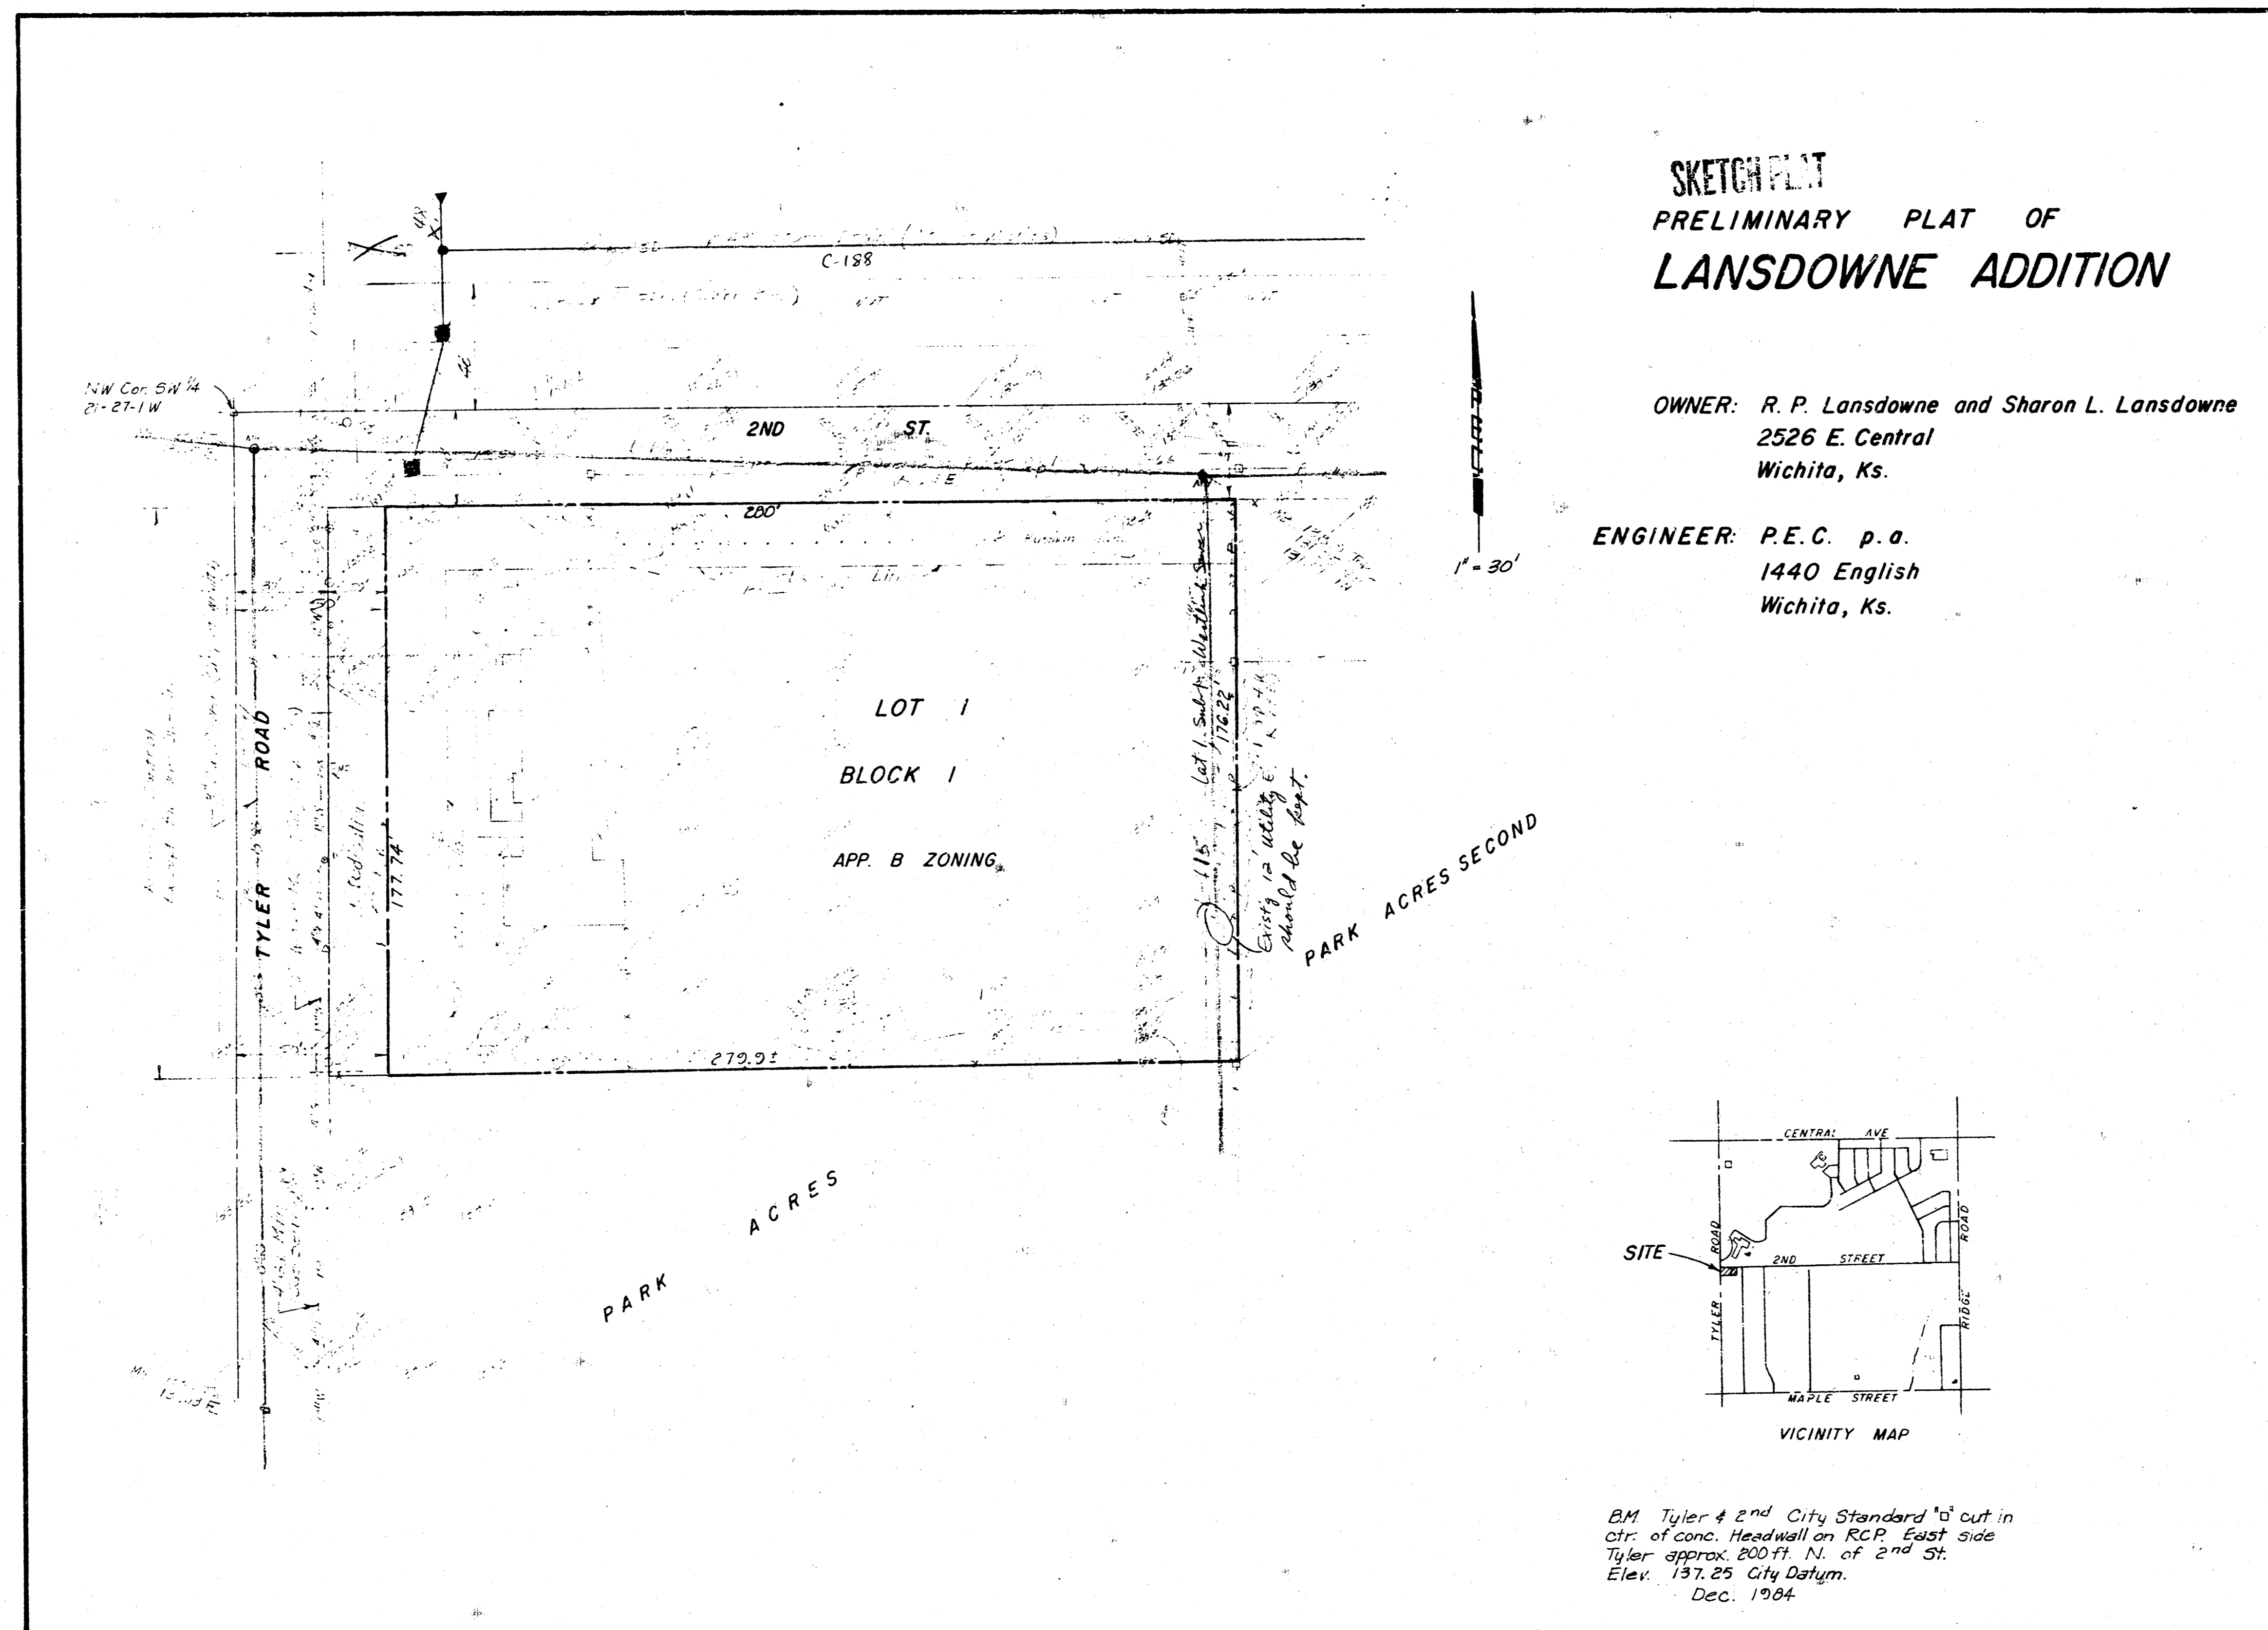

**SKETCH PLAT  
PRELIMINARY PLAT OF  
LANSLOWNE ADDITION**

**OWNER: R. P. Lansdowne and Sharon L. Lansdowne  
2526 E. Central  
Wichita, Ks.**

**ENGINEER: P.E.C. p.a.  
1440 English  
Wichita, Ks.**

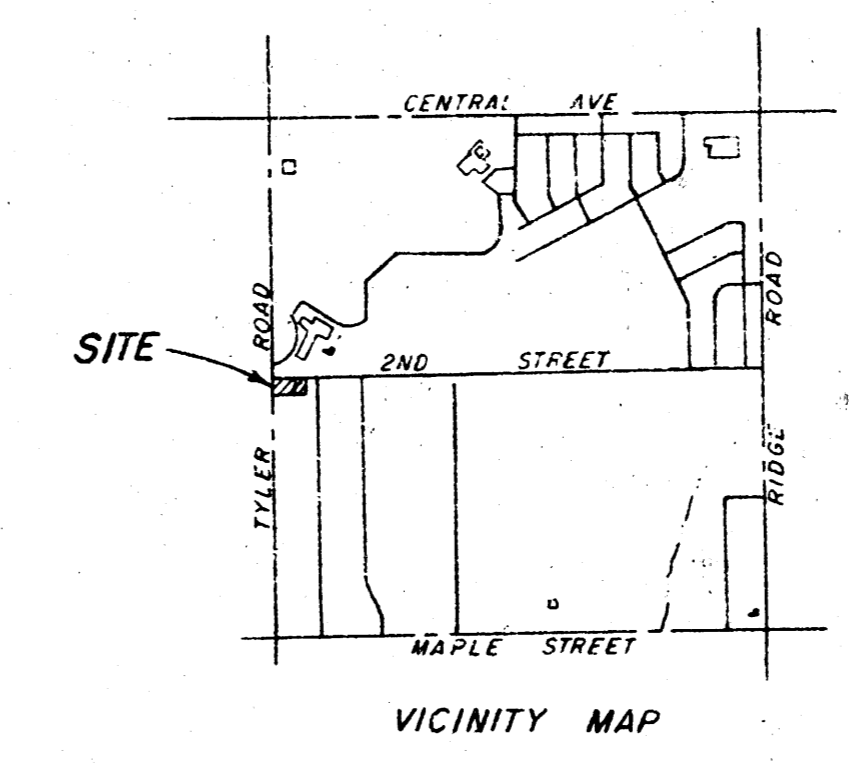

BM Tyler 4 and City Standard 13 cut in  
cfr. of conc. headwall on RCD East side  
Elev. 137.25 City Datum.  
Dec. 1984