


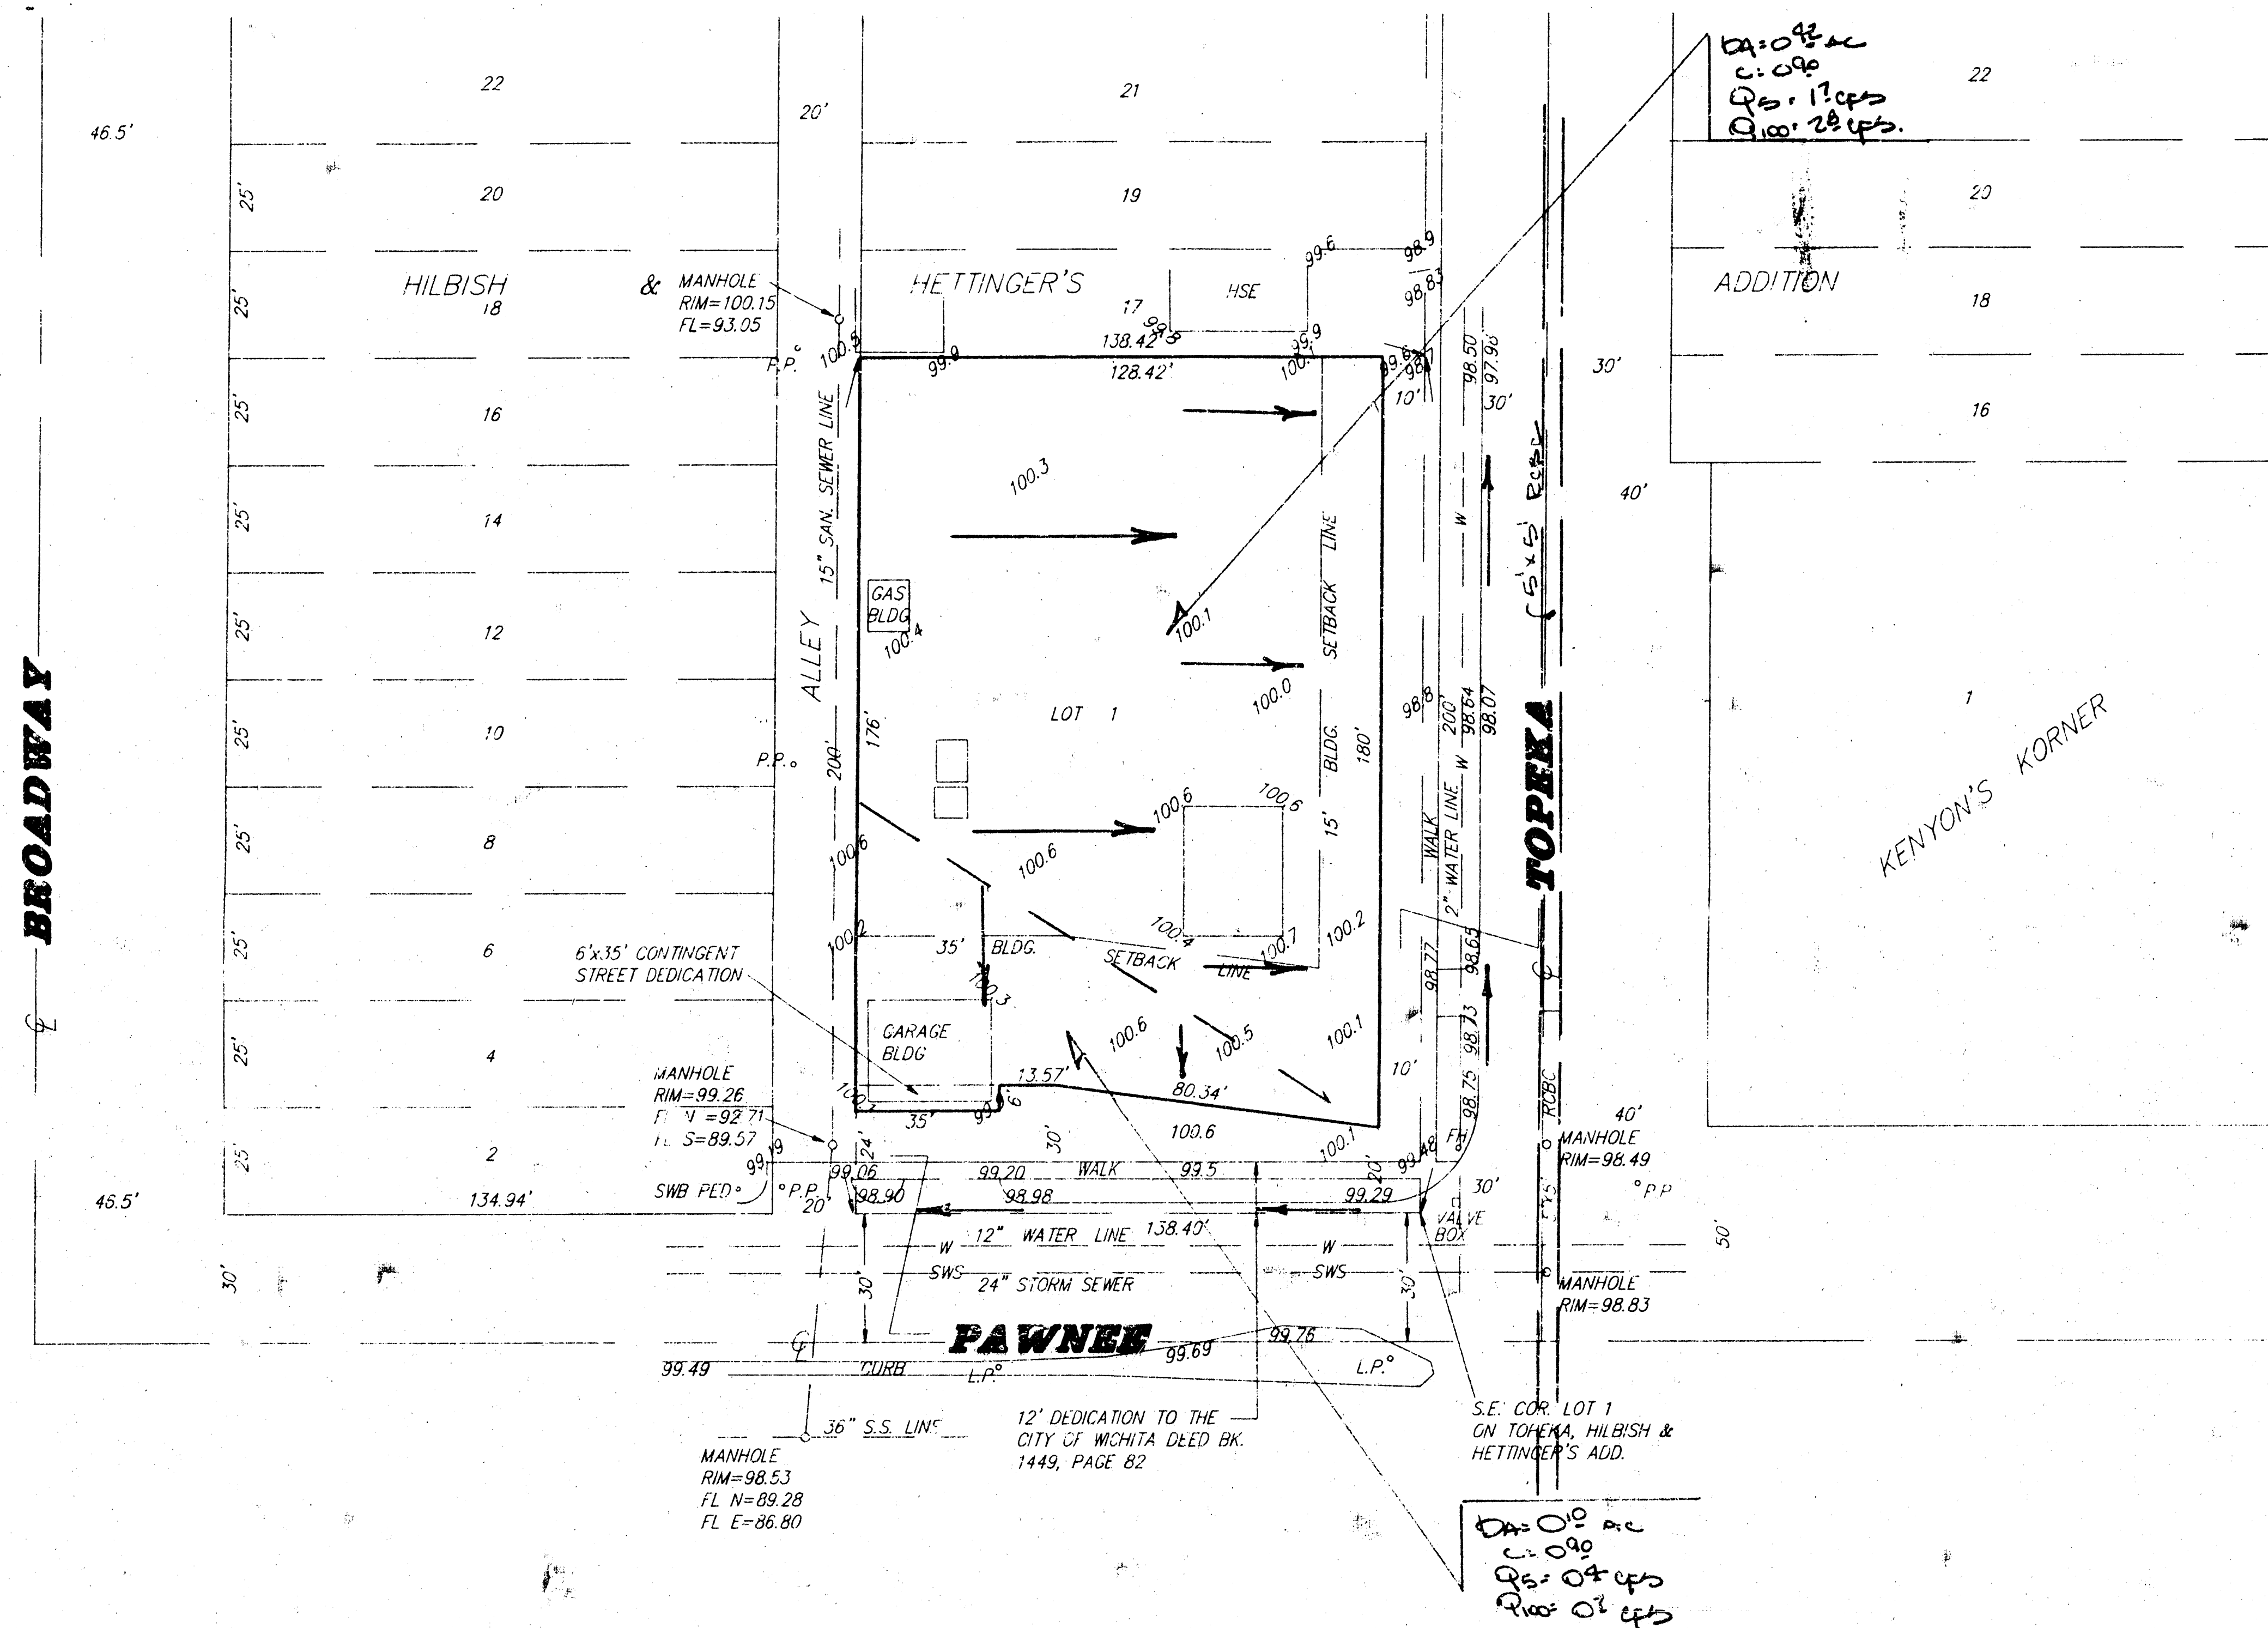

**SKETCH PLAT**  
**LATHROM ADDITION**

BEING A REPLAT OF LOTS 1, 3, 5, 7, 9, 11, 13, & 15,  
 TOPEKA AVE., HILBISH & HETTINGER'S ADDITION, WICHITA,  
 KANSAS

OWNER:  
 LINDA CHILDRES

**DRAINAGE PLAN**