


**DRAINAGE PLAN FOR:  
LORAC FIRST ADDITION  
WICHITA, SEDGWICK COUNTY, KANSAS**

**LEGAL DESCRIPTION:**  
Lots 14, 15, 16, 1000.

Area #	Area	Undeveloped				Developed	
		Q <sub>1</sub>	Q <sub>2</sub>	Q <sub>3</sub>	Q <sub>4</sub>	Q <sub>5</sub>	Q <sub>6</sub>
1	0.29	4.56	7.37	0.0	1.7	1.0	1.8
2	0.63	4.56	7.37	2.0	3.8	2.2	4.7
3	0.61	4.56	7.37	1.9	3.6	2.1	3.8
TOTAL	1.53	4.56	7.37	4.8	8.1	5.1	10.3

**NOTES:**  
1. Property is already developed, planned expansion will have same 1/4" catchment pattern.  
2. New development should follow drainage patterns shown.

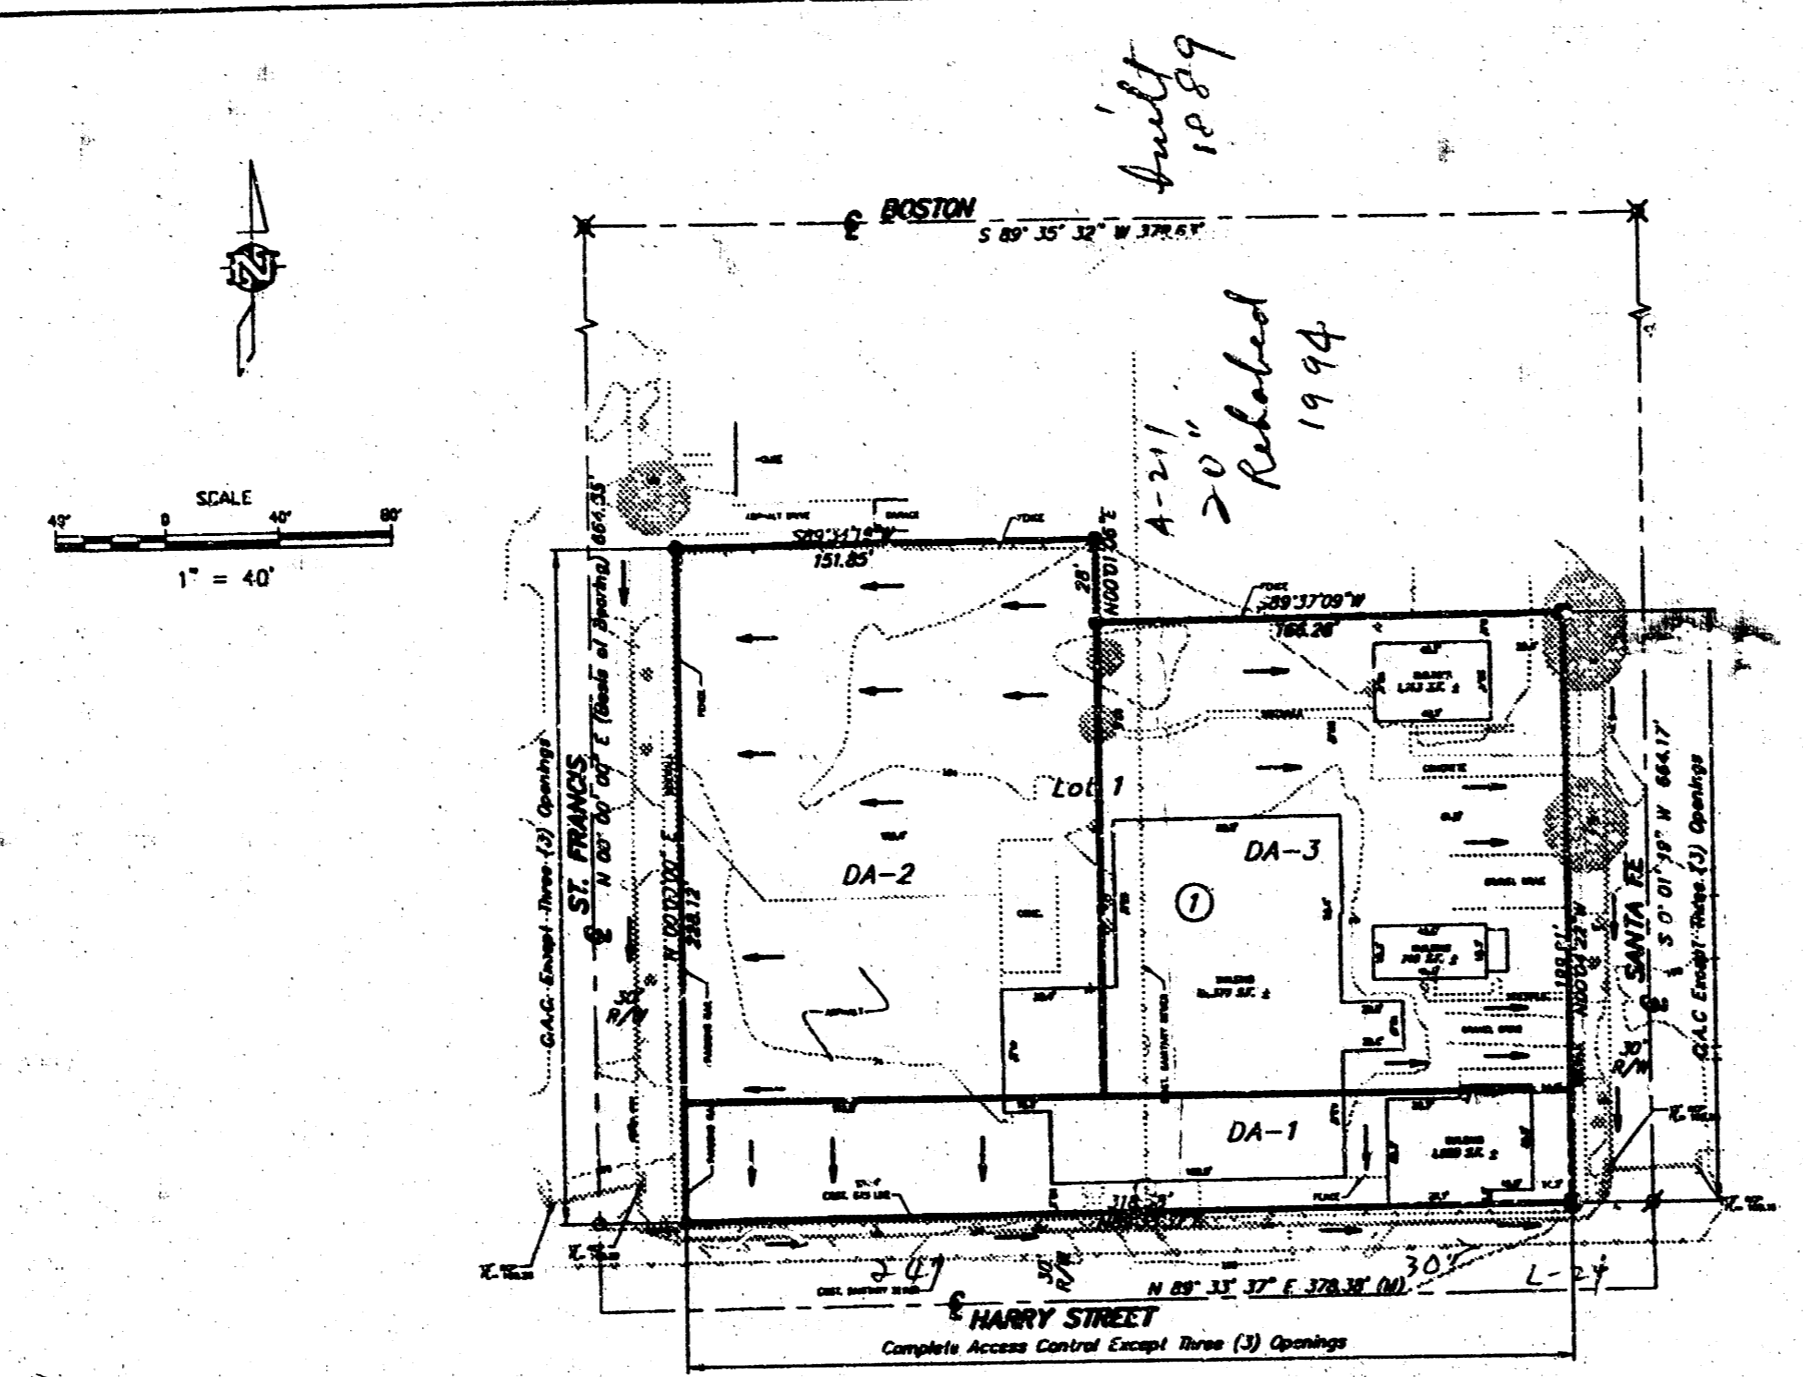

- LEGEND:**
- Gas Meter & Regulator
  - Sanitary Sewer Manhole
  - Power Pole
  - Tree
  - Drain
  - Water Meter
  - Down Guy
  - Sign
  - Water Valve
  - Electric Meter
  - Gas Line
  - Fire Hydrant
  - 5/8" Riser (set) - AMPA CLS/104
  - V Out (set)
  - X Out (set)
  - 5/8" Riser (found)
  - 3/4" Iron in Riser (found)
  - 1" Iron in Riser (found)
  - 1 1/4" Iron in Riser (found)
  - (M) Measured
  - (P) Piped
  - (C) Calculated

