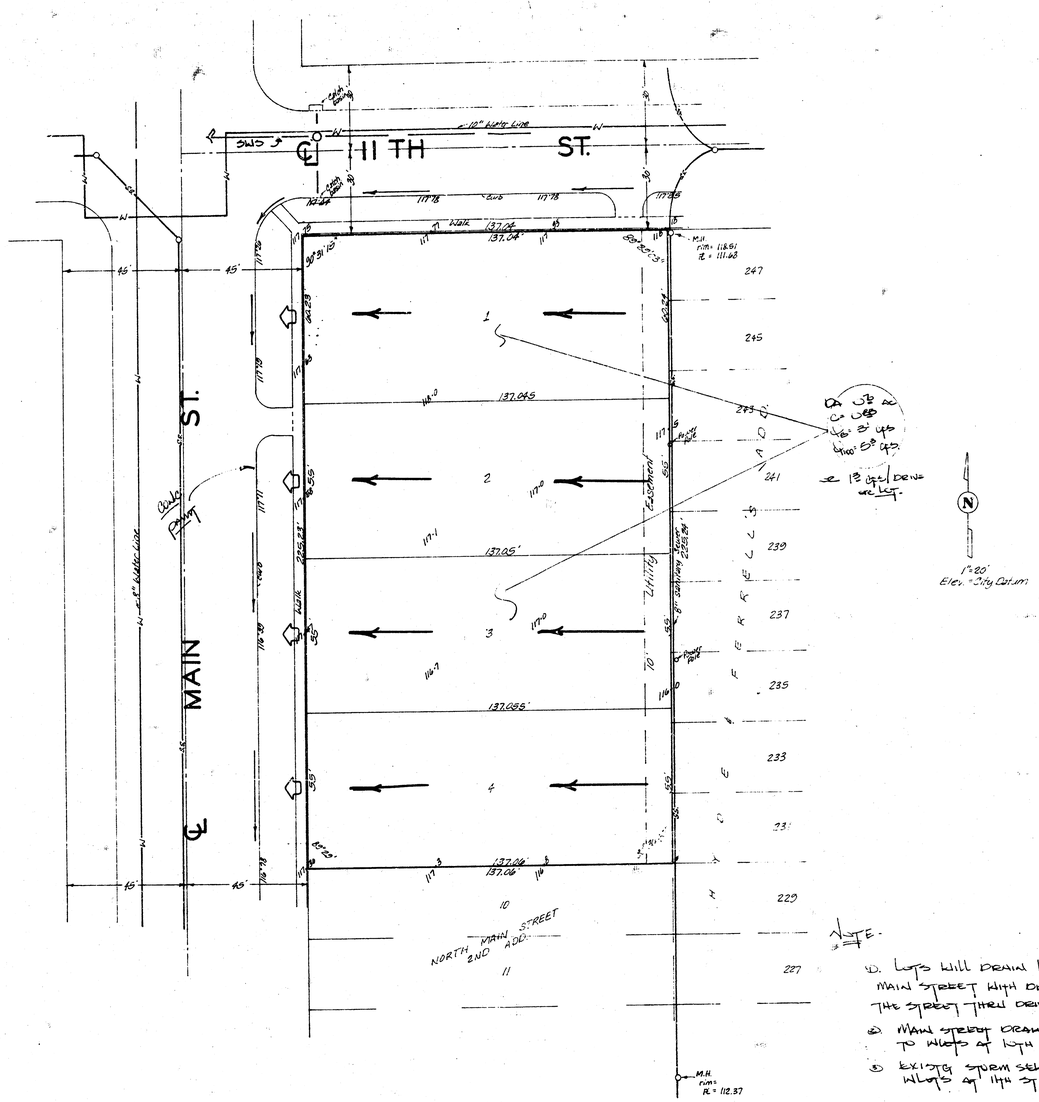

NOTE:

1. LOTS WILL DRAIN WEST TO MAIN STREET WITH DISCHARGE TO THE STREET THRU DRIVEWAYS.
2. MAIN STREET DRAINS SOUTH TO INLETS AT 11TH ST.
3. EXISTING STORM SEWER AND INLETS AT 11TH ST ARE INDICATED.

SKETCH PLAT
MIDTOWN 2ND ADDITION

LOT 1, BLOCK 1, NORTH MAIN STREET 3RD ADDITION TO WICHITA, SEDGWICK COUNTY, KANSAS AND LOTS 8 AND 9 ON MAIN ST. NORTH MAIN STREET 2ND ADDITION TO WICHITA, KANSAS

OWNER: CITY OF WICHITA

FINAL DRAINAGE PLAN

BAUGHMAN COMPANY, P.A.
SURVEYING & ENGINEERING
316/262-7271 • 330 LAURA • WICHITA, KANSAS 67211

4-13-84