



MURDOCK INDUSTRIAL ADDITION
(Drainage)

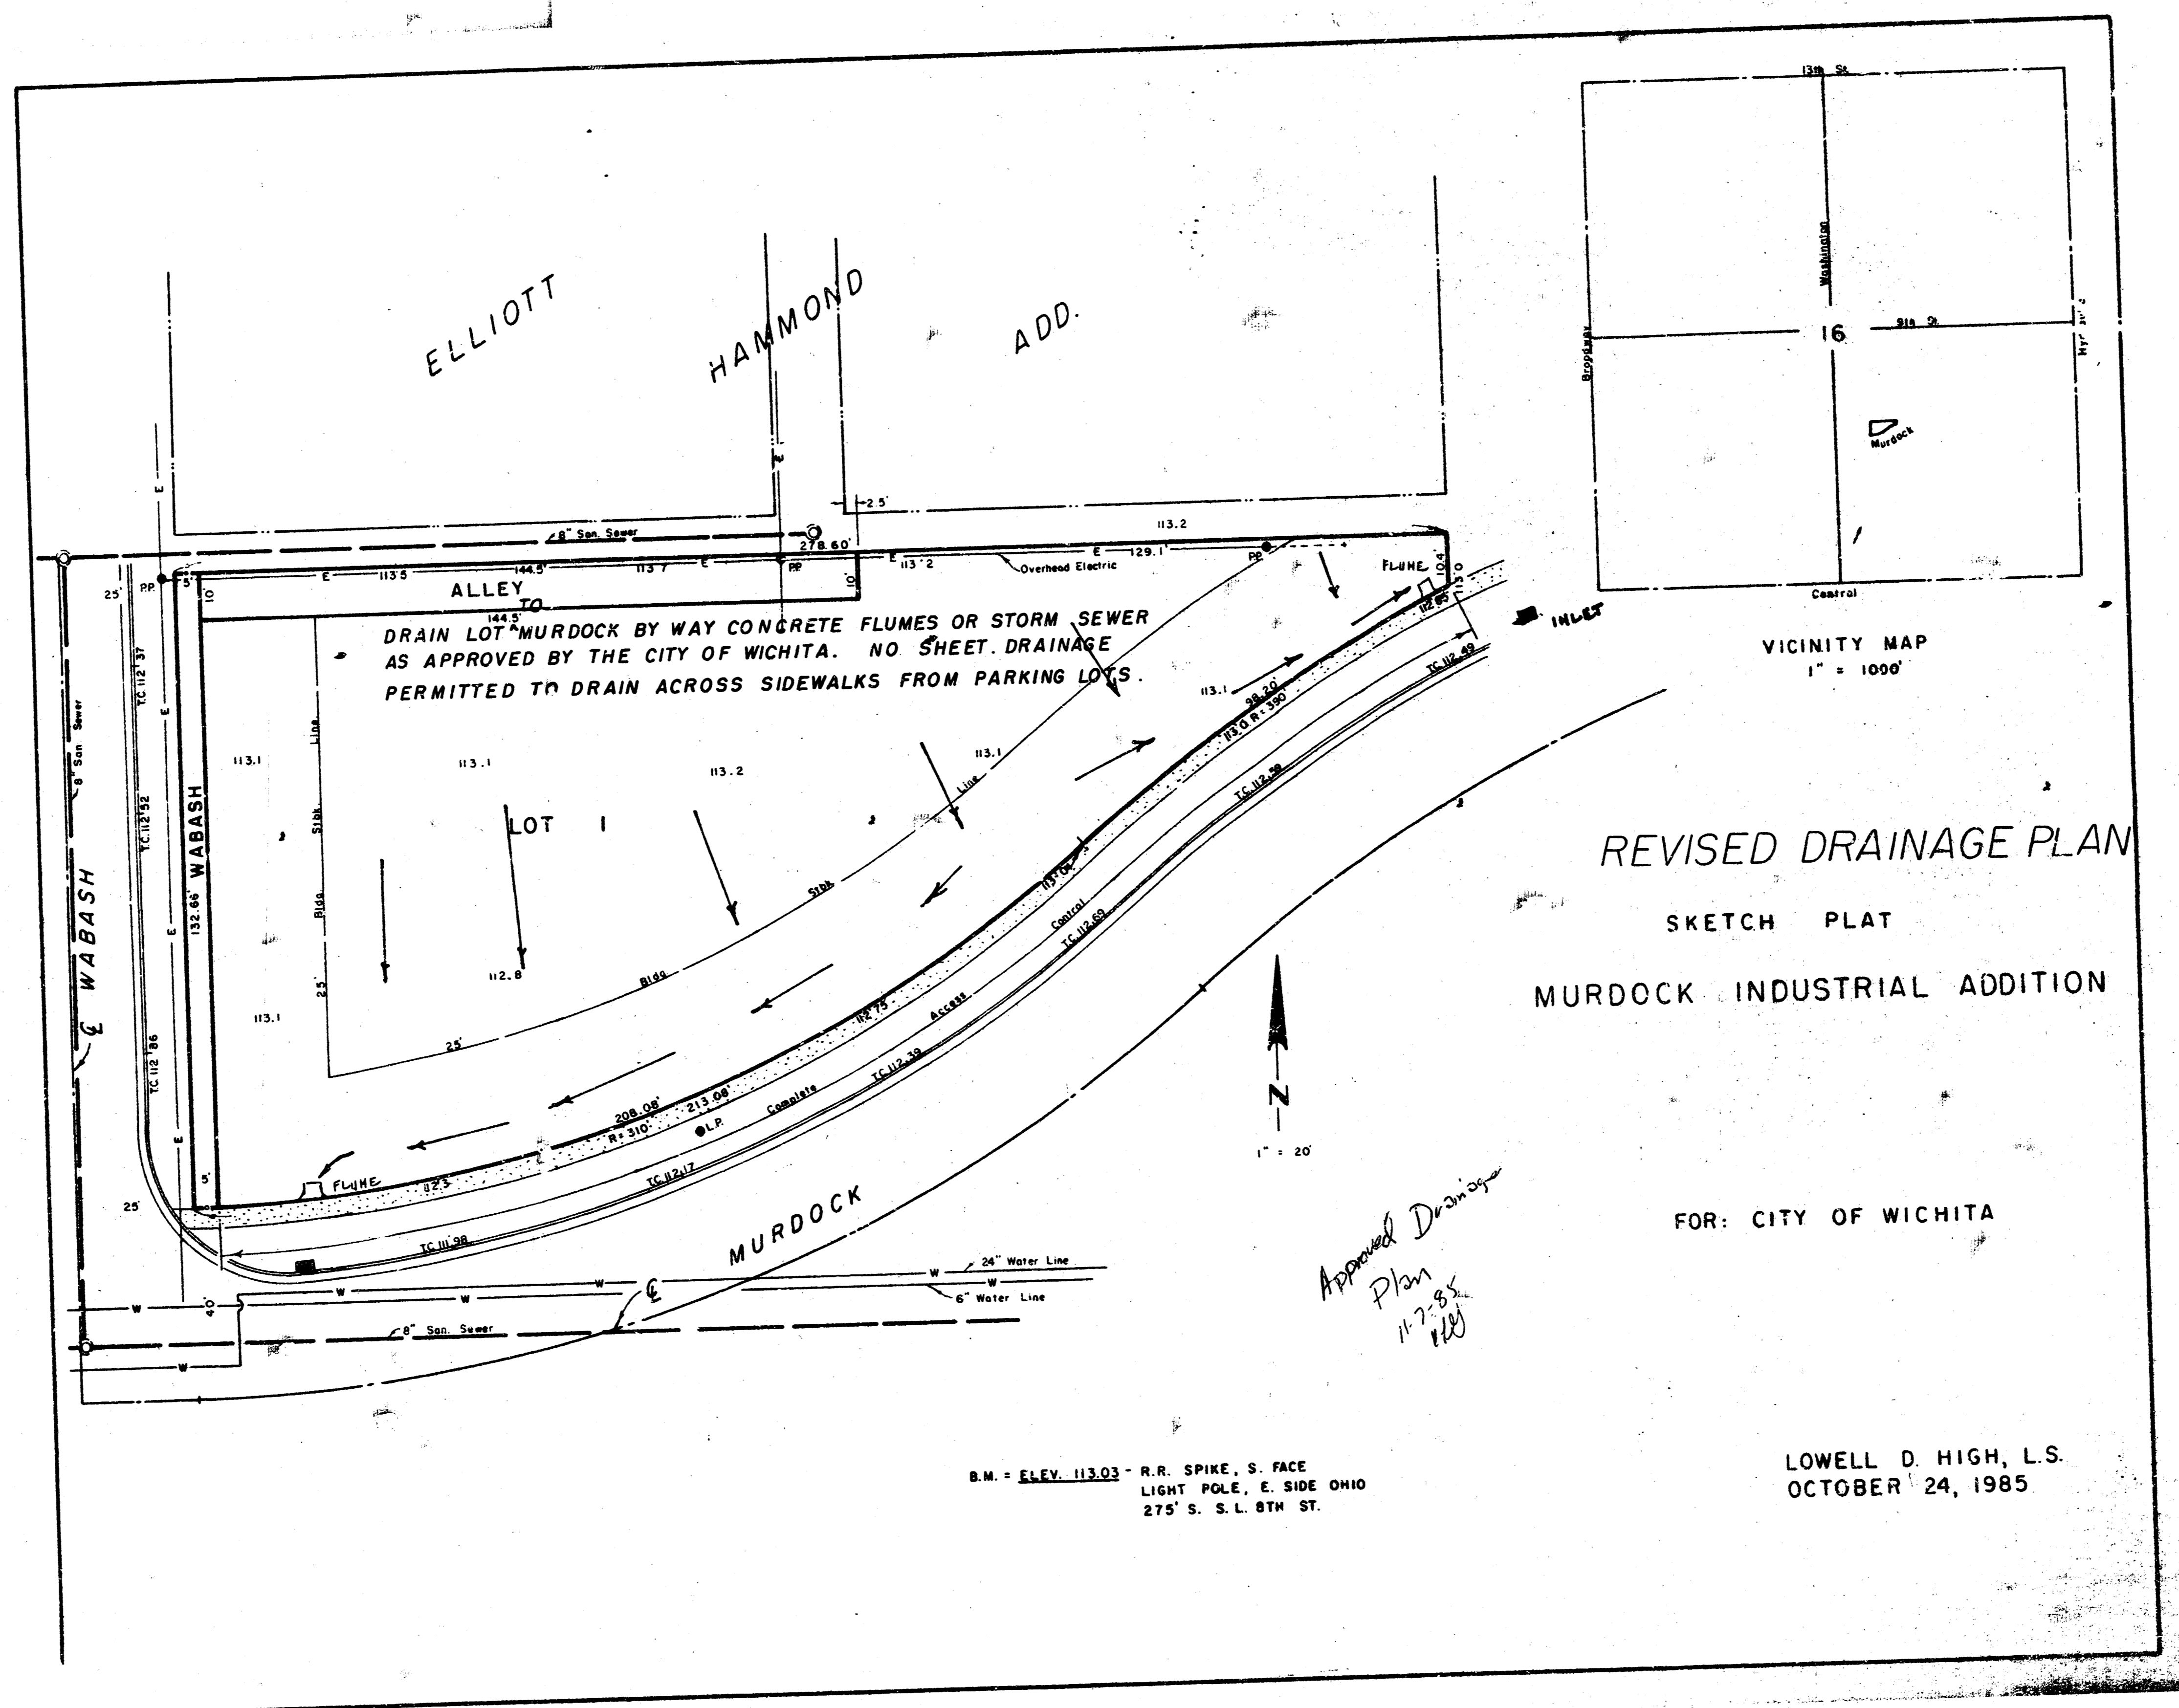

ELLIOTT
HAMMOND
ADD.

DRAIN LOT MURDOCK BY WAY CONCRETE FLUMES OR STORM SEWER
AS APPROVED BY THE CITY OF WICHITA. NO SHEET DRAINAGE
PERMITTED TO DRAIN ACROSS SIDEWALKS FROM PARKING LOTS.

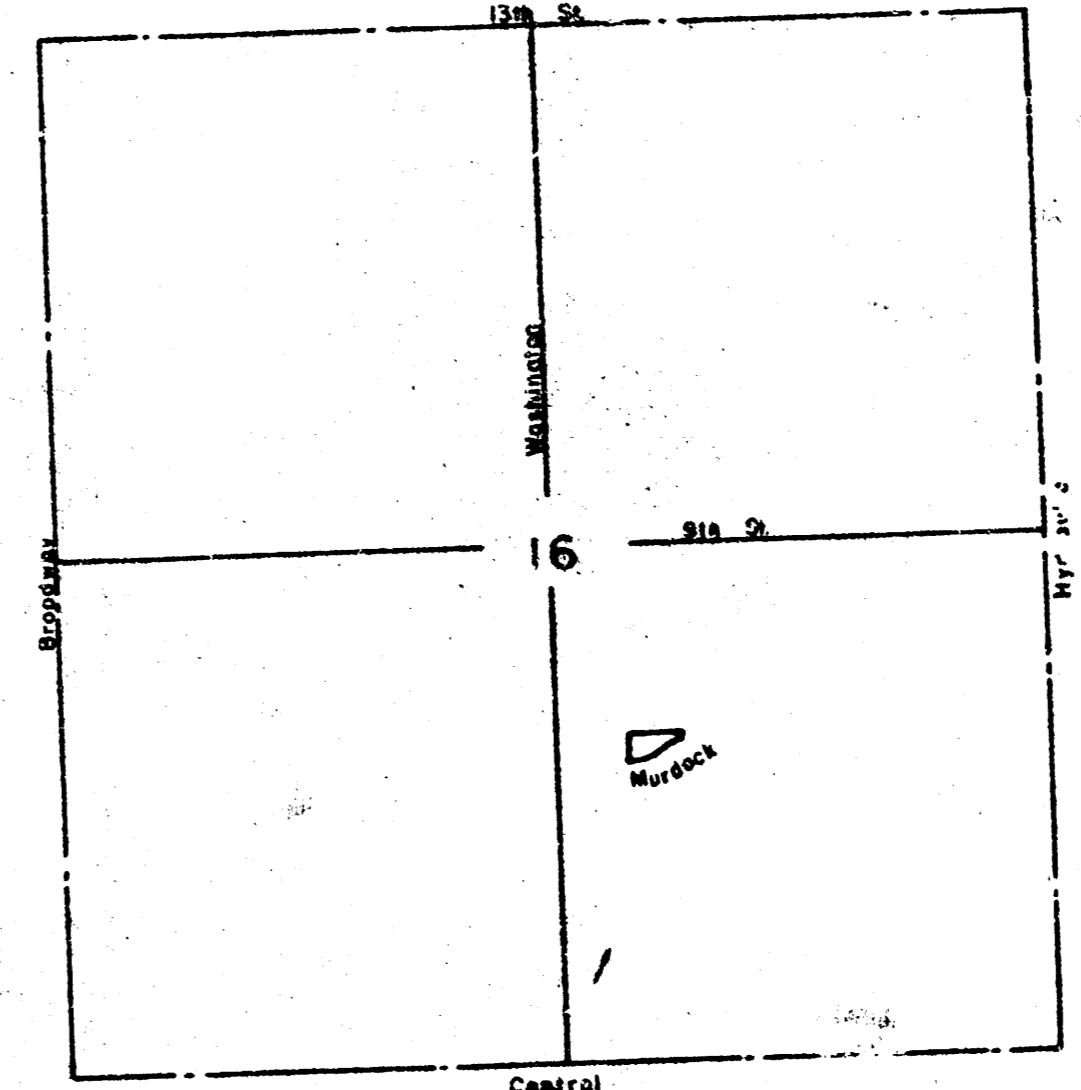

VICINITY MAP
1" = 1000'

REVISED DRAINAGE PLAN
SKETCH PLAT
MURDOCK INDUSTRIAL ADDITION

FOR: CITY OF WICHITA

B.M. = ELEV. 113.03 - R.R. SPIKE, S. FACE
LIGHT POLE, E. SIDE OHIO
275' S. S. L. 8TH ST.

LOWELL D. HIGH, L.S.
OCTOBER 24, 1985.

*Approved Drainage
Plan
11-2-85
L.D.H.*