MURDOCK INDUSTRIAL ADDITION
(Drainage)

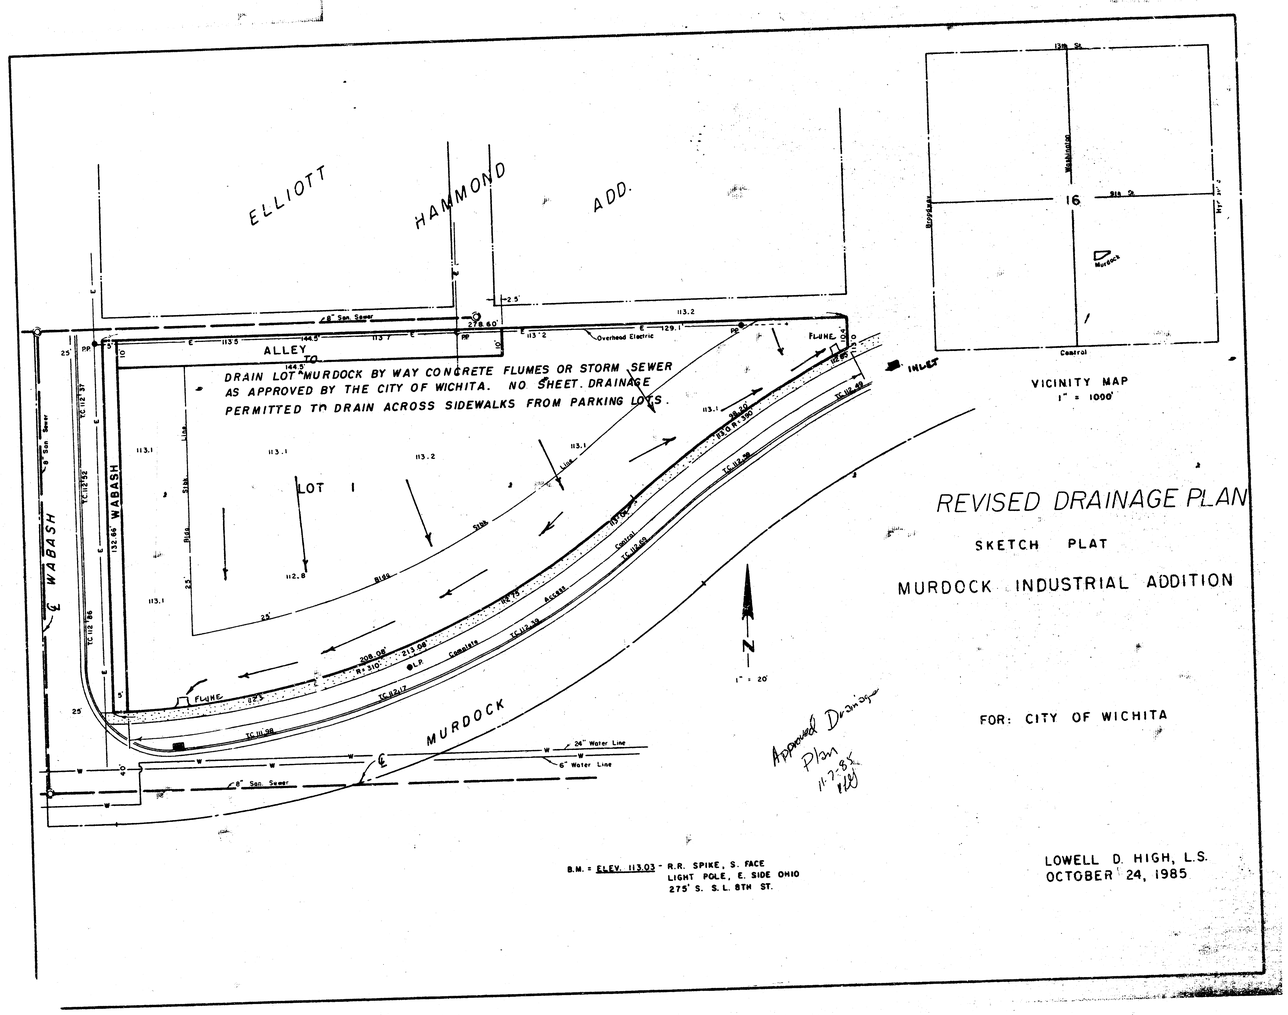

REVISED DRAINAGE PLAN

SKETCH PLAT

MURDOCK INDUSTRIAL ADDITION

FOR: CITY OF WICHITA

Approved Drainage Plan
11-7-85
HCW

B.M. = ELEV. 113.03 - R.R. SPIKE, S. FACE
LIGHT POLE, E. SIDE OHIO
275' S. S.L. 8TH ST.

LOWELL D. HIGH, L.S.
OCTOBER 24, 1985